### ABERDEEN MIDDLE SCHOOL HVAC SYSTEMIC RENOVATION

# ADDENDUM NO. 4

- DATE: March 27, 2024
- ENGINEER: Gipe Associates 1220 East Joppa Road, Suite 223 Baltimore, Maryland 21286 Phone: (410) 832-2420
- OWNER: Harford County Public Schools
- PROJECT: Aberdeen Middle School HVAC Systemic Renovation 111 Mt. Royal Avenue Aberdeen, Maryland 21001 Gipe Project No. 23043
- TO: All Prospective Bidders

The following revisions and responses to questions are made to the original bid documents, dated February 26, 2024. This addendum forms a part of the Contract Documents and modifies the Original Solicitation Documents accordingly and as noted below. Acknowledge receipt of this Addendum in the space provided on the "Addenda" form within the Form of Proposal.

## A. CHANGES TO SPECIFICATIONS

- 1. 00 03 00 FORM OF PROPOSAL See attached revised FORM OF PROPOSAL.
- 01 21 00 ALLOWANCES Paragraph 3.3: Add the following:
   C. Allowance No.3: \$250,000.00. Work associated with technology systems.

### B. CHANGES TO DRAWINGS

- 1. All Civil Drawings. Remove the words "NOT FOR CONSTRUCTION".
- 2. **M203** LOWER LEVEL AREA E NEW WORK See attached revised drawing.
- 3. **M303** ENLARGED EQUIPMENT ROOM NEW WORK See attached revised drawing.
- 4. **M705** DETAILS See attached revised drawing.
- 5. **ES001** ELECTRICAL SITE PLAN

Add General Note 4 to read: "Provide surge protection on all low voltage cabling entering Modular Classrooms."

6. **E001** – LOWER LEVEL ELECTRICAL PHASING PLAN

Add "Replace Panels ELP-L1 and ERP-R1 during phase 1 as required to power new emergency lighting and fire alarm system" note to Activity Equipment Storage Rm S-19 in Phase 9 Area.

7. E002 – LOWER LEVEL ELECTRICAL PHASING PLAN

Add "Replace Panels ELP-U1 and ERP-U1 during phase 1 as required to power new emergency lighting and fire alarm system" note to Storage Rm S-34 in Phase 5 Area.

8. E101 THROUGH E110 – DEMOLITION DRAWINGS Revise Drawing Note 4 to read: "Remove and reinstall ceiling mounted devices, wireless access points, motion sensors, cameras, etc. As required for installation of hvac equipment. The general scope of ceiling work is indicated. Contractor is responsible for removal and relocation of additional devices not indicated as required for installation of electrical work."

Add Drawing Note 16 to read: "Remove all existing PA speakers and provide new with wiring to new headend (furnished by owner.)"

Add Drawing Note 17 to read: "Remove all existing overhead projectors and associated wall mounted whiteboards in same room (between local surface mounted speakers). Owner has right of first refusal. Dispose of any not retained by HCPS."

Revise Drawing Note callout "RR PA Speaker (Typ)" to "RX PA Speaker (Typ)."

Revise Drawing Note callout "RR Clg Mtd Projector and Conduit with Associated A/V Wiring (Typ)" to "Remove Clg Mtd Projector and conduit and associated wall mounted whiteboard located between wall mounted local speakers."

Revise Drawing Note callout "RR duplex receptacle flush mounted in ceiling for projector (typ)" to "RX duplex receptacle flush mounted in ceiling. Maintain circuit for extension to new receptacle."

9. E101, E102, E103, E105, E106, E107, E109 – DEMOLITION DRAWINGS Revise Drawing Note callout "RR PA Speaker (Typ)" to "RX PA Speaker (Typ)."

Revise Drawing Note callout "RR Clg Mtd Projector and Conduit with Associated A/V Wiring (Typ)" to "Remove Clg Mtd Projector and conduit and associated wall mounted whiteboard located between wall mounted local speakers."

Revise Drawing Note callout "RR duplex receptacle flush mounted in ceiling for projector (typ)" to "RX duplex receptacle flush mounted in ceiling. Maintain circuit for extension to new receptacle."

10. E301, E302, E304, E305, E306, E307, E308, E309, E310- POWER DRAWINGS

Provide new projector high (with duplex receptacle) and projector low drops as indicated on attached drawing. Field coordinate exact location of projector low drops with owner.

Provide PA speakers as indicated on attached drawing.

E303 – LOWER LEVEL AREA E – POWER
 Add Fan-5 in Air Handling Unit Room between columns AN and AO and 19 and 20, with associated combination starter located on exterior wall.

Provide new projector high (with duplex receptacle) and projector low drops as indicated on attached drawing. Field coordinate exact location of projector low drops with owner.

Provide PA speakers as indicated on attached drawing.

- 12. E312 ELECTRICAL PART PLANS Add Fan-4 in Mechanical Room – Base Bid – between Pump-7 and exterior wall, with associated combination starter located adjacent to Pump-7 VDF. Add Fan-4 in Mechanical Room – Alternate No. 1 – at same location.
- 13. **E501** PARTIAL SCHEMATIC POWER RISER DIAGRAMS

Revise EX Switchboard SWBD (Modified) FDR 8 to "WSHPS 1&2, 3P-800A-CB, 2 sets (3-500kcmil+#1/0GW-3"C." and FDR 7 to "WSHPS 3, 3P-500A-CB, 1 set (3-500kcmil+#2GW-3"C."

Add General Note 9 to read: "Provide Transformer Primary disconnects, where indicated, sized to match (or exceed) the rating of the primary CB indicated on the Dry Type Transformer Schedule."

Add General Note 10 to read: "Transformer Primary ECB's shall be rated 42kAIC UON. Transformer Primary Disconnects shall have 42kA withstand rating UON."

Revise Drawing Note 2 to read "Provide 3P-100A (480V) contacor with 24 coil in Nema 1 enclosure for panelboard. Make connection to Building Management System for On/Off controls."

Add Drawing Note 4 to read: "Provide wiretrough, sized as required." Apply to "boxes" fed from Xfmr T5, and serving Panel LP-L1 on Partial Schematic Power Riser Diagram – New Work.

Revise Dry Type Transformer Schedule, Tranformer T10 from 30kVA to 45kVA with 3#1+#8GW- 1 <sup>1</sup>/<sub>4</sub>"C. primary wiring, 90A primary CB, 4#1/0+#6GW-2"C secondary wiring with 150A secondary CB, #6 case neutral and ground.

Revise Partial Schematic Power Riser Diagram – New Work connection to Panel CLP from contactor as indicated to Panel DP-L1.

Revise Partial Schematic Power Riser Diagram – New Work connection to Transformer T10 from Panel DPM to panel MP.

Add Partial Schematic Power Riser Diagram – New Work a pullbox and splice at DPM feeder to Temporary connection to EX MCC, remove at end of project.

Add Partial Schematic Power Riser Diagram – New Work a 3P-30A shunt trip fused safety switch with (1) N.O. and (1) N.C. auxiliary contacts, fused per manufacturer's nameplate data for elevator motor. Switch shall be equipped with latching mechanism capable of being locked in the open position.

14. E502 – FIRE ALARM RISER DIAGRAMS Revise "120V" from elevator smoke detector on Schematic Fire Alarm Riser Diagram to "ERP-L1-13."

Revise "120V" from NAC on Schematic Fire Alarm Riser Diagram to "ERP-U1-13,15,17."

Add homerun from circuits ERP-L1-15,17 to FACP on Schematic Fire Alarm Riser Diagram.

Add connection between FACP and FAAP on Schematic Fire Alarm Riser Diagram.

Revise Drawing Note 12 to read: "Provide monitoring of fire alarm system in modulars, (1 combination speaker/strobe (75cd) per room and 4 pull stations each) to send alarm signal to UL Listed Central Station and provide supervisory notification at building."

- 15. E602 SCHEDULES Revise per attached Drawing.
- 16. E603 SCHEDULES Revise Panel MP-U1 circuit 7 to 15A circuit breaker.

Revise Panel LP-L1 circuits 20,22 and 24 from spares to 3P-30A-CB with 4#6+#8GW-1"C for SPD.

Revise Panel LP-U1 circuits 28,30 and 32 from spares to 3P-30A-CB with 4#6+#8GW-1"C for SPD.

Revise Panel LP-L1A circuits 37, 39 and 41 from spares to 3P-30A-CB with 4#6+#8GW-1"C for SPD.

17. E604 – SCHEDULES Revise Panel LP-U2 circuits 25, 27 and 29 from spares to 3P-30A-CB with 4#6+#8GW-1"C for SPD.

Revise Panel LP-L2 circuit 28 wiring to read "Refer to XFMR Schedule."

18. E605 – SCHEDULES Revise Panel LP-L3 bus description to "100% rated Neutral Bus/Sub-feed Lugs."

Revise Panel LP-L3 circuits 37, 39 and 41 from spares to 3P-30A-CB with 4#6+#8GW-1"C for SPD.

Revise Panel LP-L3 circuit 38 description to "Transformer T3" and wiring to read "Refer to XFMR Schedule."

Revise Panel ELP-L1 bus description to "100% rated Neutral Bus/Sub-feed Lugs."

Revise each section of Panel RP-L3 from 42 poles to 60 poles with 1 pole spaces, except circuits 116, 118 and 120 to 3P-30A-CB with 4#6+#8GW-3/4"C for

SPD.

Revise Panel DP-L1 circuits 8, 10 and 12 to 3P-50A-CB with 4#6+#10GW-3/4"C for Panel CLP.

Revise Fusible Panel ERP-R1 circuits 13, 15 and 17 to "FACP" with 2#12+#12GW-3/4"C.

- 19. E606 SCHEDULES Revise Panel LP-U3 circuits 25, 27 and 29 from spares to 3P-30A-CB with 4#6+#8GW-1"C for SPD.
- 20. E606 SCHEDULES Revise Panel LP-U4 circuits 26, 28 and 30 from spares to 3P-30A-CB with 4#6+#8GW-3/4"C for SPD.

Revise Fusible Panel ERP-U1 circuits 8, 10 and 12 to FACP with 2#12+#12GW-3/4"C.

Revise Fusible Panel ERP-U1 circuit 7 description to "DAS."

Revise Fusible Panel ERP-U1 main to 60A.

21. E610 - SCHEDULES

Add Fan-4 to Mechanical Equipment Connection Schedule, 1 ½ HP, 480V, 3 Phase, Circuit MP-43, Nema 0 starter with 3P-30A-F/ss (f@15A) in Nema 1 enclosure, note 3.

Add Fan-5 to Mechanical Equipment Connection Schedule, 1  $\frac{1}{2}$  HP, 480V, 3 Phase, Circuit MP-43, Nema 0 starter with 3P-30A-F/ss (f@15A) in Nema 1 enclosure, note 3.

Revise WWSHP-3 on Mechanical Equipment Connection Schedule – Add Alternate #1 circuit to SWBD-7. Revise Amps from "(3)60" to "360." Delete Note 12 reference.

22. E702 – DETAILS Add projector high and low details per attached sheet.

### C. RFI QUESTIONS, ANSWERS AND CLARIFICATIONS

1. Panel LP-L3 and LP-U4 are shown on panel schedule feed off same breaker in SWBD. However Riser shows LP-U4 is feed from LP-L3. Same for LP-L2 and LP-U2. Are they doing a feeder tap that is not shown.

Provide feed-thru or sub-feed lugs as indicated on panel schedules. Refer to Addendum.

- On drawing MS001, at Geothermal Circuit No.1, a Test Well is referenced. Does this mean a Test Well has been conducted for this design and won't need to be drilled again, or is this to be drilled as part of the construction for this project.
   The test well has not been drilled and will be drilled under a separate contract.
- 3. There is a design issue with the 8" water main that is a part of the base bid. Sheet C321 profile 2 shows the EX 24" SD at INV 84.33 (coming in from the northeast), 25' to the northeast the

proposed 8" water crosses the EX 24" SD. The water profile 3 on sheet C302 shows inv elevations 85.34 - 85.1 at stations 2+41 to 2+95, which would be going right through the middle of the EX 24" SD that isn't shown on the profiles like the other existing utilities. Will there be an updated design for this 8" water. See this addendum for additional information.

- 4. Is the owner or contractor connecting the new PA speakers to the existing system? The contractor shall supply the PA speakers and wiring to the new headend system to be furnished by the owner. See this addendum.
- 5. What manufacture/vendor is the existing PA system? The existing PA system is Rauland. A new PA system head-end will be furnished by the owner. See this addendum.
- 6. Is the owner or contractor supplying the peer less ceiling plate for the projectors? There are no peerless ceiling plates. We are doing wall mounted short throw projectors. All whiteboard areas need blocking.
- 7. Per the specs, the fire alarm system for the modular classrooms is to be a standalone system as mentioned in the pre-bid, however drawing ES001 shows it tying into the existing panel. Please confirm if this is standalone or not. The modular classrooms shall have standalone system with monitoring of this from the new fire alarm system for UL Central Station notification, and supervisory alarm on building system only.
- 8. Is the owner or contractor supplying the CCTV camaras for the temporary modular classrooms? The owner is providing the equipment, the contractor is to provide the infrastructure, including cabling.
- Is the owner or contractor supplying the security system for the temporary modular classrooms? The owner is providing the equipment, the contractor is to provide the infrastructure, including cabling.
- 10. WSHPS 1-3 are shown with a 1200 amp feeder coming from Main switchboard. However the three WSHP units are only 60 amp. How do we feed the 3 60 amp circuits with a 1200 amp feeder? **Ampacity per WSHPS are 360A each. Refer to this Addendum for revised connection.**
- 11. In base bid does the feeder to the chillers get replaced or reused? The feeders are indicated to be replaced on E501 under base bid.

### D. ATTACHMENTS

- 1. 00 03 00 FORM OF PROPOSAL
- 2. 23 06 00 paragraphs 2.18 and 3.23
- 3. Civil Drawings C111, C121, C301, C302, C401, C411, C412.
- 4. Mechanical Drawings M203, M303, M705.
- 5. Electrical Drawings E301, E302, E303, E304, E305, E306, E307, E308, E309, E310, E602, E702.

# ABERDEEN MIDDLE SCHOOL HVAC SYSTEMIC RENOVATION

## END OF ADDENDUM NO. 4

## SECTION 00 03 00 - FORM OF PROPOSAL

Proposal of: \_\_\_\_\_

(firm name)

Re: Aberdeen Middle School HVAC Systemic Renovations Location: 111 Mt. Royal Ave., Aberdeen, MD 21001

Date: \_\_\_\_\_

To: Board of Education of Harford County Harford County Public Schools 2209 Conowingo Rd. Bel Air, Maryland 21015

Gentlemen

Having examined the Instruction to Bidders, the Drawings and the Specification, including Addenda Nos. \_\_\_\_\_, \_\_\_\_, \_\_\_\_, \_\_\_\_, \_\_\_\_, and \_\_\_\_\_, thereto, and other proposed Contract Documents prepared by Gipe Associates, Inc. and having examined the site and other conditions affecting the construction, the undersigned hereby proposes to furnish all labor, materials, equipment and services to perform all work required for the Aberdeen Middle School HVAC Systemic Renovations at Aberdeen Middle School in strict accordance with the Contract Documents for the sums listed in the following bid items:

It is understood that if no figure is listed for an Alternate, that the Alternate may be accepted and there shall be no change in the Base Bid amount indicated below:

1. BASE BID:

The Lump Sum Base Bid for the site work, ceilings, mechanical, electrical, fire protection, plumbing, fire alarm, lighting, and controls associated with the project including the prevailing wage scale.

Base Bid Work, Dollars (\$

# 2. ALLOWANCES:

Bidder shall include allowance amount in BASE BID. Allowances conform to applicable project specification section.

Allowance No.1: \$200,000.00. Miscellaneous existing wiring laying on existing ceiling shall be attached

).

to the existing structure.

Allowance No.2: \_\_\_\_\_\_. Work associated with the PV relocation by the PV contractor in accordance with the Solar Power Purchase Agreement.

Allowance No.3: **\$250,000.00**. Work associated with Technology components.

### 3. ALTERNATE NO.1

The Lump Sum Bid for the Alternate No.1 site work, mechanical, electrical, plumbing and associated automatic temperature controls with the project including the prevailing wage scale.

Alternate No.1 Work, Dollars (\$

### 4. ALTERNATE NO.2

The Lump Sum Bid for the Alternate No.2, laminate associated with architectural with the project including the prevailing wage scale.

<u>Alternate No.2 Work,</u> Dollars (\$

## 5. ALTERNATE NO.3

The Lump Sum Bid for the Alternate No.3, window sill cladding associated with architectural with the project including the prevailing wage scale.

Alternate No.3 Work, Dollars (\$

### 6. ALTERNATE NO.4

The Lump Sum Bid for the Alternate No.4, Fire Protection Mains, four new sprinkler zones with vertical alarm check assemblies including the prevailing wage scale.

Alternate No.4 Work, Dollars (\$

### 7. ALTERNATE NO.5

The Lump Sum Bid for the Alternate No.5, New Additional Water Service piping, fire hydrants, required site work and restoration of existing surfaces including the prevailing wage scale.

<u>Alternate No.5 Work,</u> Dollars (\$

).

).

### SUBSTITUTIONS REQUESTS:

Indicate proposed substitutions below and attach copies of "Substitution Request Form" referenced in Section 01 06 00A.

Proposed Substitution	Price Change
	\$ 
	\$

### EXECUTION:

The undersigned affirms that the Base Bid stated above represents the entire cost of the Project in accordance with the Bid Documents and that no claim shall be made on account of any increase in wage, scales, material prices, taxes, insurance, cost indexes, or any other rate affecting the construction industry and/or this project.

The undersigned agrees, upon receipt of written notice of the acceptance of this bid within (60) calendar days after the date of opening of bids to execute the standard form of contract in accordance with the bid as accepted, and to give performance and payment bond with good and sufficient surety or sureties, for the faithful performance of the contract and for the protection of all persons supplying labor and materials in the prosecution of the work, within ten (10) calendar days after the prescribed forms are presented for signature.

Signature of:

Name and Title (printed)

Registered Maryland Contractor No.
OR
X
Officer if bidder is a corporation
Name and Title (printed)
Registered Maryland Contractor No.
ALL
Subscribed and sworn before me this day of, 20
X
Notary Public
My Commission expires:

- NOTE: The following items shall be completed and submitted as attachments to the Bid at the time of the Bid opening:
  - \*□1. Section 00 05 00 Bid Bond
  - \*□2. Section 00 06 60 MBE Attachment D-1A; MBE Utilization and Fair Solicitation Affidavit and MBE Participation Schedule
  - □3. Section 00 06 30 Affidavit of Qualification to Bid

# \*NOTE: Item 1 must be submitted in proper form and content at the time of bid opening or the bid will be rejected as non-responsive.

### **END OF SECTION**

# 2.18. MODULAR HEAT PUMP UNITS

# A. OPERATING CONDITIONS

- 1. Provide water-to-water heat pump with the capacity as schedule on drawings.
- 2. Heat Pump shall be designed to operate using R-410A or R-134a Refrigerant.
- 3. Heat Pump shall be designed for parallel evaporator water flow.

# B. WATER-TO-WATER PACKAGE HEAT PUMP

- 1. Provide water-to-water heat pump as manufactured by MULTISTACK. Model MR or approved equal by ClimaCool.
- 2. System Description: Heat Pump shall incorporate Scroll-type compressors and consist of multiple refrigerant circuits. Each refrigerant circuit shall consist of an individual compressor, condenser, evaporator circuit, thermal expansion valve, reversing valve, and control system. Each circuit shall be constructed to be independent of other circuits from a refrigeration and electrical stand-point. The multi-circuit heat pump must be able to produce chilled water even in the event of a failure of one or more refrigerant circuits. Circuits shall not contain more than 20 lb. of R-410A refrigerant.
- 3. General
  - a. Heat Pump Modules shall be ETL listed in accordance with UL Standard 1995, CSA certified per Standard C22.2#236, and bear the ASME UM stamp on all heat exchangers (not applicable for modules with R-410A refrigerant).
  - b. Modules shall ship wired and charged with refrigerant. All modules shall be factory run tested prior to shipment.
  - c. Compressors, heat exchangers, piping and controls shall be mounted on a heavy gauge steel frame. Electrical controls, contractors, and relays for each module shall be mounted with that module.
- 4. Water Mains: Each module shall include supply and return mains for both load and source-sink water. Grooved end connections are provided for interconnection to six-inch standard piping with grooved type couplings.
- 5. Heat Exchangers: Each load and source-sink heat exchanger shall be brazed plate heat exchangers constructed of 316 stainless steel; designed, tested and stamped in accordance with UL code 1995 for 650 psig working pressure on load and source-sink heat exchangers. Heat exchangers shall be mounted below the compressor, to eliminate the effect of migration of refrigerant to the cold evaporator with consequent liquid slugging on start-up.

- 6. Compressor: Each module shall contain two hermetic scroll compressors independently circuited and with internal spring isolation mounted to the module with rubber-in-shear isolators. Each system also includes high discharge pressure and low suction pressure manual reset safety cut-outs.
- 7. Central Control System
  - a. Scheduling of the various compressors shall be performed by a microprocessor based control system (Master Controller). A new lead compressor is selected every 24 hours to assure even distribution of compressor run time.
  - b. The Master Controller shall monitor and report the following on each refrigeration system:
    - 1) Discharge Pressure Fault
    - 2) Suction Pressure Fault
    - 3) Compressor Winding Temperature
    - 4) Suction Temperature
    - 5) Load Leaving Water Temp.
    - 6) Source-Sink Leaving Water Temp.
  - c. The Master Controller shall monitor and report the following on each refrigeration system:
    - 1) Load Water Entering and Leaving Temperature
    - 2) Source-Sink Water Entering and Leaving Temperature
    - 3) Load Water and Source-Sink Water Flow
  - d. An out of tolerance indication from these controls or sensors shall cause a "fault" indication at the Master Controller and shutdown of that compressor with the transfer of load requirements to the next available compressor. In the case of a System Fault the entire heat pump will be shut down. When a fault occurs, the Master Controller shall record conditions at the time of the fault and store the data for recall. This information shall be capable of being recalled through the keypad of the Master Controller and displayed on the Master Controller's semigraphical display. A history of faults shall be maintained including date and time of day of each fault (up to the last 20 occurrences).
  - e. Individual monitoring of leaving water temperature from each refrigeration system shall be programmed to protect against heat exchanger freeze-up.
  - f. The control system shall monitor entering and leaving water temperature to determine system load and select the number of compressor circuits required to operate. Response times and set points shall be adjustable. The system shall provide for variable time between compressor sequencing and temperature sensing, so as to fine tune the heat pump to different existing building conditions.

- g. Optionally, the Heat Pump shall be capable of interfacing with the Building Automation System via an Interoperability Web Portal.
- h. The heat pump mode (heating and cooling) shall be selected by an external dry contact interlock to the Master Controller. If no interlock is present, or in the event of a reversing valve solenoid failure, the system shall revert to heating mode.
- 8. Heat Pump shall have a single point power connection and external inputs and outputs to be compatible with the building management system. Inputs/Outputs include:
  - a. Remote Start/Stop
  - b. Cooling Alarm
- 9. Each inlet water header shall incorporate a built in 30-mesh in-line strainer system to prevent heat exchanger fouling.

# C. SAFETIES, CONTROLS AND OPERATOIN

- 1. Heat Pump safety controls system shall be provided with the unit (minimum) as follows:
  - a. Low refrigerant pressure
  - b. Loss of flow through the source/sink heat exchanger
  - c. Loss of flow through the load heat exchangers
  - d. High refrigerant pressure
  - e. High compressor motor temperature
  - f. Low suction gas temperature
  - g. Low leaving water temperature
- 2. Failure of heat pump to start or heat pump shutdown due to any of the above safety cutouts shall be enunciated by display of the appropriate diagnostic description at the unit control panel. This annunciation will be in plain English. Alphanumeric codes shall be unacceptable.
- 3. The heat pump shall be furnished with a Master Controller as an integral portion of the heat pump control circuitry to provide the following functions:
  - a. Provide automatic heat pump shutdown during periods when the load level decreases below the normal operating requirements of the heat pump. Upon an increase in load, the heat pump shall automatically restart.
  - b. Provisions for connection to automatically enable the heat pump from a remote energy management system.
  - c. The control panel shall provide alphanumeric display showing all system parameters in the English language with numeric data in English units.

- 4. Normal Heat Pump Operation
  - a. When heat pump is enabled, the factory supplied Master Controller modulates the heat pump capacity from minimum to maximum as required by building load.
  - b. The heat pump control system shall respond to Entering Water Temperature and will have an integral reset based on entering water temperature to provide for efficient operation at part-load conditions.
  - c. The operating mode (heating and cooling) shall be determined by a customer provided dry contact interlock.
- 5. Power Phase Monitor
  - a. Provide a Power Phase Monitor on the incoming power supply to the heat pump. This device shall prevent the heat pump from operating during periods when the incoming power is unsuitable for proper operation.
  - b. The Power Phase Monitor shall provide protection against the following conditions:
    - 1) Low Voltage (Brown-Out)
    - 2) Phase Rotation
    - 3) Loss of Phase
    - 4) Phase Imbalance

# PART 3. EXECUTION

### 3.23. INSTALLATION

### A. PIPING SYSTEM FLUSHING PROCEDURE


- 1. Prior to connection the heat pump to the condenser and chilled water loop, the piping loops shall be flushed with a detergent and hot water (110-130°F) mixture to remove previously accumulated dirt and other organic. In old piping systems with heavy encrustation of inorganic materials consult a water treatment specialist for proper passivation and/or removal of these contaminants.
- 2. During the flushing 30 mesh (max.) Y-strainers (or acceptable equivalent) shall be in place in the system piping and examined periodically as necessary to remove collected residue. The flushing process shall take no less than 6 hours or until the strainers when examined after each flushing are clean. Old systems with heavy encrustation shall be flushed for a minimum of 24 hours and may take as long as 48 hours before the filters run clean. Detergent and acid concentrations shall be used in strict accordance with the respective chemical manufacturer's instructions. After flushing with the detergent and/or dilute acid concentrations, the system loop shall be purged with clean water for at least one hour to ensure that all residual cleaning chemicals have been flushed out.

3. Prior to supplying water to the heat pump the Water Treatment Specification shall be consulted for requirements regarding the water quality during heat pump operation. The appropriate heat pump manufacturer's service literature shall be available to the operation and/or service contractor and consulted for guidelines concerning preventative maintenance and off-season shutdown procedures.


# B. WATER TREATMENT REQUIREMENTS

- 1. Supply water for both the chilled water and condenser water circuits shall be analyzed and treated by a professional water treatment specialist who is familiar with the operating conditions and materials of construction specified for the heat pump's heat exchangers, headers and associated piping. Cycles of concentration shall be controlled such that recirculated water quality for modular heat pumps using 316 stainless steel brazed plate heat exchangers and carbon steel headers is maintained within the following parameters:
  - a. pH Greater than 7 and less than 9
  - b. Total Dissolved Solids (TDS) Less than 100 ppm
  - c. Hardness as CaC0<sub>3</sub> 30 to 500 ppm
  - d. Alkalinity as CaC0<sub>3</sub> 30 to 500 ppm
  - e. Chlorides Less than 200 ppm
  - f. Sulfates Less than 200 ppm

# **END OF SECTION**

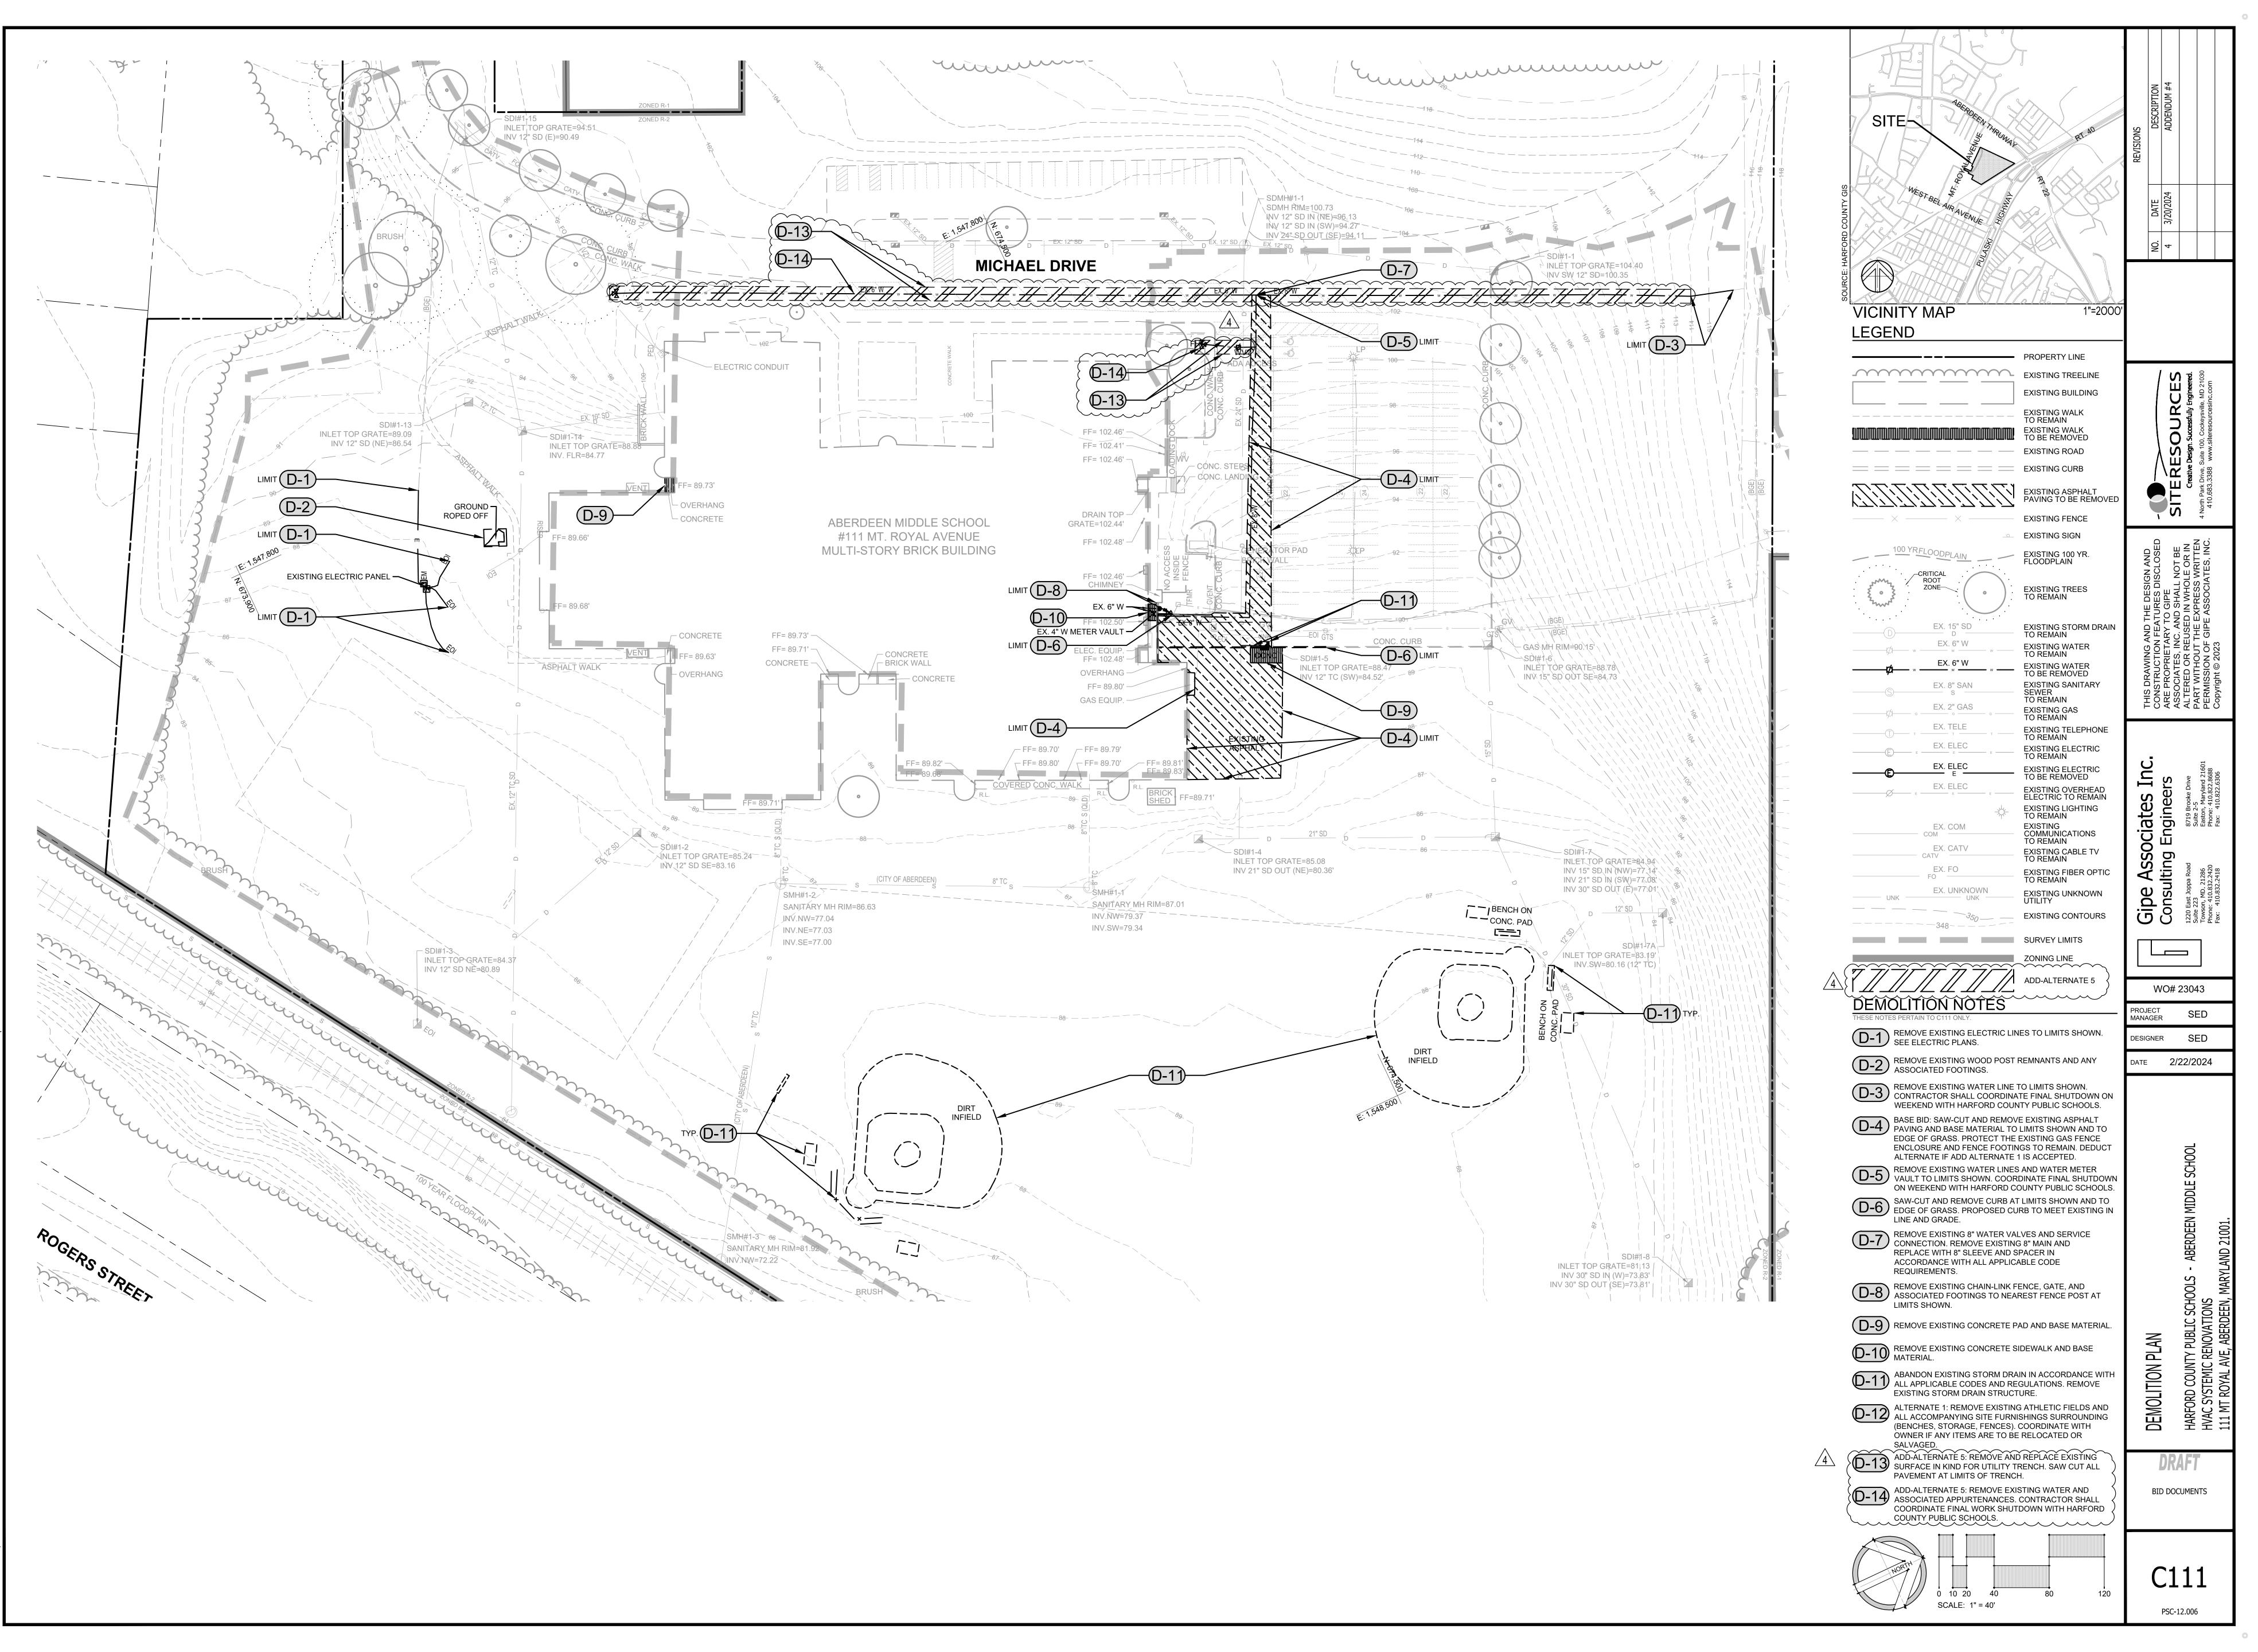

© SITE RESOURCES. INC. Z:/23/23032-HCPS ABERDEEN MS HVAC SYSTEMIC RENOVATIONS/04-DWG/C-111 - DEMOLITION PLAN.DWG 3/25/2024 2:38 PM

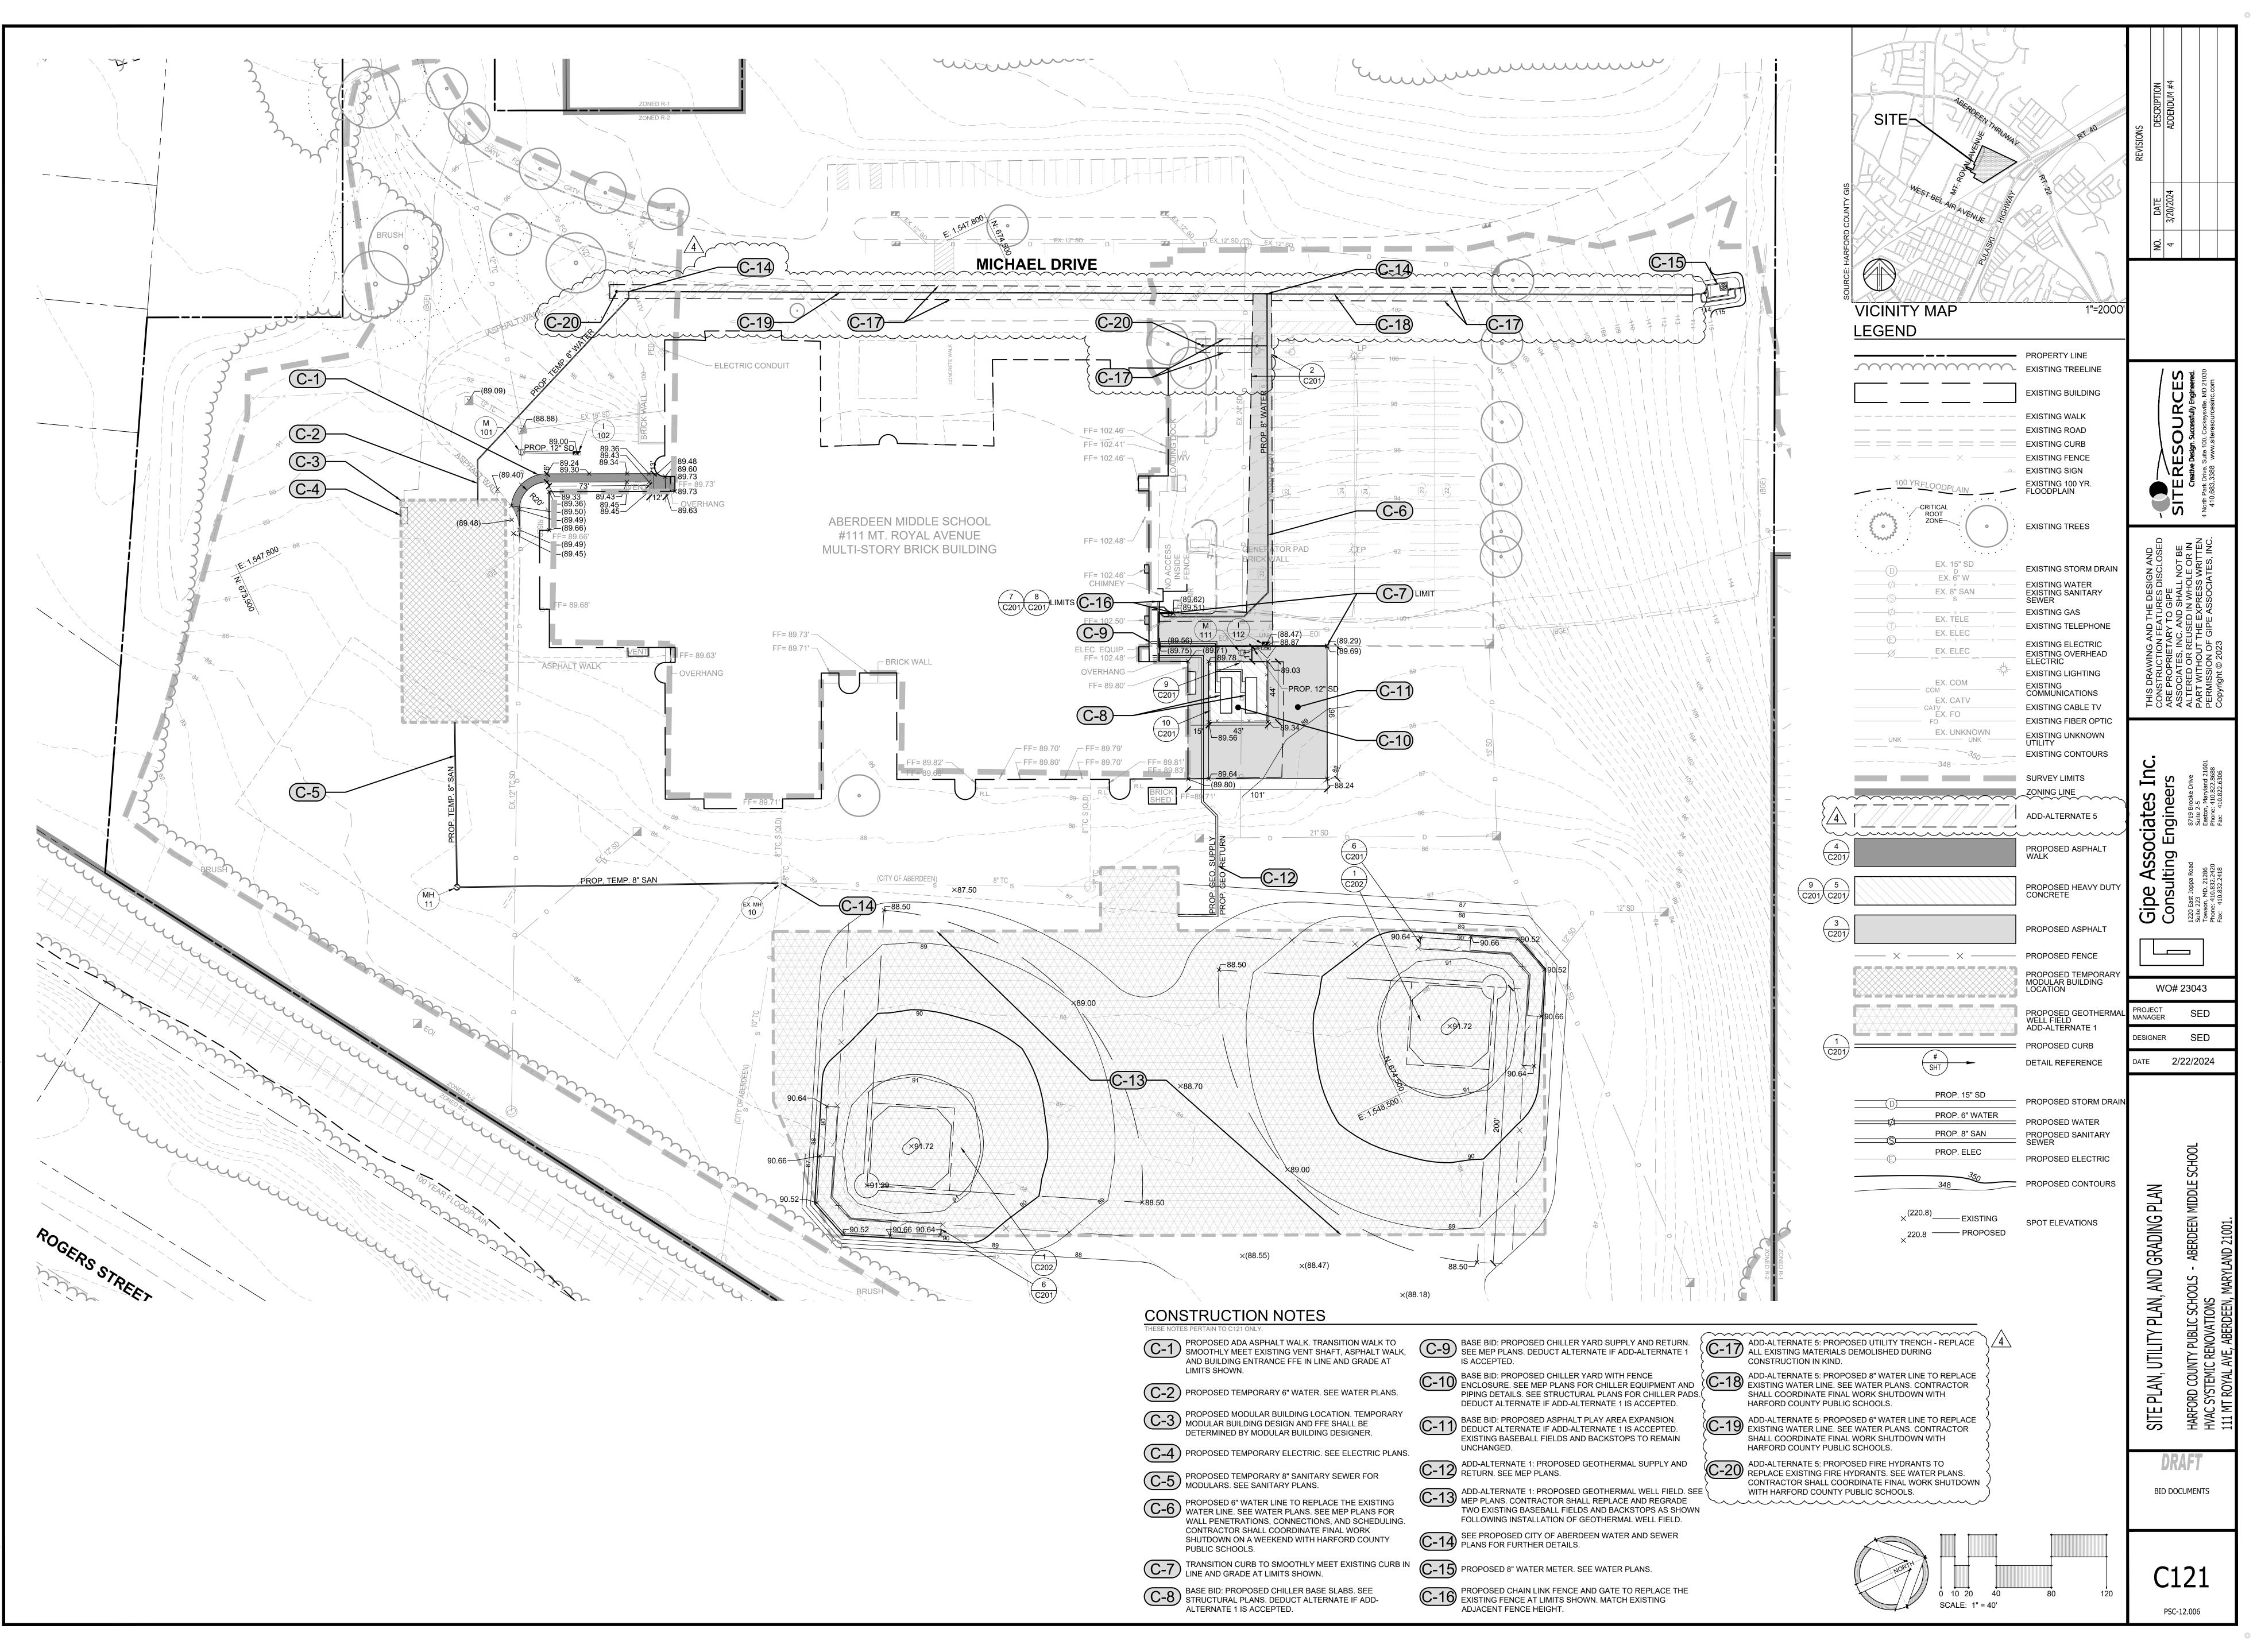

© SITE RESOURCES, INC. Z:\23\23032-HCPS ABERDEEN MS HVAC SYSTEMIC RENOVATIONS\04-DWG\C-121 - SITE PLAN.DWG 3\25\2024 2:38 PM


1.	
2.	CONTRACTER SHALL NOTIFY CITY OF ABERDEEN DEPARTMENT OF PUBLIC WORKS INSPECTOR AT (410) 272-1600 EXT. 224, 48 HOURS PRIOR TO CONSTRUCTION THE CONTRACTOR SHALL NOTIFY MISS UTILITY 1-800-257-7778 OR 811, 72 HOURS PRIOR TO
3.	CONSTRUCTION. EXISTING UTILITIES ARE SHOWN FOR THE CONVENIENCE OF THE CONTRACTOR, BUT THE
	COMPLETENESS OR ACCURACY OF THE SAME IS NOT GUARANTEED. ANY DISCREPANCY BETWEEN THE PLANS AND EXISTING CONDITIONS SHOULD BE REPORTED TO THE CITY OF ABERDEEN DEPARTMENT OF PUBLIC WORKS AND TO THE ENGINEER PRIOR TO CONSTRUCTION.
4.	THE CONTRACTOR SHALL VERIFY THE LOCATION AND DETERMINE THE ELEVATION OF EXISTING UTILITIES BEFORE TRENCH EXCAVATION BEGINS AND SHALL PROTECT SERVICE CONNECTIONS AND MAINTAIN THEIR UNINTERRUPTED SERVICE. ANY DAMAGES TO, MAINTENANCE, AND PROTECTION OF EXISTING UTILITIES AND STRUCTURES SHALL BE REPAIRED IMMEDIATELY. THE COST OF SUCH REPAIRS SHALL BE BORNE BY THE CONTRACTOR.
5.	CONTRACTOR SHALL NOTIFY CITY OF ABERDEEN DEPARTMENT OF PUBLIC WORKS ENGINEER AT (410) 272-1600 EXT. 222, ONE WEEK PRIOR TO ANY SHUTDOWN TO COORDINATE SERVICE
6.	OUTAGES. EXISTING SEWER MANHOLES, WHERE CONNECTIONS ARE MADE, ARE TO BE REHABILITATED OR REPLACED AS REQUIRED BY THE CITY OF ABERDEEN, INCLUDING SEWER BRICK CHANNELS
7.	AND BENCHES. WATER AND SEWER SERVICES WITHIN THE CITY RIGHT-OF-WAY/EASEMENTS SHALL BE IN ACCORDANCE WITH THE LATEST EDITION OF THE HARFORD COUNTY STANDARD SPECIFICATIONS AND DETAILS FOR WATER MAINS AND SANITARY SEWER AND SHALL BE APPROVED BY THE CITY OF ABERDEEN. ALL MATERIALS USED ON THIS PROJECT SHALL BE LISTED IN THE APPROVED MATERIALS LIST AS IDENTIFIED IN THE RULES AND REGULATIONS OF
8.	THE DIVISION OF WATER AND SEWER AND AS AMENDED BY THE CITY OF ABERDEEN. ALL WORK SHALL BE PERFORMED IN ACCORDANCE WITH THE MARYLAND OCCUPATIONAL SAFETY LAWS.
9.	ALL UTILITIES ARE TO BE RETAINED, UNLESS MARKED OTHERWISE, AND ALL APPURTENANCES ARE TO BE ADJUSTED TO FINISH GRADE. CONTRACTOR IS RESPONSIBLE FOR ALL COSTS AND WORK REQUIRED TO ADJUST EXISTING AND PROPOSED UTILITIES AND APPURTENANCES TO FINISH GRADES WITHIN THE LIMITS OF WORK AND DISTURBED AREAS, INCLUDING THOSE
10.	WITHIN SIDEWALKS, EASEMENTS, AND RIGHT-OF-WAYS. ALL EASEMENTS AND RIGHT-OF -WAYS SHALL BE RESTORED TO A CONDITION AT LEAST EQUAL TO THAT WHICH EXISTED PRIOR TO THE START OF CONSTRUCTION. THE COST OF SUCH WORK SHALL BE BORNE BY THE CONTRACTOR.
	ALL PIPE ELEVATIONS ARE TO INVERT OF PIPE, UNLESS OTHERWISE SPECIFIED. ALL TRENCH COMPACTION SHALL BE IN ACCORDANCE WITH SECTION 02250, D.2A OF THE
13.	STANDARD SPECIFICATIONS, UNLESS OTHERWISE NOTED ON THE PROFILES. DEFAULT WATER MAINS AND FITTINGS (LARGER THAN 2") SHOULD BE C900 PVC PIPE CLASS 52 (244" TO 2", K CORDER THRING AND FITTINGS) MINIMUM 2.5' DEED.
14.	(3/4" TO 2"- K COPPER TUBING AND FITTINGS) MINIMUM 3.5' DEEP. ALL SEWER PIPE TO BE 4" & 6" SDR-26, 8" OR LARGER SDR-35, MINIMUM 3.5' DEEP, AND A
15.	CLEANOUT INSTALLED AT THE PARCEL BOUNDARY JUST BEFORE THE PUBLIC ROW NO CONNECTIONS TO THE EXISTING WATER AND SEWER SYSTEMS UNTIL CITY OF ABERDEEN
16.	INSPECTION APPROVAL. VERIFICATION, BY THE CITY OF ABERDEEN, OF THE BACKFLOW PREVENTER INSTALLATION(S) IS
17.	REQUIRED PRIOR TO ANY WATER CONSTRUCTION. CONSTRUCTION FROM THESE PLANS MUST BE STARTED WITHIN ONE (1) YEAR OF THE APPROVAL DATE OR APPROVAL IS NULL & VOID.
	LIMIT OF DISTURBANCE: 5.60 AC ZONING: RESIDENTIAL (R2)
5. 6.	ZONING: EXISTING USE: MIDDLE SCHOOL PROPOSED USE: MIDDLE SCHOOL MIDDLE SCHOOL ABERDEEN MUNICIPALITY LIMITS ABERDEEN MUNICIPALITY LIMITS MICHAEL DRIVE PROP. TEMP. WATER PROP. TEMP. WATER PROP. TEMP. WATER PROP. TEMP. WATER PROP. TEMP. WATER CEX. MIDDLE SCHOOL PROP. MATER METER PROP. TEMP. MODULAR BUILDING AREA COP. TEMP. SAN. ADD-ALT. 1: PROP. GEOTH
5. 6.	ZONING: EXISTING USE: MIDDLE SCHOOL PROPOSED USE: MIDDLE SCHOOL ABERDEEN MUNICIPALITY LIMITS ABERDEEN MUNICIPALITY LIMITS MICHAEL DRIVE PROP. WATER PROP. WATER PROP. TEMP. WATER PROP. TEMP. WATER PROP. TEMP. WATER PROP. TEMP. WATER PROP. TEMP. WATER PROP. TEMP. WATER PROP. TEMP. WATER PROP. TEMP. WATER PROP. TEMP. WATER PROP. MATER METER PROP. WATER PROP. WATER PROP. WATER PROP. WATER PROP. WATER PROP. WATER PROP. WATER PROP. MECH. CONNECTION SEE MEP PLANS.


# ABERDEEN MIDDLE SCHOOL PUBLIC WATER & SANITARY SEWER 2 1ST ST 3 2ND ST **4 CORNELL ST** 5 OAK ST 6 CHESTNUT ST DEEN Market 1 ST Ancinceu Ex & Walter W Aberdeel **Sakerfield**

LOCATION MAP SCALE: 1" = 600'

ADD	ALTERNATE 5	
BII	L OF MATERIALS - WA	<b>ATER</b>
QTY.	DESCRIPTION	SIZE
522 LF	WATER MAIN (DIP)	6"
1 EA	6" X 6" TEE	6"
310 LF	WATER MAIN (DIP)	8"
1 EA	8" X 6" TEE	8" X 6'
1 EA	8" TO 6" REDUCER	8" TO 6
2 EA	FIRE HYDRANT	-



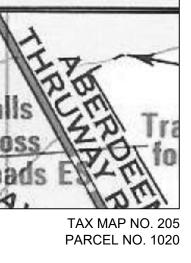

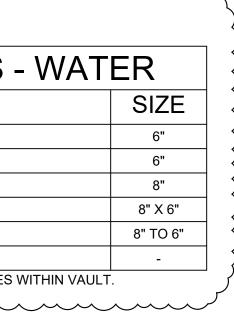

# UTILITY NOTES 1. ALL UTILITY RELOCATIONS MUST BE COORDINATED WITH THE RESPECTIVE UTILITY COMPANIES.

- . LOCATIONS OF ALL EXISTING AND PROPOSED SERVICES ARE APPROXIMATE AND MUST BE CONFIRMED INDEPENDENTLY WITH LOCAL UTILITY COMPANIES PRIOR TO COMMENCEMENT OF ANY CONSTRUCTION OR EXCAVATION. SANITARY SEWER AND ALL OTHER UTILITY SERVICES CONNECTION POINTS SHALL BE CONFIRMED INDEPENDENTLY BY THE CONTRACTOR IN THE FIELD PRIOR TO THE COMMENCEMENT OF CONSTRUCTION. ALL DISCREPANCIES SHALL BE REPORTED IMMEDIATELY IN WRITING TO THE ENGINEER. CONSTRUCTION SHALL COMMENCE BEGINNING AT THE LOWEST POINTS. CROSSINGS WITH EXISTING UNDERGROUND INSTALLATIONS SHALL BE FIELD VERIFIED BY TEST PIT PRIOR TO COMMENCEMENT OF CONSTRUCTION.
- 3. A MINIMUM VERTICAL SEPARATION OF 12" SHALL BE MAINTAINED BETWEEN SANITARY SEWER LINES, STORM DRAIN LINES, OR WATER LINES. IF THIS MINIMUM CLEARANCE CANNOT BE MAINTAINED, A CONCRETE ENCASEMENT SHALL BE PROVIDED. 4. EXISTING UTILITIES HAVE BEEN SHOWN IN ACCORDANCE WITH THE BEST AVAILABLE INFORMATION. IT SHALL
- BE THE CONTRACTORS RESPONSIBILITY TO VERIFY AND ALLOW FOR THEIR LOCATION. THE CONTRACTOR SHALL TAKE ALL NECESSARY PRECAUTIONS TO PROTECT THE EXISTING UTILITIES, AND MAINTAIN UNINTERRUPTED SERVICE. ANY DAMAGE DUE TO THE CONTRACTORS NEGLIGENCE SHALL BE IMMEDIATELY AND COMPLETELY REPAIRED AT THE CONTRACTOR'S EXPENSE.
- 5. ALL EXCAVATIONS THAT ARE DEEPER THAN 5 FEET SHALL BE PROPERLY SLOPED OR OTHERWISE STRUCTURALLY RETAINED T PROVIDE SAFE AND STABLE WORKING CONDITIONS. OCCUPATIONAL SAFETY AND HEALTH (OSHA) REQUIREMENTS CALL FOR MINIMUM SLOPES OF 1H:1V. OSHA REQUIREMENTS MUST BE FOLLOWED AND ADEQUATE PROTECTION PROVIDED FOR WORKERS.
- ANY SEDIMENT CONTROL MEASURES REMOVED FOR THE PURPOSE OF UTILITY CONSTRUCTION SHALL BE REPLACED BY THE END OF THE DAY BY THE UTILITY CONTRACTOR. 7. ALL STORM DRAIN, WATER, AND SEWER UTILITIES SHALL BE INSTALLED IN ACCORDANCE WITH THE LATEST EDITION OF THE HARFORD COUNTY STANDARD AND SPECIFICATIONS FOR UTILITY CONSTRUCTIONS.
- 8. SANITARY SEWER PIPE SHALL BE PVC SDR 35. 9. CONTRACTOR SHALL COORDINATE FINAL WORK SHUTDOWN ON A WEEKEND WITH HARFORD COUNTY PUBLIC SCHOOLS.

BILL OF MATERIALS - WATER		
QTY.	DESCRIPTION	SIZE
232 LF	WATER MAIN (DIP)	6"
4 EA	1/8 BEND	6"
3 EA	6" X 6" TEE	6"
331 LF	WATER MAIN (DIP)	8"
4 EA	1/8 BEND	8"
1 EA	8" X 6" TEE	8" X 6"
1 EA	8" TO 6" REDUCER	8" TO 6"
1 EA	FM METER & VAULT	8"

\*COMPLETE, IN PLACE, INCLUDING ALL APPURTENANCES WITHIN VAULT

BILL OF MATERIALS - SANITARY		
QTY. DESCRIPTION SIZE		SIZE
355 LF	SEWER MAIN (PVC SDR-35)	8"
1 EA	TYPE 'S-2' MANHOLE	48"

# **GEOTECHNICAL CERTIFICATION**

IN PLACE OF TESTING SHALL BE DONE BY A REGISTERED SOILS ENGINEER OR EQUIVALENT TO DETERMINE SUITABLITITY OF FILL MATERIAL AND TO CERTIFY COMPACTION TO CITY OF ABERDEEN SPECIFICATIONS.

(PRINT NAME) (COMPANY NAME) CERTIFY THAT THE SOIL(S) USED FOR FILL MATERIAL AT THIS SITE ARE APPROPRIATE FOR THIS SITE AND HAVE BEEN COMPACTED IN ACCORDANCE WITH THE CITY OF ABERDEEN

### SIGNATURE ENGINEER'S SEAL

SPECIFICATIONS."

# **OWNER'S CERTIFICATION** "I/WE CERTIFY THAT PROPOSED WORK SHOWN ON THESE CONSTRUCTION DRAWINGS WILL BE

ACCOMPLISHED PURSUANT TO THESE PLANS. I/WE UNDERSTAND THAT IT IS MY/OUR RESPONSIBILITY TO HAVE THE CONSTRUCTION SUPERVISED AND CERTIFIED INCLUDING THE SUBMITTAL AND CITY APPROVAL OF "AS BUILT" PLANS WITHIN 30 DAYS OF COMPLETION BY A REGISTERED CERTIFIED PROFESSIONAL ENGINEER."

Name			
ature			

# AS BUILT CERTIFICATION

I HEREBY CERTIFY THAT THE WATER AND SANITARY SEWER SHOWN ON THIS PLAN WAS CONSTRUCTED AS SHOWN ON THE "AS BUILT" PLANS AND MEETS THE APPROVED PLANS AND SPECIFICATIONS.

SIGNED	P.E. No.
PRINT NAME	DATE
CERTIFY MEANS TO STATE OR DECLARE A PROFESSIONAL OPINION BASED UP INSPECTIONS AND MATERIAL TESTS WHICH ARE CONDUCTED DURING CONST ONSITE INSPECTIONS AND MATERIAL TESTS ARE THOSE INSPECTIONS AND TH SUFFICIENT AND APPROPRIATE BY COMMONLY ACCEPTED ENGINEERING STA CERTIFY DOES NOT MEAN OR IMPLY A GUARANTEE BY THE ENGINEER NOR DO ENGINEER'S CERTIFICATION RELIEVE ANY OTHER PARTY FROM MEETING REC IMPOSED BY CONTRACT, EMPLOYMENT OR OTHER MEANS, INCLUDING MEETING	RUCTION. THE ESTS DEEMED NDARDS. DES AN UIREMENTS

# SHEET SET


SHEET NUMBER DRAWING TITLE WATER & SEWER COVER SHEET C301 WATER PLAN & PROFILE C302 WATER METER PLAN & PROFILE C303 SEWER PLAN & PROFILE C304 200 400 600 WATER & SEWER DETAILS SCALE: 1" = 600' 


	BERDEEN DEPARTMENT LIC WORKS APPROVAL	SITERESOURCES	
CITY ENGINEER:	DATE:	Creative Design. Successfully Engineered.	
DIRECTOR:	DATE:	4 North Park Drive, Suite 100, Cockeysville, MD 21030 410.683.3388 www.siteresourcesinc.com	PSC-


REVISIONS	DESCRIPTION	
	DATE	

Gipe Associates Inc.	Consulting Engineers
١	NO#2
	T R
DESIGNE	ĒR
DATE	3/3
VATER & SEWER COVER SHEET	HARFORD COUNTY PUBLIC SCHOOLS -




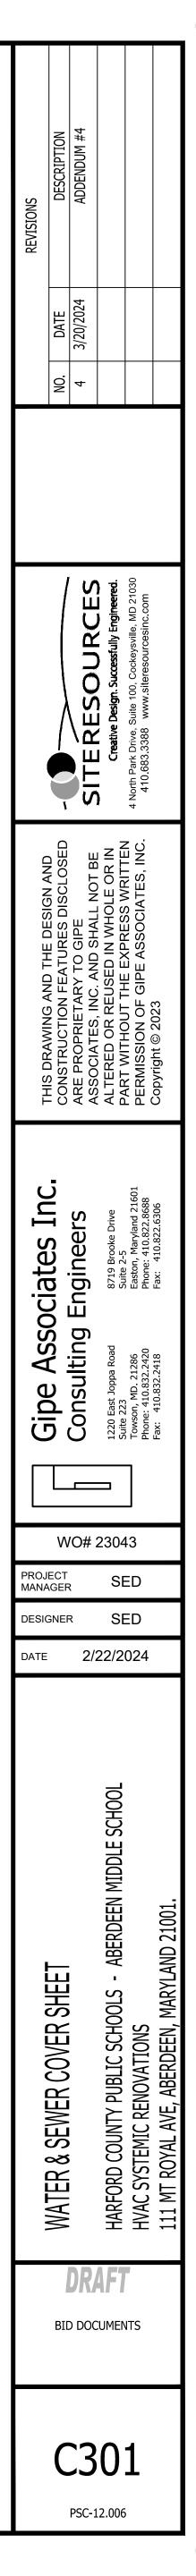


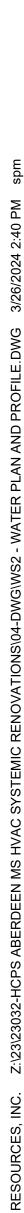

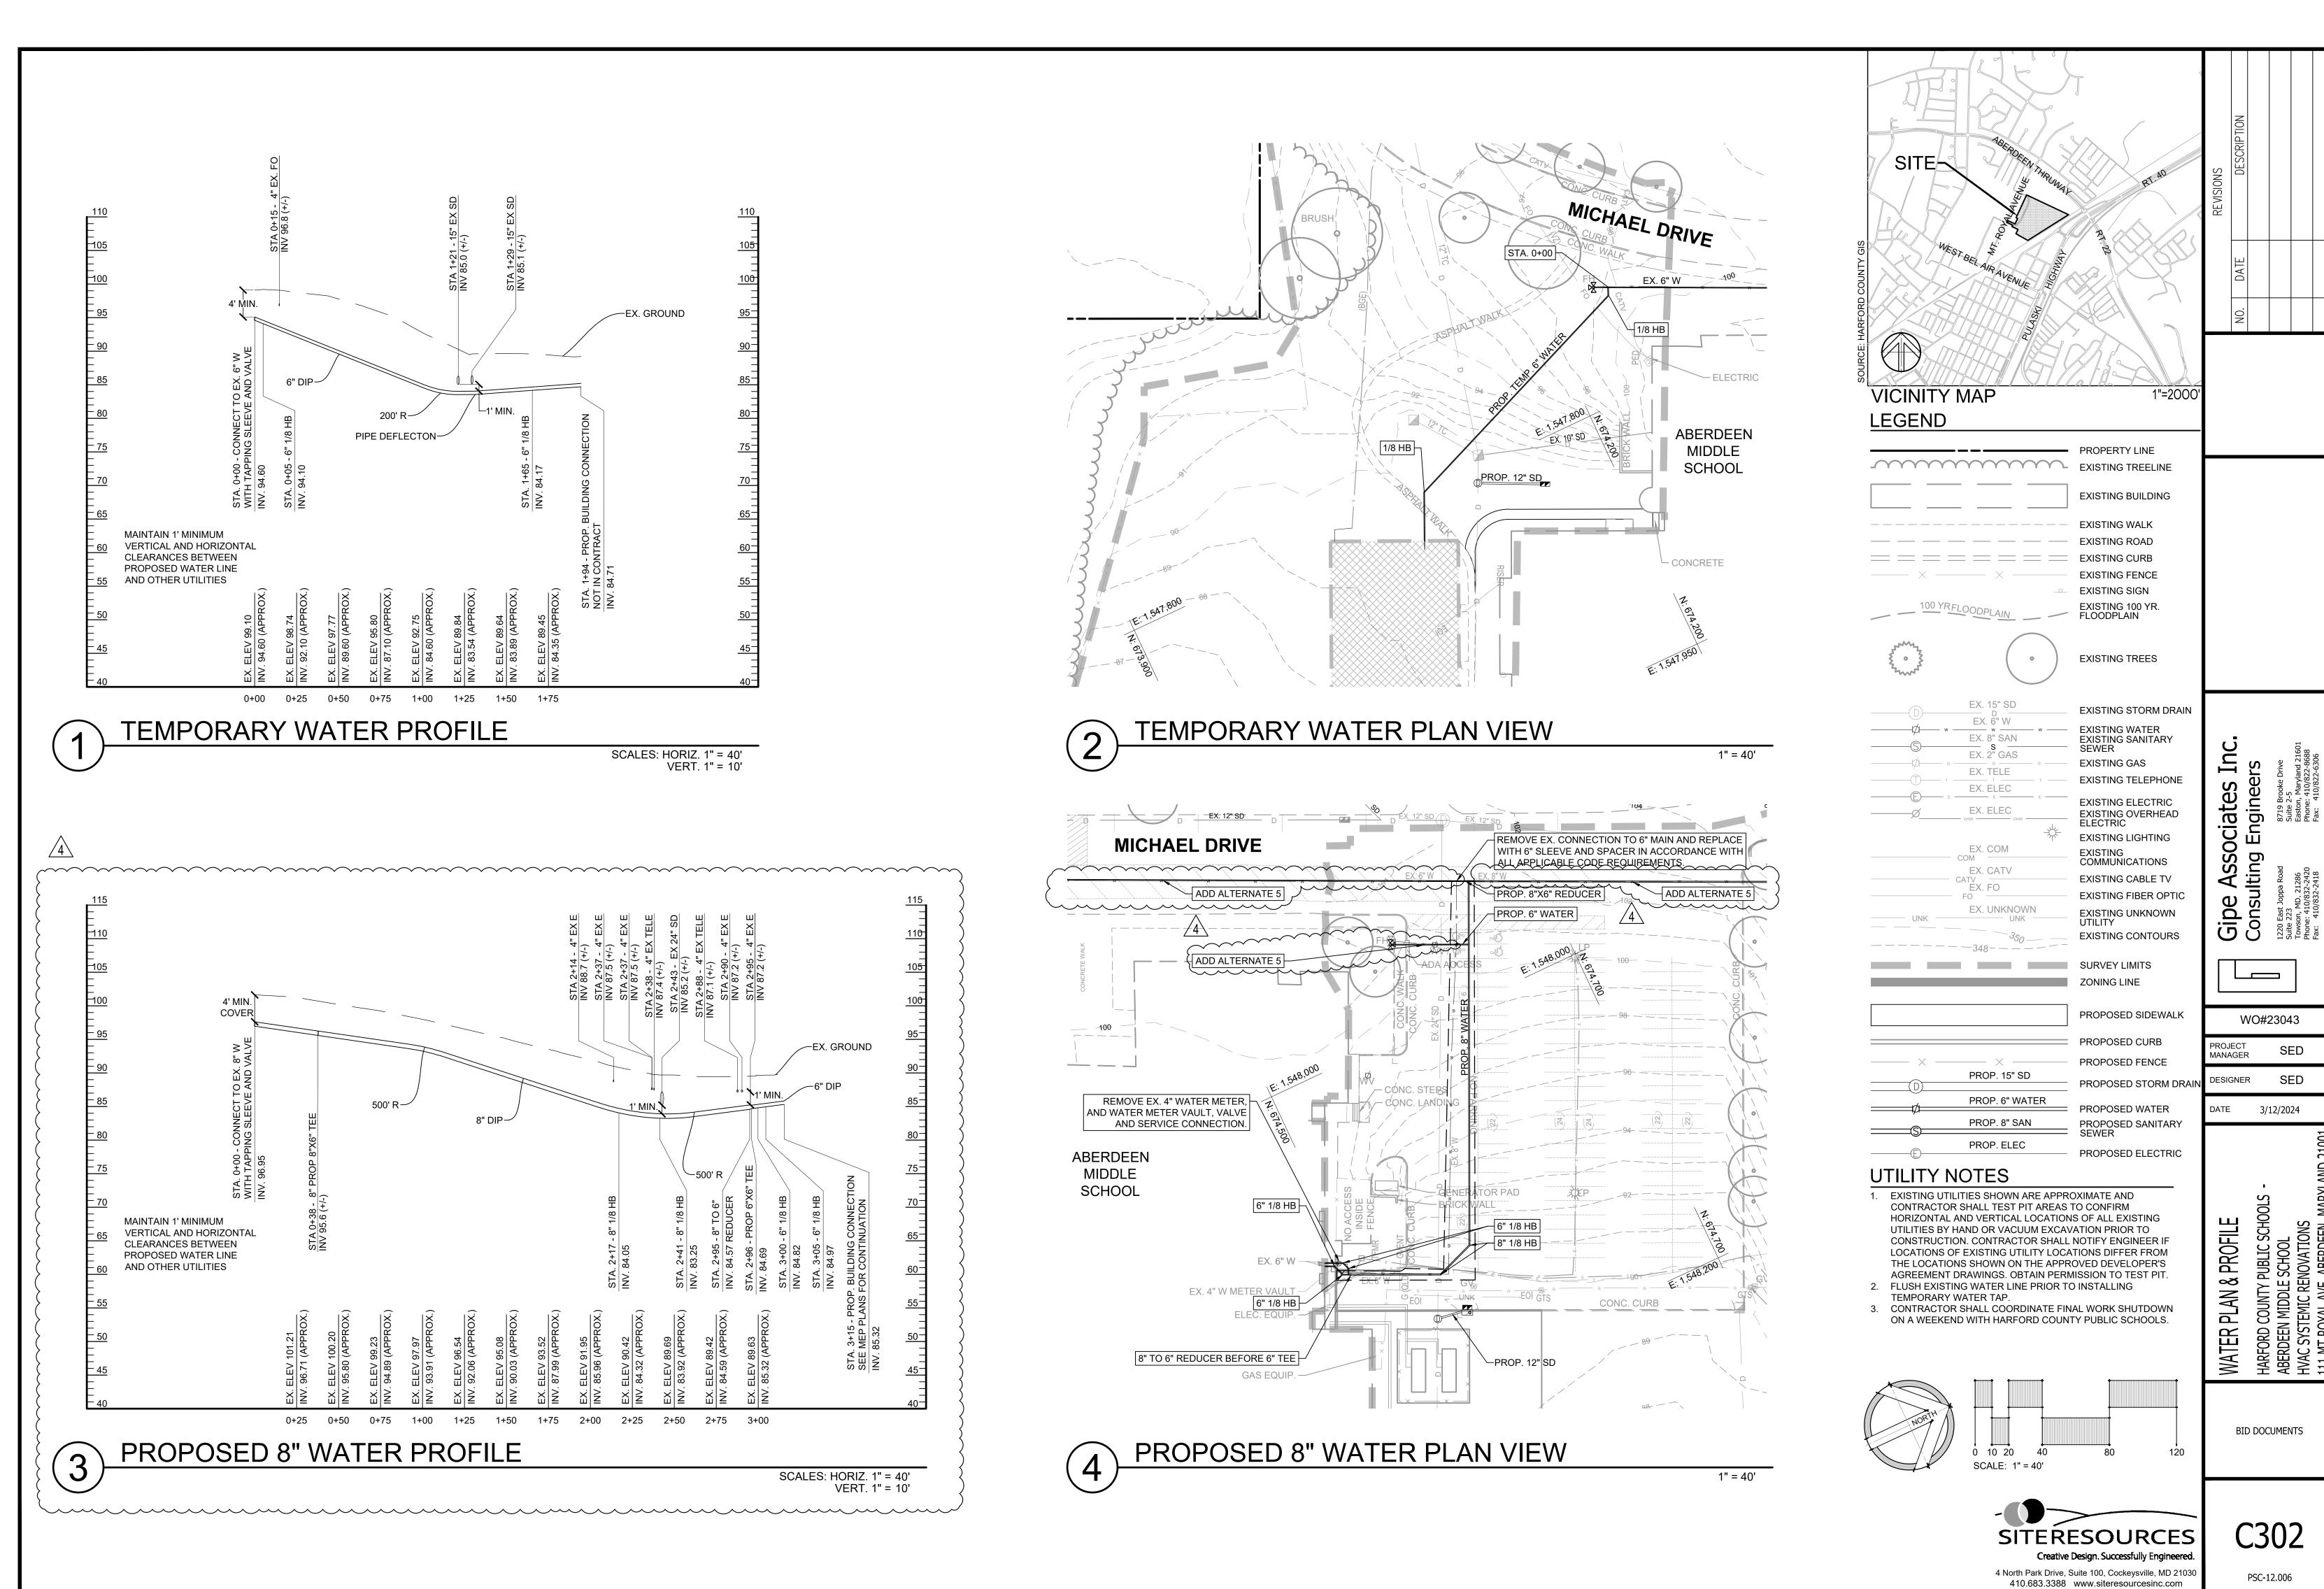




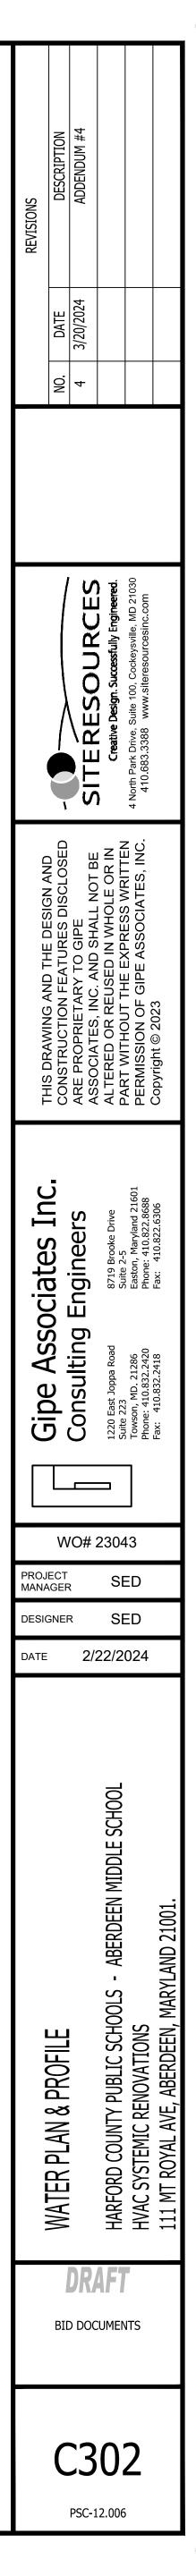

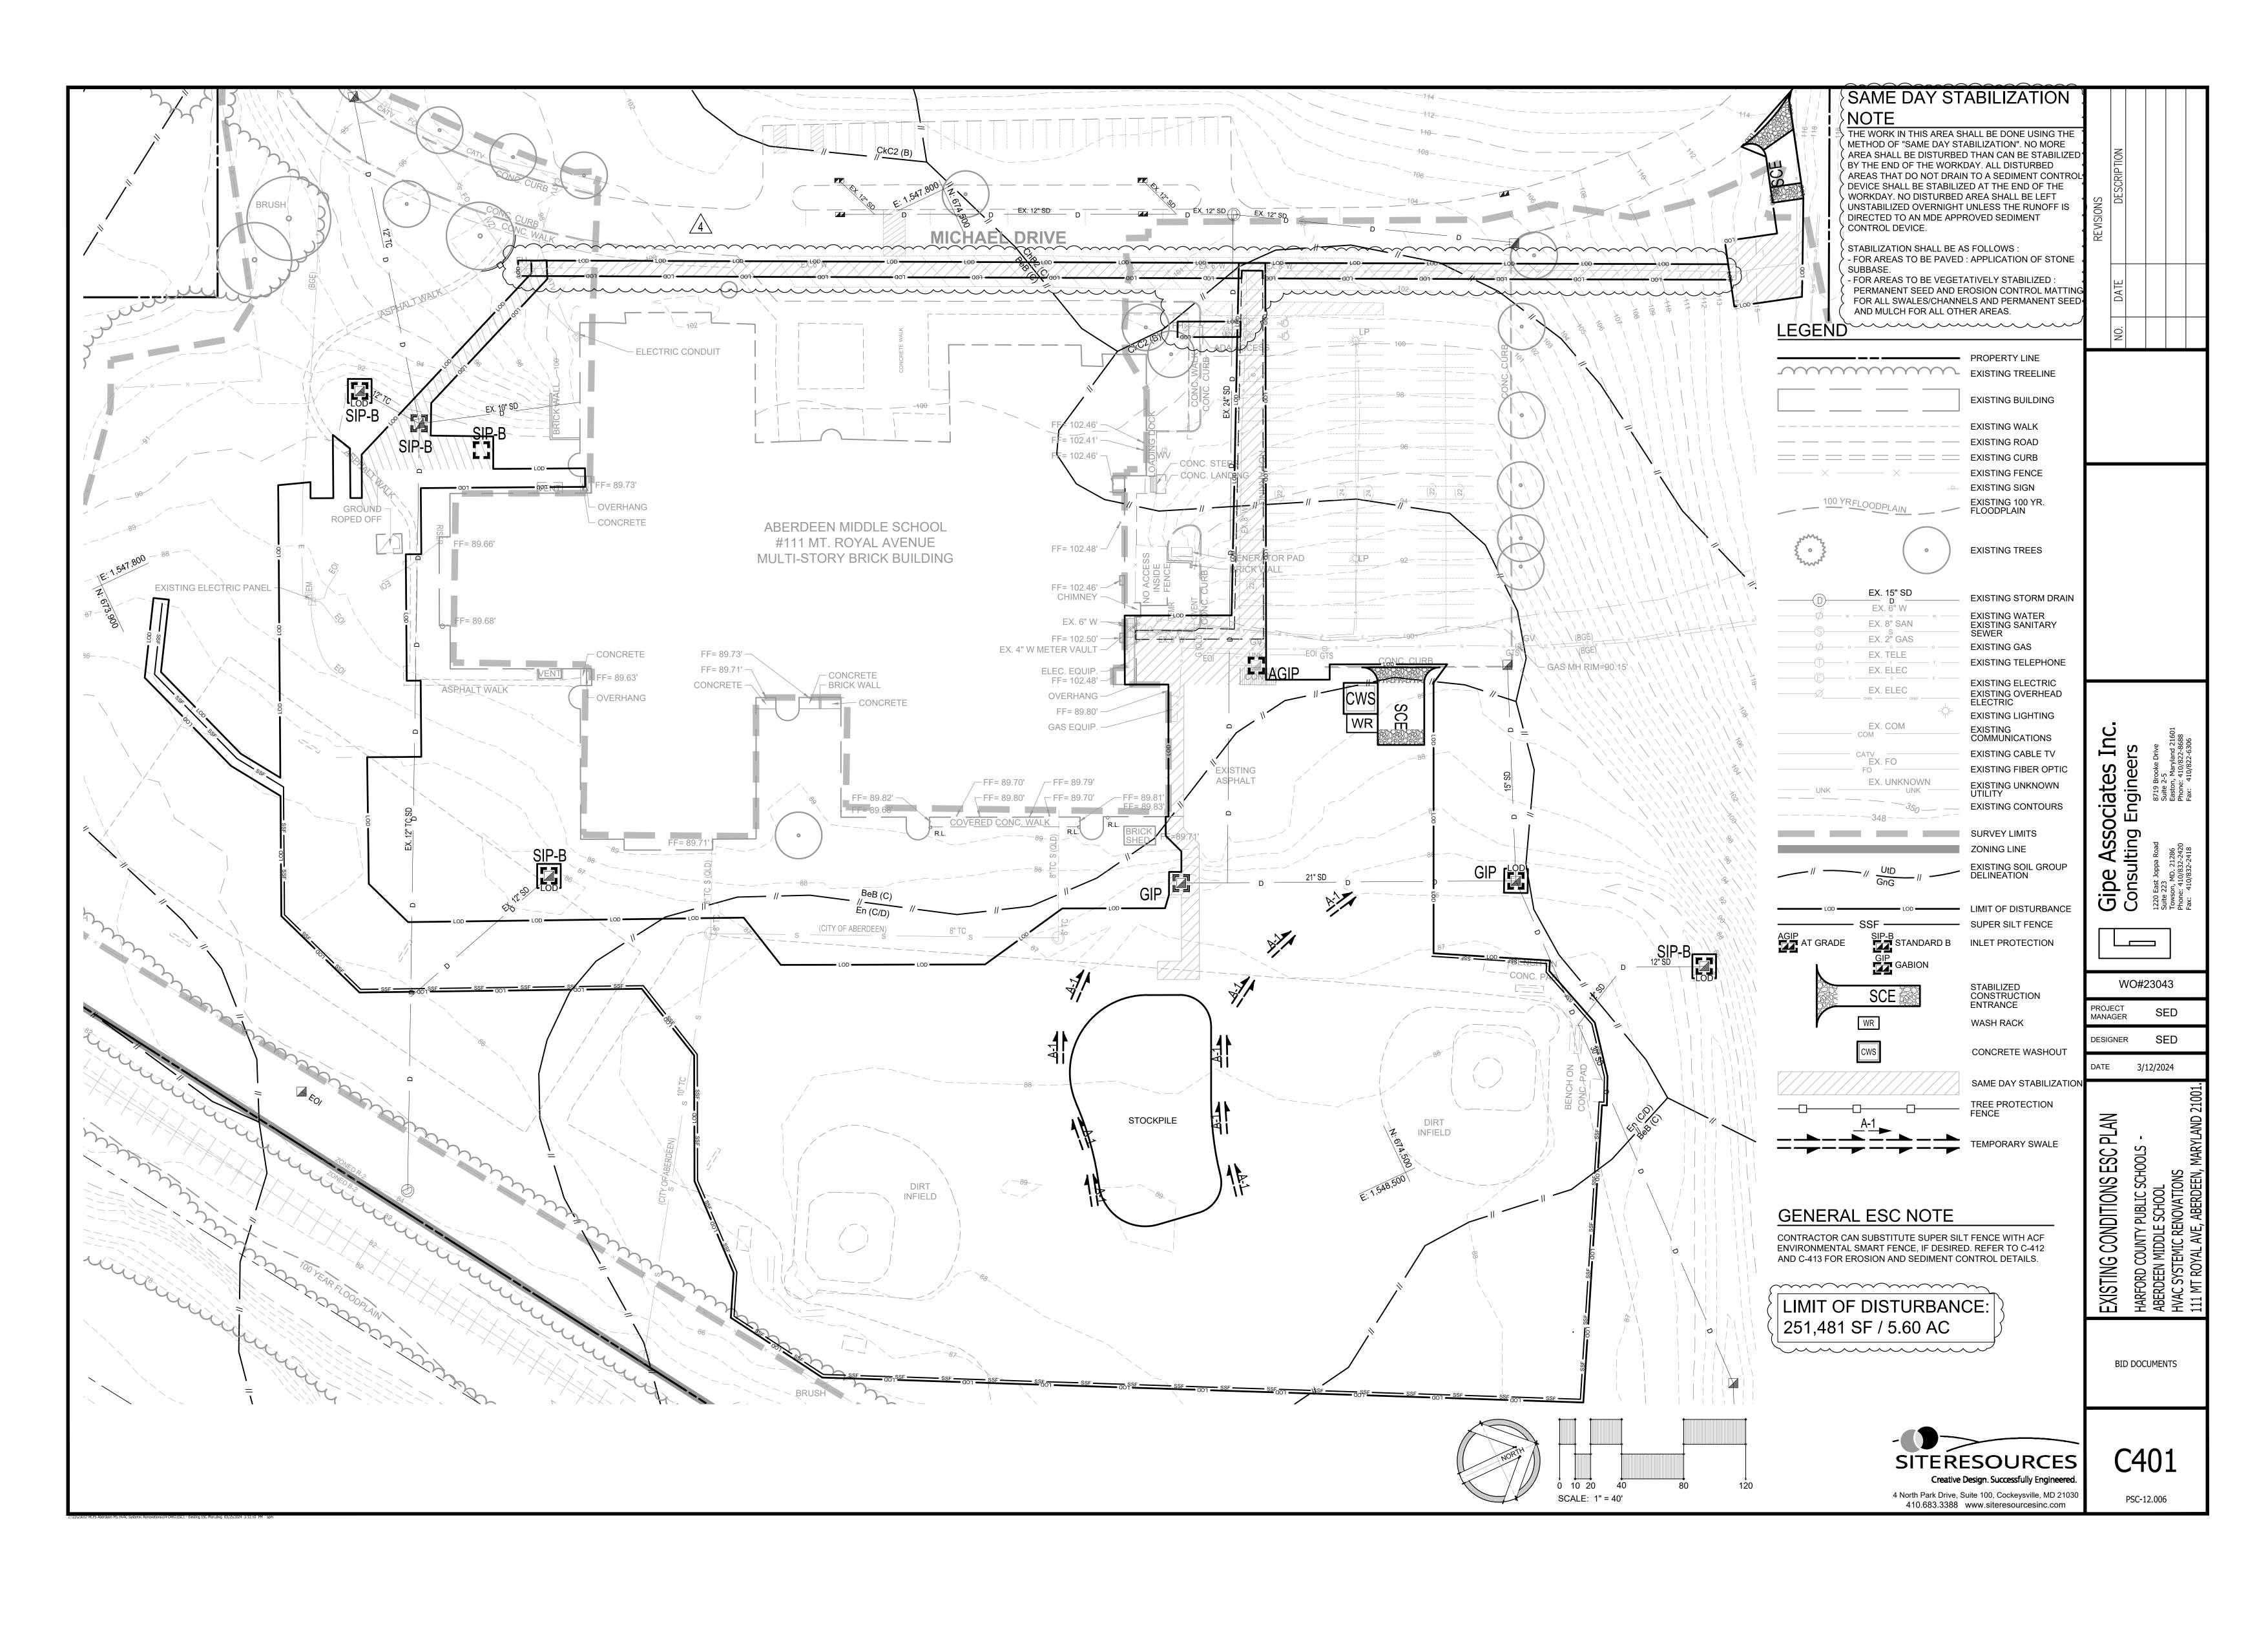

E RESOURCES, INC. Z:\23\23032-HCPS ABERDEEN MS HVAC SYSTEMIC RENOVATIONS\04-DWG\ESC1 - EXISTING ESC PLAN.DWG 3/25/2024 3:13 PM



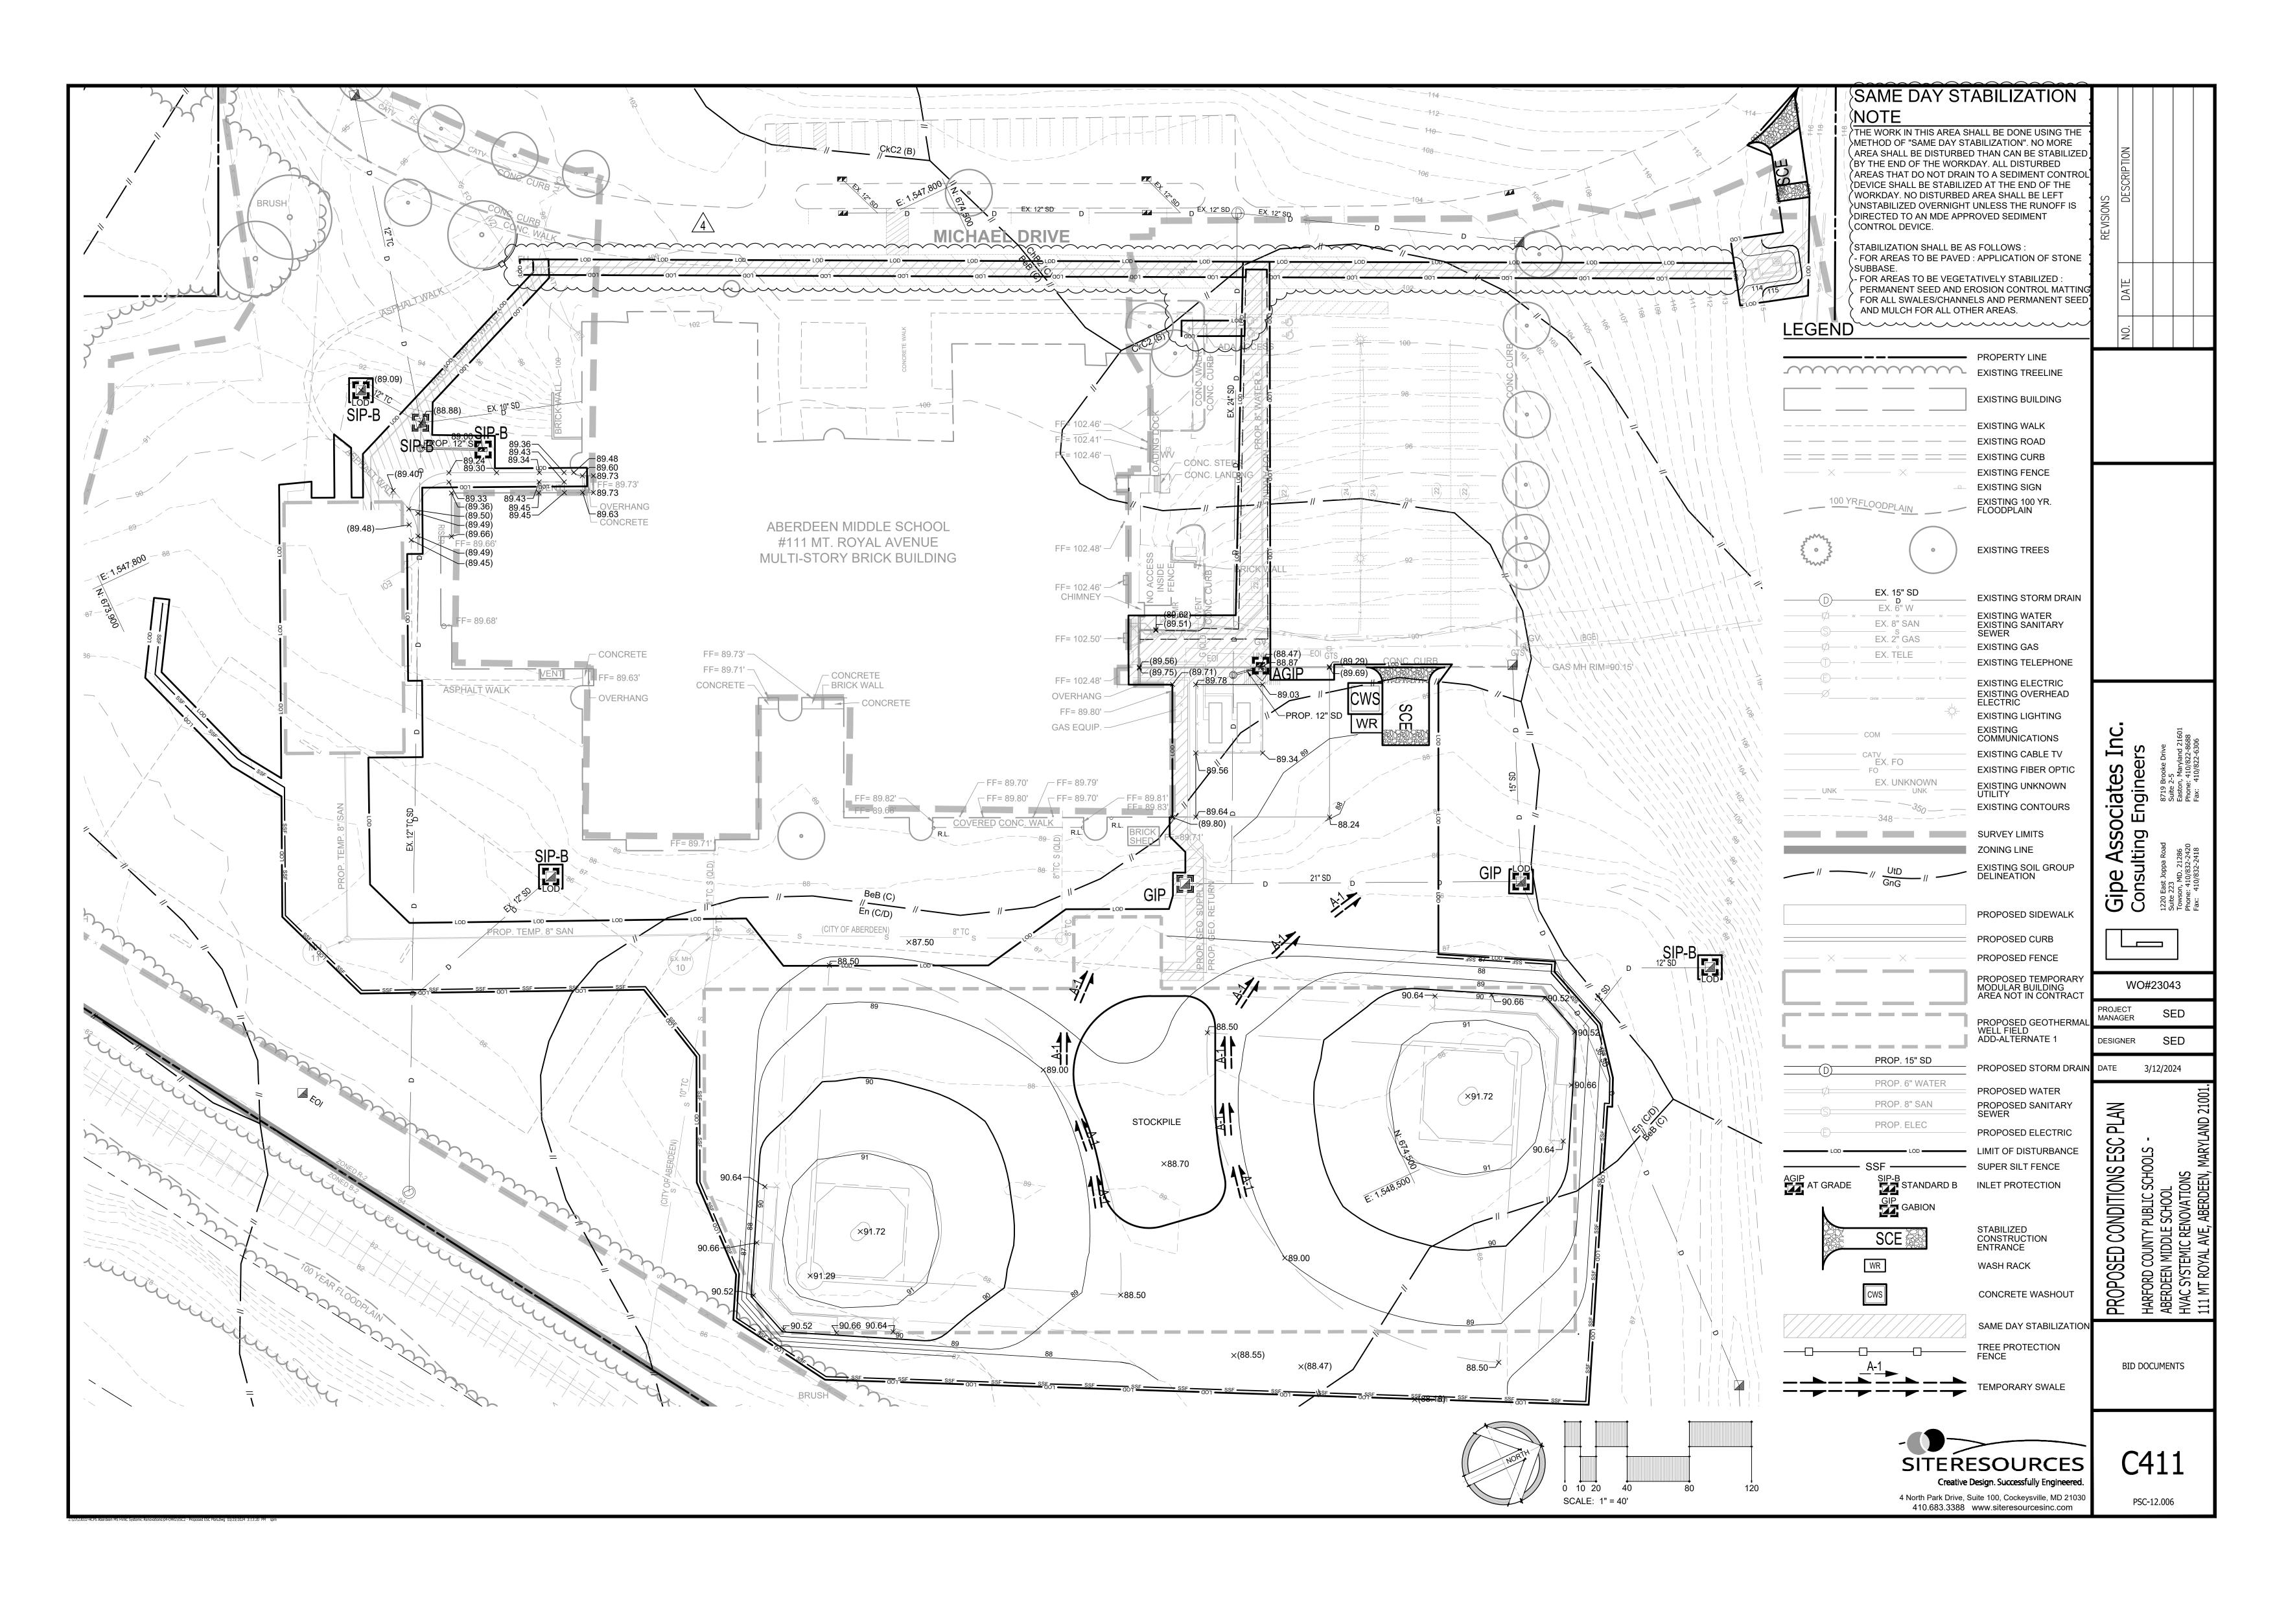





B-4 STANDARDS AND SPECIFICATIONS FOR VEGETATIVE STABILIZATION	B-4-2 STANDA FOR SOIL PRE <u>AND SOIL AME</u>
USING VEGETATION AS COVER TO PROTECT EXPOSED SOIL FROM EROSION.	DEFINITION THE PROCESS OF PREPARIN STABILIZATION.
<u>PURPOSE</u> TO PROMOTE THE ESTABLISHMENT OF VEGETATION ON EXPOSED SOIL.	<u>PURPOSE</u> TO PROVIDE A SUITABLE SC
CONDITIONS WHERE PRACTICE APPLIES ON ALL DISTURBED AREAS NOT STABILIZED BY OTHER METHODS. THIS SPECIFICATION IS DIVIDED INTO SECTIONS ON INCREMENTAL STABILIZATION; SOIL PREPARATION, SOIL AMENDMENTS AND TOPSOILING; SEEDING AND MULCHING; TEMPORARY STABILIZATION; AND PERMANENT STABILIZATION.	CONDITIONS WHERE PRACT WHERE VEGETATIVE STABIL
EFFECTS ON WATER QUALITY AND QUANTITY STABILIZATION PRACTICES ARE USED TO PROMOTE THE ESTABLISHMENT OF VEGETATION ON EXPOSED SOIL. WHEN SOIL IS STABILIZED WITH VEGETATION, THE SOIL IS LESS LIKELY TO ERODE AND MORE LIKELY TO ALLOW INFILTRATION OF RAINFALL, THEREBY REDUCING SEDIMENT LOADS AND RUNOFF TO DOWNSTREAM AREAS.	CRITERIA A. SOIL PREPARATION 1. TEMPORARY STAB a. SEEDBED PREP DEPTH OF 3 TO 9 OR CONSTRUCT CHISEL PLOWS 0 EQUIPMENT. AF
PLANTING VEGETATION IN DISTURBED AREAS WILL HAVE AN EFFECT ON THE WATER BUDGET, ESPECIALLY ON VOLUMES AND RATES OF RUNOFF, INFILTRATION, EVAPORATION, TRANSPIRATION, PERCOLATION, AND GROUNDWATER RECHARGE. OVER TIME, VEGETATION WILL INCREASE ORGANIC MATTER CONTENT AND IMPROVE THE WATER HOLDING CAPACITY OF THE SOIL AND SUBSEQUENT PLANT GROWTH.	ROLLED OR DRA CONDITION. SLC RIDGES RUNNIN b. APPLY FERTILIZ c. INCORPORATE L OF SOIL BY DISK 2. PERMANENT STABI
VEGETATION WILL HELP REDUCE THE MOVEMENT OF SEDIMENT, NUTRIENTS, AND OTHER CHEMICALS CARRIED BY RUNOFF TO RECEIVING WATERS. PLANTS WILL ALSO HELP PROTECT GROUNDWATER SUPPLIES BY ASSIMILATING THOSE SUBSTANCES PRESENT WITHIN THE ROOT ZONE.	a. A SOIL TEST IS F ACRES OR MOR PERMANENT VE i. SOIL PH BETWE ii. SOLUBLE SALTS
SEDIMENT CONTROL PRACTICES MUST REMAIN IN PLACE DURING GRADING, SEEDBED PREPARATION, SEEDING, MULCHING, AND VEGETATIVE ESTABLISHMENT.	iii. SOLODLE GALIC iii. SOIL CONTAINS GRAINED MATEF TO PROVIDE TH MOISTURE. AN E A SANDY SOIL (I
ADEQUATE VEGETATIVE ESTABLISHMENT INSPECT SEEDED AREAS FOR VEGETATIVE ESTABLISHMENT AND MAKE NECESSARY REPAIRS, REPLACEMENTS, AND RESEEDINGS WITHIN THE PLANTING SEASON.	iv. SOIL CONTAINS WEIGHT. v. SOIL CONTAINS ROOT PENETRA
<ol> <li>ADEQUATE VEGETATIVE STABILIZATION REQUIRES 95 PERCENT GROUNDCOVER.</li> <li>IF AN AREA HAS LESS THAN 40 PERCENT GROUNDCOVER, RESTABILIZE FOLLOWING THE ORIGINAL RECOMMENDATIONS FOR LIME, FERTILIZER, SEEDBED PREPARATION, AND SEEDING.</li> <li>IF AN AREA HAS BETWEEN 40 AND 94 PERCENT GROUNDCOVER, OVER-SEED AND FERTILIZE USING HALF OF THE RATES ORIGINALLY SPECIFIED.</li> <li>MAINTENANCE FERTILIZER RATES FOR PERMANENT SEEDING ARE SHOWN</li> </ol>	b. APPLICATION OF ON-SITE SOILS I c. GRADED AREAS AS SPECIFIED O OTHERWISE LOO d. APPLY SOIL AME OR AS INDICATE e. MIX SOIL AMENE DISKING OR OTH
<b>STABILIZATION</b> DEFINITION ESTABLISHMENT OF VEGETATIVE COVER ON CUT AND FILL SLOPES. PURPOSE TO PROVIDE TIMELY VEGETATIVE COVER ON CUT AND FILL SLOPES AS WORK PROGRESSES.	LEAVING THE SO RUNNING PARAL TOP 1 TO 3 INCH LOOSENING MA B. TOPSOILING 1. TOPSOIL IS PLACEI ESTABLISHMENT O
<u>CONDITIONS WHERE PRACTICE APPLIES</u> ANY CUT OR FILL SLOPE GREATER THAN 15 FEET IN HEIGHT. THIS PRACTICE ALSO APPLIES TO STOCKPILES.	PROVIDE A SUITAB OF CONCERN HAVE LOW PH, MATERIAL GRADATION.
<ul> <li><u>CRITERIA</u></li> <li>A. INCREMENTAL STABILIZATION - CUT SLOPES</li> <li>1. EXCAVATE AND STABILIZE CUT SLOPES IN INCREMENTS NOT TO EXCEED 15 FEET IN HEIGHT. PREPARE SEEDBED AND APPLY SEED AND MULCH ON ALL CUT SLOPES AS THE WORK PROGRESSES.</li> <li>2. CONSTRUCTION SEQUENCE EXAMPLE (REFER TO FIGURE</li> </ul>	<ol> <li>TOPSOIL SALVAGE</li> <li>IT MEETS THE STAI</li> <li>TYPICALLY, THE DE</li> <li>SOIL TYPE CAN BE</li> <li>SECTION IN THE SO</li> <li>TOPSOILING IS LIM</li> </ol>
<ul> <li>a. CONSTRUCT AND STABILIZE ALL TEMPORARY SWALES OR DIKES THAT WILL BE USED TO CONVEY RUNOFF AROUND THE EXCAVATION.</li> <li>b. PERFORM PHASE 1 EXCAVATION, PREPARE SEEDBED, AND STABILIZE.</li> <li>c. PERFORM PHASE 2 EXCAVATION, PREPARE SEEDBED, AND</li> </ul>	WHERE: a. THE TEXTURE C ADEQUATE TO F b. THE SOIL MATEF NOT DEEP ENOU SUPPLIES OF MO
<ul> <li>c. PERFORM PHASE 2 EXCAVATION, PREPARE SEEDBED, AND STABILIZE. OVERSEED PHASE 1 AREAS AS NECESSARY.</li> <li>d. PERFORM FINAL PHASE EXCAVATION, PREPARE SEEDBED, AND STABILIZE. OVERSEED PREVIOUSLY SEEDED AREAS AS NECESSARY.</li> </ul>	c. THE ORIGINAL S TO PLANT GROV d. THE SOIL IS SO FEASIBLE. 4. AREAS HAVING SLO
NOTE: ONCE EXCAVATION HAS BEGUN, THE OPERATION SHOULD BE CONTINUOUS FROM GRUBBING THROUGH THE COMPLETION OF GRADING AND PLACEMENT OF TOPSOIL (IF REQUIRED) AND PERMANENT SEED AND MULCH. ANY INTERRUPTIONS IN THE OPERATION OR COMPLETING THE OPERATION OUT OF THE SEEDING SEASON WILL NECESSITATE THE APPLICATION OF TEMPORARY STABILIZATION.	CONSIDERATION A 5. TOPSOIL SPECIFIC THE FOLLOWING C a. TOPSOIL MUST SANDY CLAY LO RECOMMENDED APPROVED BY T
<ul> <li>B. INCREMENTAL STABILIZATION - FILL SLOPES</li> <li>1. CONSTRUCT AND STABILIZE FILL SLOPES IN INCREMENTS NOT TO EXCEED 15 FEET IN HEIGHT. PREPARE SEEDBED AND APPLY SEED AND MULCH ON ALL SLOPES AS THE WORK PROGRESSES.</li> <li>2. STABILIZE SLOPES IMMEDIATELY WHEN THE VERTICAL HEIGHT OF A LIFT REACHES 15 FEET, OR WHEN THE GRADING OPERATION CEASES AS PRESCRIBED ON THE PLANS.</li> <li>3. AT THE END OF EACH DAY, INSTALL TEMPORARY WATER CONVEYANCE PRACTICE(S), AS NECESSARY, TO INTERCEPT SURFACE RUNOFF AND CONVEY IT DOWN THE SLOPE IN A NON-EROSIVE</li> </ul>	MUST NOT BE A AND MUST CON CINDERS, STON ROOTS, TRASH, DIAMETER. b. TOPSOIL MUST SUCH AS BERMI SEDGE, POISON c. TOPSOIL SUBST QUALIFIED AGR
<ul> <li>MANNER.</li> <li>4. CONSTRUCTION SEQUENCE EXAMPLE (REFER TO FIGURE B.2): <ul> <li>a. CONSTRUCT AND STABILIZE ALL TEMPORARY SWALES OR DIKES THAT WILL BE USED TO DIVERT RUNOFF AROUND THE FILL.</li> <li>CONSTRUCT SILT FENCE ON LOW SIDE OF FILL UNLESS OTHER METHODS SHOWN ON THE PLANS ADDRESS THIS AREA.</li> <li>b. AT THE END OF EACH DAY, INSTALL TEMPORARY WATER CONVEYANCE PRACTICE(S), AS NECESSARY, TO INTERCEPT</li> </ul></li></ul>	THE APPROPRIA NATURAL TOPSO 6. TOPSOIL APPLICAT a. EROSION AND S MAINTAINED WH b. UNIFORMLY DIS LIGHTLY COMPA SPREADING IS T SODDING OR SE
<ul> <li>SURFACE RUNOFF AND CONVEY IT DOWN THE SLOPE IN A NON-EROSIVE MANNER.</li> <li>c. PLACE PHASE 1 FILL, PREPARE SEEDBED, AND STABILIZE.</li> <li>d. PLACE PHASE 2 FILL, PREPARE SEEDBED, AND STABILIZE.</li> <li>e. PLACE FINAL PHASE FILL, PREPARE SEEDBED, AND STABILIZE.</li> <li>OVERSEED PREVIOUSLY SEEDED AREAS AS NECESSARY.</li> </ul>	ADDITIONAL SO IN THE SURFACE OPERATIONS MI FORMATION OF c. TOPSOIL MUST FROZEN OR MU
NOTE: ONCE THE PLACEMENT OF FILL HAS BEGUN, THE OPERATION SHOULD BE CONTINUOUS FROM GRUBBING THROUGH THE COMPLETION OF GRADING AND PLACEMENT OF TOPSOIL (IF REQUIRED) AND PERMANENT SEED AND MULCH. ANY INTERRUPTIONS IN THE OPERATION OR COMPLETING THE OPERATION OUT OF THE SEEDING SEASON WILL NECESSITATE THE	EXCESSIVELY V DETRIMENTAL 1

# DS AND SPECIFICATIONS ARATION, TOPSOILING DMENTS

THE SOILS TO SUSTAIN ADEQUATE VEGETATIVE

DIUM FOR VEGETATIVE GROWTH.

<u>APPLIES</u> FION IS TO BE ESTABLISHED.

# TION

FION CONSISTS OF LOOSENING SOIL TO A HES BY MEANS OF SUITABLE AGRICULTURAL QUIPMENT, SUCH AS DISC HARROWS OR PPERS MOUNTED ON CONSTRUCTION

- HE SOIL IS LOOSENED, IT MUST NOT BE SMOOTH BUT LEFT IN THE ROUGHENED 3:1 OR FLATTER ARE TO BE TRACKED WITH RALLEL TO THE CONTOUR OF THE SLOPE. ND LIME AS PRESCRIBED ON THE PLANS. ND FERTILIZER INTO THE TOP 3 TO 5 INCHES OR OTHER SUITABLE MEANS. **FION**
- RED FOR ANY EARTH DISTURBANCE OF 5 MINIMUM SOIL CONDITIONS REQUIRED FOR TIVE ESTABLISHMENT ARE: AND 7.0.
- THAN 500 PARTS PER MILLION (PPM). THAN 40 PERCENT CLAY BUT ENOUGH FINE GREATER THAN 30 PERCENT SILT PLUS CLAY) PACITY TO HOLD A MODERATE AMOUNT OF PTION: IF LOVEGRASS WILL BE PLANTED, THEN THAN 30 PERCENT SILT PLUS CLAY) WOULD BE
- ERCENT MINIMUM ORGANIC MATTER BY
- FICIENT PORE SPACE TO PERMIT ADEQUATE NDMENTS OR TOPSOIL IS REQUIRED IF
- OT MEET THE ABOVE CONDITIONS. BE MAINTAINED IN A TRUE AND EVEN GRADE APPROVED PLAN, THEN SCARIFIED OR ED TO A DEPTH OF 3 TO 5 INCHES.
- ENTS AS SPECIFIED ON THE APPROVED PLAN THE RESULTS OF A SOIL TEST. TS INTO THE TOP 3 TO 5 INCHES OF SOIL BY UITABLE MEANS. RAKE LAWN AREAS TO CE, REMOVE LARGE OBJECTS LIKE STONES READY THE AREA FOR SEED APPLICATION. OIL BY DRAGGING WITH A HEAVY CHAIN OR O ROUGHEN THE SURFACE WHERE SITE
- T PERMIT NORMAL SEEDBED PREPARATION. R FLATTER WITH TRACKED EQUIPMENT AN IRREGULAR CONDITION WITH RIDGES TO THE CONTOUR OF THE SLOPE. LEAVE THE F SOIL LOOSE AND FRIABLE. SEEDBED JNNECESSARY ON NEWLY DISTURBED AREAS.
- ER PREPARED SUBSOIL PRIOR TO MANENT VEGETATION. THE PURPOSE IS TO OIL MEDIUM FOR VEGETATIVE GROWTH. SOILS
- MOISTURE CONTENT, LOW NUTRIENT LEVELS, XIC TO PLANTS, AND/OR UNACCEPTABLE SOIL OM AN EXISTING SITE MAY BE USED PROVIDED
- DS AS SET FORTH IN THESE SPECIFICATIONS. OF TOPSOIL TO BE SALVAGED FOR A GIVEN ND IN THE REPRESENTATIVE SOIL PROFILE JRVEY PUBLISHED BY USDA-NRCS. TO AREAS HAVING 2:1 OR FLATTER SLOPES
- EXPOSED SUBSOIL/PARENT MATERIAL IS NOT UCE VEGETATIVE GROWTH. S SO SHALLOW THAT THE ROOTING ZONE IS O SUPPORT PLANTS OR FURNISH CONTINUING RE AND PLANT NUTRIENTS. TO BE VEGETATED CONTAINS MATERIAL TOXIC
- C THAT TREATMENT WITH LIMESTONE IS NOT STEEPER THAN 2:1 REQUIRE SPECIAL
- SIGN. NS: SOIL TO BE USED AS TOPSOIL MUST MEET
- LOAM, SANDY LOAM, CLAY LOAM, SILT LOAM, OR LOAMY SAND. OTHER SOILS MAY BE USED IF N AGRONOMIST OR SOIL SCIENTIST AND PPROPRIATE APPROVAL AUTHORITY. TOPSOIL JRE OF CONTRASTING TEXTURED SUBSOILS LESS THAN 5 PERCENT BY VOLUME OF AG, COARSE FRAGMENTS, GRAVEL, STICKS,
- THER MATERIALS LARGER THAN 1½ INCHES IN REE OF NOXIOUS PLANTS OR PLANT PARTS
- RASS, QUACK GRASS, JOHNSON GRASS, NUT THISTLE, OR OTHERS AS SPECIFIED. ES OR AMENDMENTS, AS RECOMMENDED BY A IST OR SOIL SCIENTIST AND APPROVED BY PROVAL AUTHORITY, MAY BE USED IN LIEU OF
- ENT CONTROL PRACTICES MUST BE PPLYING TOPSOIL. UTE TOPSOIL IN A 5 TO 8 INCH LAYER AND
- D A MINIMUM THICKNESS OF 4 INCHES. PERFORMED IN SUCH A MANNER THAT G CAN PROCEED WITH A MINIMUM OF EPARATION AND TILLAGE. ANY IRREGULARITIES SULTING FROM TOPSOILING OR OTHER E CORRECTED IN ORDER TO PREVENT THE ESSIONS OR WATER POCKETS. BE PLACED IF THE TOPSOIL OR SUBSOIL IS IN A ONDITION, WHEN THE SUBSOIL IS
- R IN A CONDITION THAT MAY OTHERWISE BE OPER GRADING AND SEEDBED PREPARATION.

- C. SOIL AMENDMENTS (FERTILIZER AND LIME SPECIFICATIONS) SOIL TESTS MUST BE PERFORMED TO DETERMINE THE EXACT RATIOS AND APPLICATION RATES FOR BOTH LIME AND FERTILIZER ON SITES HAVING DISTURBED AREAS OF 5 ACRES OR MORE. SOIL ANALYSIS MAY BE PERFORMED BY A RECOGNIZED PRIVATE OR COMMERCIAL LABORATORY. SOIL SAMPLES TAKEN FOR ENGINEERING PURPOSES MAY ALSO BE USED FOR CHEMICAL ANALYSES.
  - FERTILIZERS MUST BE UNIFORM IN COMPOSITION, FREE FLOWING AND SUITABLE FOR ACCURATE APPLICATION BY APPROPRIATE EQUIPMENT. MANURE MAY BE SUBSTITUTED FOR FERTILIZER WITH PRIOR APPROVAL FROM THE APPROPRIATE APPROVAL AUTHORITY. FERTILIZERS MUST ALL BE DELIVERED TO THE SITE FULLY LABELED ACCORDING TO THE APPLICABLE LAWS AND MUST BEAR THE NAME,
- TRADE NAME OR TRADEMARK AND WARRANTY OF THE PRODUCER. LIME MATERIALS MUST BE GROUND LIMESTONE (HYDRATED OR BURNT LIME MAY BE SUBSTITUTED EXCEPT WHEN HYDROSEEDING) WHICH CONTAINS AT LEAST 50 PERCENT TOTAL OXIDES (CALCIUM OXIDE PLUS MAGNESIUM OXIDE). LIMESTONE MUST BE GROUND TO SUCH FINENESS THAT AT LEAST 50 PERCENT WILL PASS THROUGH A #100 MESH SIEVE AND 98 TO 100 PERCENT WILL PASS THROUGH A #20 MESH
- SIEVE. LIME AND FERTILIZER ARE TO BE EVENLY DISTRIBUTED AND INCORPORATED INTO THE TOP 3 TO 5 INCHES OF SOIL BY DISKING OR
- OTHER SUITABLE MEANS. 5. WHERE THE SUBSOIL IS EITHER HIGHLY ACIDIC OR COMPOSED OF HEAVY CLAYS, SPREAD GROUND LIMESTONE AT THE RATE OF 4 TO 8 TONS/ACRE (200-400 POUNDS PER 1,000 SQUARE FEET) PRIOR TO THE

# **B-4-3 STANDARDS AND SPECIFICATIONS** FOR SEEDING AND MULCHING

THE APPLICATION OF SEED AND MULCH TO ESTABLISH VEGETATIVE COVER.

TO PROTECT DISTURBED SOILS FROM EROSION DURING AND AT THE END OF CONSTRUCTION.

CONDITIONS WHERE PRACTICE APPLIES TO THE SURFACE OF ALL PERIMETER CONTROLS, SLOPES, AND ANY

PLACEMENT OF TOPSOIL.

DISTURBED AREA NOT UNDER ACTIVE GRADING.

A. SEEDING

- 1. SPECIFICATIONS a. ALL SEED MUST MEET THE REQUIREMENTS OF THE MARYLAND STATE SEED LAW. ALL SEED MUST BE SUBJECT TO RE-TESTING BY A RECOGNIZED SEED LABORATORY. ALL SEED USED MUST HAVE BEEN TESTED WITHIN THE 6 MONTHS IMMEDIATELY PRECEDING THE DATE OF SOWING SUCH MATERIAL ON ANY PROJECT. REFER TO TABLE B.4 REGARDING THE QUALITY OF SEED. SEED TAGS MUST BE AVAILABLE UPON REQUEST TO THE INSPECTOR TO VERIFY TYPE OF SEED AND SEEDING RATE.
- b. MULCH ALONE MAY BE APPLIED BETWEEN THE FALL AND SPRING SEEDING DATES ONLY IF THE GROUND IS FROZEN. THE APPROPRIATE SEEDING MIXTURE MUST BE APPLIED WHEN THE GROUND THAWS.
- c. INOCULANTS: THE INOCULANT FOR TREATING LEGUME SEED IN THE SEED MIXTURES MUST BE A PURE CULTURE OF NITROGEN FIXING BACTERIA PREPARED SPECIFICALLY FOR THE SPECIES. INOCULANTS MUST NOT BE USED LATER THAN THE DATE INDICATED ON THE CONTAINER. ADD FRESH INOCULANTS AS DIRECTED ON THE PACKAGE. USE FOUR TIMES THE RECOMMENDED RATE WHEN HYDROSEEDING. NOTE: IT IS VERY IMPORTANT TO KEEP INOCULANT AS COOL AS POSSIBLE UNTIL USED. TEMPERATURES ABOVE 75 TO 80 DEGREES FAHRENHEIT CAN WEAKEN BACTERIA AND MAKE THE
- INOCULANT LESS EFFECTIVE. d. SOD OR SEED MUST NOT BE PLACED ON SOIL WHICH HAS BEEN TREATED WITH SOIL STERILANTS OR CHEMICALS USED FOR WEED CONTROL UNTIL SUFFICIENT TIME HAS ELAPSED (14 DAYS MIN.) TO PERMIT DISSIPATION OF PHYTO-TOXIC MATERIALS.
- 2. APPLICATION a. DRY SEEDING: THIS INCLUDES USE OF CONVENTIONAL DROP OR BROADCAST SPREADERS. INCORPORATE SEED INTO THE SUBSOIL AT THE RATES PRESCRIBED
- ON TEMPORARY SEEDING TABLE B.1, PERMANENT SEEDING TABLE B.3, OR SITE-SPECIFIC SEEDING SUMMARIES. ii. APPLY SEED IN TWO DIRECTIONS, PERPENDICULAR TO EACH OTHER. APPLY HALF THE SEEDING RATE IN EACH DIRECTION. ROLL
- THE SEEDED AREA WITH A WEIGHTED ROLLER TO PROVIDE GOOD SEED TO SOIL CONTACT b. DRILL OR CULTIPACKER SEEDING: MECHANIZED SEEDERS THAT APPLY AND COVER SEED WITH SOIL.
- CULTIPACKING SEEDERS ARE REQUIRED TO BURY THE SEED IN SUCH A FASHION AS TO PROVIDE AT LEAST 1/4 INCH OF SOIL
- COVERING. SEEDBED MUST BE FIRM AFTER PLANTING. ii. APPLY SEED IN TWO DIRECTIONS, PERPENDICULAR TO EACH
- OTHER. APPLY HALF THE SEEDING RATE IN EACH DIRECTION. c. HYDROSEEDING: APPLY SEED UNIFORMLY WITH HYDROSEEDER (SLURRY INCLUDES SEED AND FERTILIZER).
- i. IF FERTILIZER IS BEING APPLIED AT THE TIME OF SEEDING, THE APPLICATION RATES SHOULD NOT EXCEED THE FOLLOWING: NITROGEN, 100 POUNDS PER ACRE TOTAL OF SOLUBLE NITROGEN; P2O5 (PHOSPHOROUS), 200 POUNDS PER ACRE; K2O (POTASSIUM), 200 POUNDS PER ACRE.
- ii. LIME: USE ONLY GROUND AGRICULTURAL LIMESTONE (UP TO 3 TONS PER ACRE MAY BE APPLIED BY HYDROSEEDING), NORMALLY NOT MORE THAN 2 TONS ARE APPLIED BY HYDROSEEDING AT ANY ONE TIME. DO NOT USE BURNT OR HYDRATED LIME WHEN HYDROSEEDING.
- iii. MIX SEED AND FERTILIZER ON SITE AND SEED IMMEDIATELY AND WITHOUT INTERRUPTION. iv. WHEN HYDROSEEDING DO NOT INCORPORATE SEED INTO THE SOIL.

B. MULCHING

- A MINIMUM OF 2 INCI LARGE AREAS, BUT I EQUIPMENT CAN OPI THIS PRACTICE SHO WOOD CELLULOSE F APPLY THE FIBER BII PER ACRE. MIX THE MAXIMUM OF 50 POU GALLONS OF WATER SYNTHETIC BINDERS iii. PETROSET, TERRA T EQUAL MAY BE USED
- BY THE MANUFACTU TO BE HEAVIER AT T SUCH AS IN VALLEYS BINDERS IS STRICTL LIGHTWEIGHT PLAST ACCORDING TO MAN USUALLY AVAILABLE

FEET LONG. **B-4-4 STANDAF** SPECIFICATIONS FOR TEMPORARY **STABILIZATION** 

TO STABILIZE DISTURBED SOILS WITH VEGETATION FOR UP TO 6 MONTHS. TO USE FAST GROWING VEGETATION THAT PROVIDES COVER ON DISTURBED

SOILS.

CONDITIONS WHERE PRACTICE APPLIES EXPOSED SOILS WHERE GROUND COVER IS NEEDED FOR A PERIOD OF 6 MONTHS OR LESS. FOR LONGER DURATION OF TIME, PERMANENT STABILIZATION PRACTICES ARE REQUIRED.

- REQUIRED FOR TEMPORARY SEEDING.

# TEMPORARY SEEDING SUMMARY

		HARDINES	S ZONE <u>7</u>	<u>A</u>		
SPECIES	APPLICATION RATE (LBS./AC.)	SEEDING DATES	SEEDING DEPTH	FERTILIZER RATE (10-20-20)	LIME RATE	
ANNUAL RYEGRASS	40 LBS./AC.	2/15 - 4/30 8/15 - 11/30	1⁄2"	436 LB./AC.	2 TONS/AC.	
FOXTAIL MILLET	30 LBS./AC.	5/1 - 8/14	1⁄2"	(10 LB./1000 S.F.)	(90 LB./1000 S.F.)	

	NOT	E.				NO
MULCHING	THE PUR	POSE OF THIS PLAN IS TO ADDRESS SE L FOR MASS GRADING, ROAD AND UTIL				S DESCRIPTION
<ol> <li>MULCH MATERIALS (IN ORDER OF PREFERENCE)         <ul> <li>a. STRAW CONSISTING OF THOROUGHLY THRESHED WHEAT, RYE,</li> </ul> </li> </ol>	CONSTR	UCTION ONLY. INDIVIDUAL OR COLLECT	IVE HOME/			NS DES(
OAT, OR BARLEY AND REASONABLY BRIGHT IN COLOR. STRAW IS TO BE FREE OF NOXIOUS WEED SEEDS AS SPECIFIED IN THE	SEPARA	E SEDIMENT CONTROL PLAN. THE PER/CONTRACTOR SHALL COMPLY WITH				REVISIONS
MARYLAND SEED LAW AND NOT MUSTY, MOLDY, CAKED, DECAYED, OR EXCESSIVELY DUSTY. NOTE: USE ONLY STERILE STRAW MULCH	STABILIZ	ATION REQUIREMENTS OF THIS PLAN. T	TEMPORARY			REV
IN AREAS WHERE ONE SPECIES OF GRASS IS DESIRED. b. WOOD CELLULOSE FIBER MULCH (WCFM) CONSISTING OF		D COUNTY DPW.	0 17 12 01 111	_		
SPECIALLY PREPARED WOOD CELLULOSE PROCESSED INTO A UNIFORM FIBROUS PHYSICAL STATE.		T PROTECTION NOT				DATE
<ul> <li>WCFM IS TO BE DYED GREEN OR CONTAIN A GREEN DYE IN THE PACKAGE THAT WILL PROVIDE AN APPROPRIATE COLOR TO</li> </ul>		CONTRACTOR IS REQUIRED TO INSTAL TECTION ON ALL STORM DRAIN INLETS		ANCE		DA
FACILITATE VISUAL INSPECTION OF THE UNIFORMLY SPREAD SLURRY.	WITH PLAN	I THE APPROVED EROSION & SEDIMEN IS.	T AND CONT	ROL		
<ul> <li>WCFM, INCLUDING DYE, MUST CONTAIN NO GERMINATION OR GROWTH INHIBITING FACTORS.</li> </ul>		NLET PROTECTION WILL BE INSTALLED				NO.
iii. WCFM MATERIALS ARE TO BE MANUFACTURED AND PROCESSED IN SUCH A MANNER THAT THE WOOD CELLULOSE	STAN	INSPECTOR IN ACCORDANCE WITH THE NDARDS AND SPECIFICATIONS FOR SOI	L EROSION /			
FIBER MULCH WILL REMAIN IN UNIFORM SUSPENSION IN WATER UNDER AGITATION AND WILL BLEND WITH SEED, FERTILIZER	PRO	MENT CONTROL. THE REMOVAL OF AN TECTION DEVICES WILL REQUIRE APPR		THE		
AND OTHER ADDITIVES TO FORM A HOMOGENEOUS SLURRY. THE MULCH MATERIAL MUST FORM A BLOTTER-LIKE GROUND						
COVER, ON APPLICATION, HAVING MOISTURE ABSORPTION AND PERCOLATION PROPERTIES AND MUST COVER AND HOLD		ITY NOTES				
GRASS SEED IN CONTACT WITH THE SOIL WITHOUT INHIBITING THE GROWTH OF THE GRASS SEEDLINGS.	TRE	TRACTOR SHOULD OPEN ONLY THAT S NCH THAT CAN BE BACKFILLED AND ST H DAY. IF TRENCH MUST REMAIN OPEN	ABILIZED			
iv. WCFM MATERIAL MUST NOT CONTAIN ELEMENTS OR COMPOUNDS AT CONCENTRATION LEVELS THAT WILL BE PHYTO-TOXIC.	THA	N ONE DAY, SILT FENCE SHALL BE PLAC				
<ul> <li>WCFM MUST CONFORM TO THE FOLLOWING PHYSICAL REQUIREMENTS: FIBER LENGTH OF APPROXIMATELY 10</li> </ul>	2. PLA	VNSLOPE) THE TRENCH. CE ALL EXCAVATED MATERIAL ON UPHI NCH.	LL SIDE OF			
MILLIMETERS, DIAMETER APPROXIMATELY 1 MILLIMETER, PH RANGE OF 4.0 TO 8.5, ASH CONTENT OF 1.6 PERCENT MAXIMUM AND WATER	3. ANY	SEDIMENT CONTROL DISTURBED BY U STRUCTION IS TO BE REPAIRED IMMED				
HOLDING CAPACITY OF 90 PERCENT MINIMUM. 2. APPLICATION				_		
a. APPLY MULCH TO ALL SEEDED AREAS IMMEDIATELY AFTER SEEDING.		PORARY STOCKPILE ARY STOCKPILES SHALL BE LOCATED V		<b>_</b>		
b. WHEN STRAW MULCH IS USED, SPREAD IT OVER ALL SEEDED AREAS AT THE RATE OF 2 TONS PER ACRE TO A UNIFORM LOOSE DEPTH OF	LIMIT OF	DISTURBANCE, DRAIN TO A FUNCTIONI L DEVICE, AND POSITIONED SO AS NOT	NG SEDIMEN			
1 TO 2 INCHES. APPLY MULCH TO ACHIEVE A UNIFORM DISTRIBUTION AND DEPTH SO THAT THE SOIL SURFACE IS NOT	UPON OF	R IMPAIR THE FUNCTION OF SAID DEVIC LE SHALL NOT ALTER THE DRAINAGE D	E. THE			
EXPOSED. WHEN USING A MULCH ANCHORING TOOL, INCREASE THE APPLICATION RATE TO 2.5 TONS PER ACRE.		PORARY SWALE NO				
c. WOOD CELLULOSE FIBER USED AS MULCH MUST BE APPLIED AT A NET DRY WEIGHT OF 1500 POUNDS PER ACRE. MIX THE WOOD CELLULOSE FIBER WITH WATER TO ATTAIN A MIXTURE WITH A	TEMPOR	ARY SWALE SHALL BE LOCATED WITHIN		 DF		
MAXIMUM OF 50 POUNDS OF WOOD CELLULOSE FIBER PER 100 GALLONS OF WATER.						
<ul> <li>a. PERFORM MULCH ANCHORING IMMEDIATELY FOLLOWING</li> </ul>		NTENANCE NOTE				
APPLICATION OF MULCH TO MINIMIZE LOSS BY WIND OR WATER. THIS MAY BE DONE BY ONE OF THE FOLLOWING METHODS (LISTED	SUPER S	CTOR SHALL INSPECT AND MAINTAIN AI	EVICES AFTE	R		
BY PREFERENCE), DEPENDING UPON THE SIZE OF THE AREA AND EROSION HAZARD:		ORM EVENT. MAINTENANCE SHALL INC ED TO REMOVAL OF ALL ACCUMULATEE				J
i. A MULCH ANCHORING TOOL IS A TRACTOR DRAWN IMPLEMENT DESIGNED TO PUNCH AND ANCHOR MULCH INTO THE SOIL SURFACE	NPD	ES NOTE				In N
A MINIMUM OF 2 INCHES. THIS PRACTICE IS MOST EFFECTIVE ON LARGE AREAS, BUT IS LIMITED TO FLATTER SLOPES WHERE	IT IS THE	CONTRACTOR'S RESPONSIBILITY TO IN PROVISIONS AND REQUIREMENTS OF TH		LL		ee ee
EQUIPMENT CAN OPERATE SAFELY. IF USED ON SLOPING LAND, THIS PRACTICE SHOULD FOLLOW THE CONTOUR.	PERMIT.					sociates Enginee
ii. WOOD CELLULOSE FIBER MAY BE USED FOR ANCHORING STRAW. APPLY THE FIBER BINDER AT A NET DRY WEIGHT OF 750 POUNDS	ESC	GENERAL NOTES				
PER ACRE. MIX THE WOOD CELLULOSE FIBER WITH WATER AT A MAXIMUM OF 50 POUNDS OF WOOD CELLULOSE FIBER PER 100		RENCH MUST REMAIN OPEN LONGER TH FENCE SHALL BE PLACED BELOW (DOV		,		
GALLONS OF WATER. iii. SYNTHETIC BINDERS SUCH AS ACRYLIC DLR (AGRO-TACK), DCA-70,	THE	TRENCH.	,			I < Ξ
PETROSET, TERRA TAX II, TERRA TACK AR OR OTHER APPROVED EQUAL MAY BE USED. FOLLOW APPLICATION RATES AS SPECIFIED		CE ALL EXCAVATED MATERIAL ON UPHI NCH.	LL SIDE OF			ipe onsu
BY THE MANUFACTURER. APPLICATION OF LIQUID BINDERS NEEDS TO BE HEAVIER AT THE EDGES WHERE WIND CATCHES MULCH,	3. ANY	SEDIMENT CONTROL DISTURBED BY U	TILITY			נק א
SUCH AS IN VALLEYS AND ON CRESTS OF BANKS. USE OF ASPHALT BINDERS IS STRICTLY PROHIBITED.	CON	STRUCTION IS TO BE REPAIRED IMMED	DIATELY.			
iv. LIGHTWEIGHT PLASTIC NETTING MAY BE STAPLED OVER THE MULCH ACCORDING TO MANUFACTURER RECOMMENDATIONS. NETTING IS	HYD	ROLOGIC SOIL GRO	<u>UP RA</u>	TING		
USUALLY AVAILABLE IN ROLLS 4 TO 15 FEET WIDE AND 300 TO 3,000 FEET LONG.	SYMBOL BeA	NAME BELTSVILLE SILT LOAM	% SLOPE 0-2	RATING C	]	
B-4-4 STANDARDS AND	BeB	BELTSVILLE SILT LOAM	0-2 2-5	C C		WO
SPECIFICATIONS FOR TEMPORARY	ChB2	CHILLIUM SILT LOAM	2-5	С		H

1. SELECT ONE OR MORE OF THE SPECIES OR SEED MIXTURES LISTED IN TABLE B.1 FOR THE APPROPRIATE PLANT HARDINESS ZONE (FROM FIGURE / B.3), AND ENTER THEM IN THE TEMPORARY SEEDING SUMMARY BELOW ALONG WITH APPLICATION RATES, SEEDING DATES AND SEEDING DEPTHS. IF THIS SUMMARY IS NOT PUT ON THE PLAN AND COMPLETED, THEN TABLE B.1 PLUS FERTILIZER AND LIME RATES MUST BE PUT ON THE PLAN. 2. FOR SITES HAVING SOIL TESTS PERFORMED, USE AND SHOW THE RECOMMENDED RATES BY THE TESTING AGENCY. SOIL TESTS ARE NOT

3. WHEN STABILIZATION IS REQUIRED OUTSIDE OF A SEEDING SEASON. APPLY SEED AND MULCH OR STRAW MULCH ALONE AS PRESCRIBED IN SECTION B-4-3.A.1.B AND MAINTAIN UNTIL THE NEXT SEEDING SEASON.

# JQTALSIJE AREA: 26466 AC TOTAL DISTURBED AREA: 251,481 SF (5.60 AC) 4) 3 AREADOBE PAVED 239 SE

CkC2

EN

(4. AREA TO BE STABILIZED: 252,481 SF (5.60 AC) 1,547,800

CHILLIUM-NESHAMINY SILT LOAM

ELKTON SILT LOAM

**OWNER INFORMATION** 

OWNER/DEVELOPER:

SITE ANALYSIS

CONTACT:

3. ADDRESS:

4. PHONE:

5-10

-

BOARD OF EDUCATION OF HARFORD COUNTY

В

C/D

NPDES ID PT. NORTHING: EASTING: 674,500

\*TO THE EXTENT THAT QUANTITIES MAY BE LISTED ON THESE PLANS, THEY ARE FOR PERMITTING PURPOSES ONLY AND NOT FOR BIDDING PURPOSES. CONTRATOR SHALL FORM HIS OWN CONCLUSIONS ABOUT THE QUANTITIES OF ALL MATERIALS AND OPERATIONS NECESSARY TO COMPLETE THE PROJECT.

HARRY MILLER

410-838-7300

102 S. HICKORY AVE.

BEL AIR, MD 21014





PROJECT


MANAGER


DATE


လ


NOTE

ESC

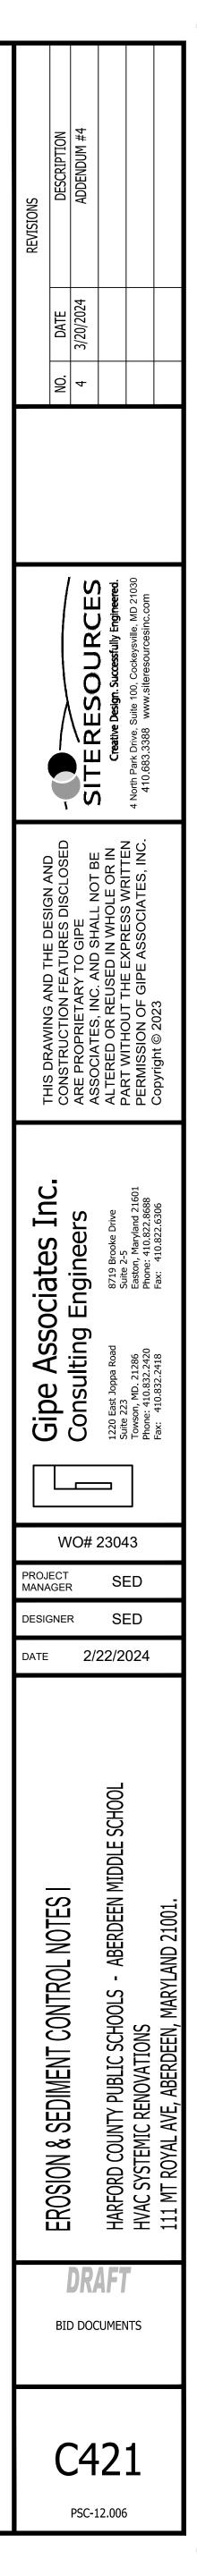

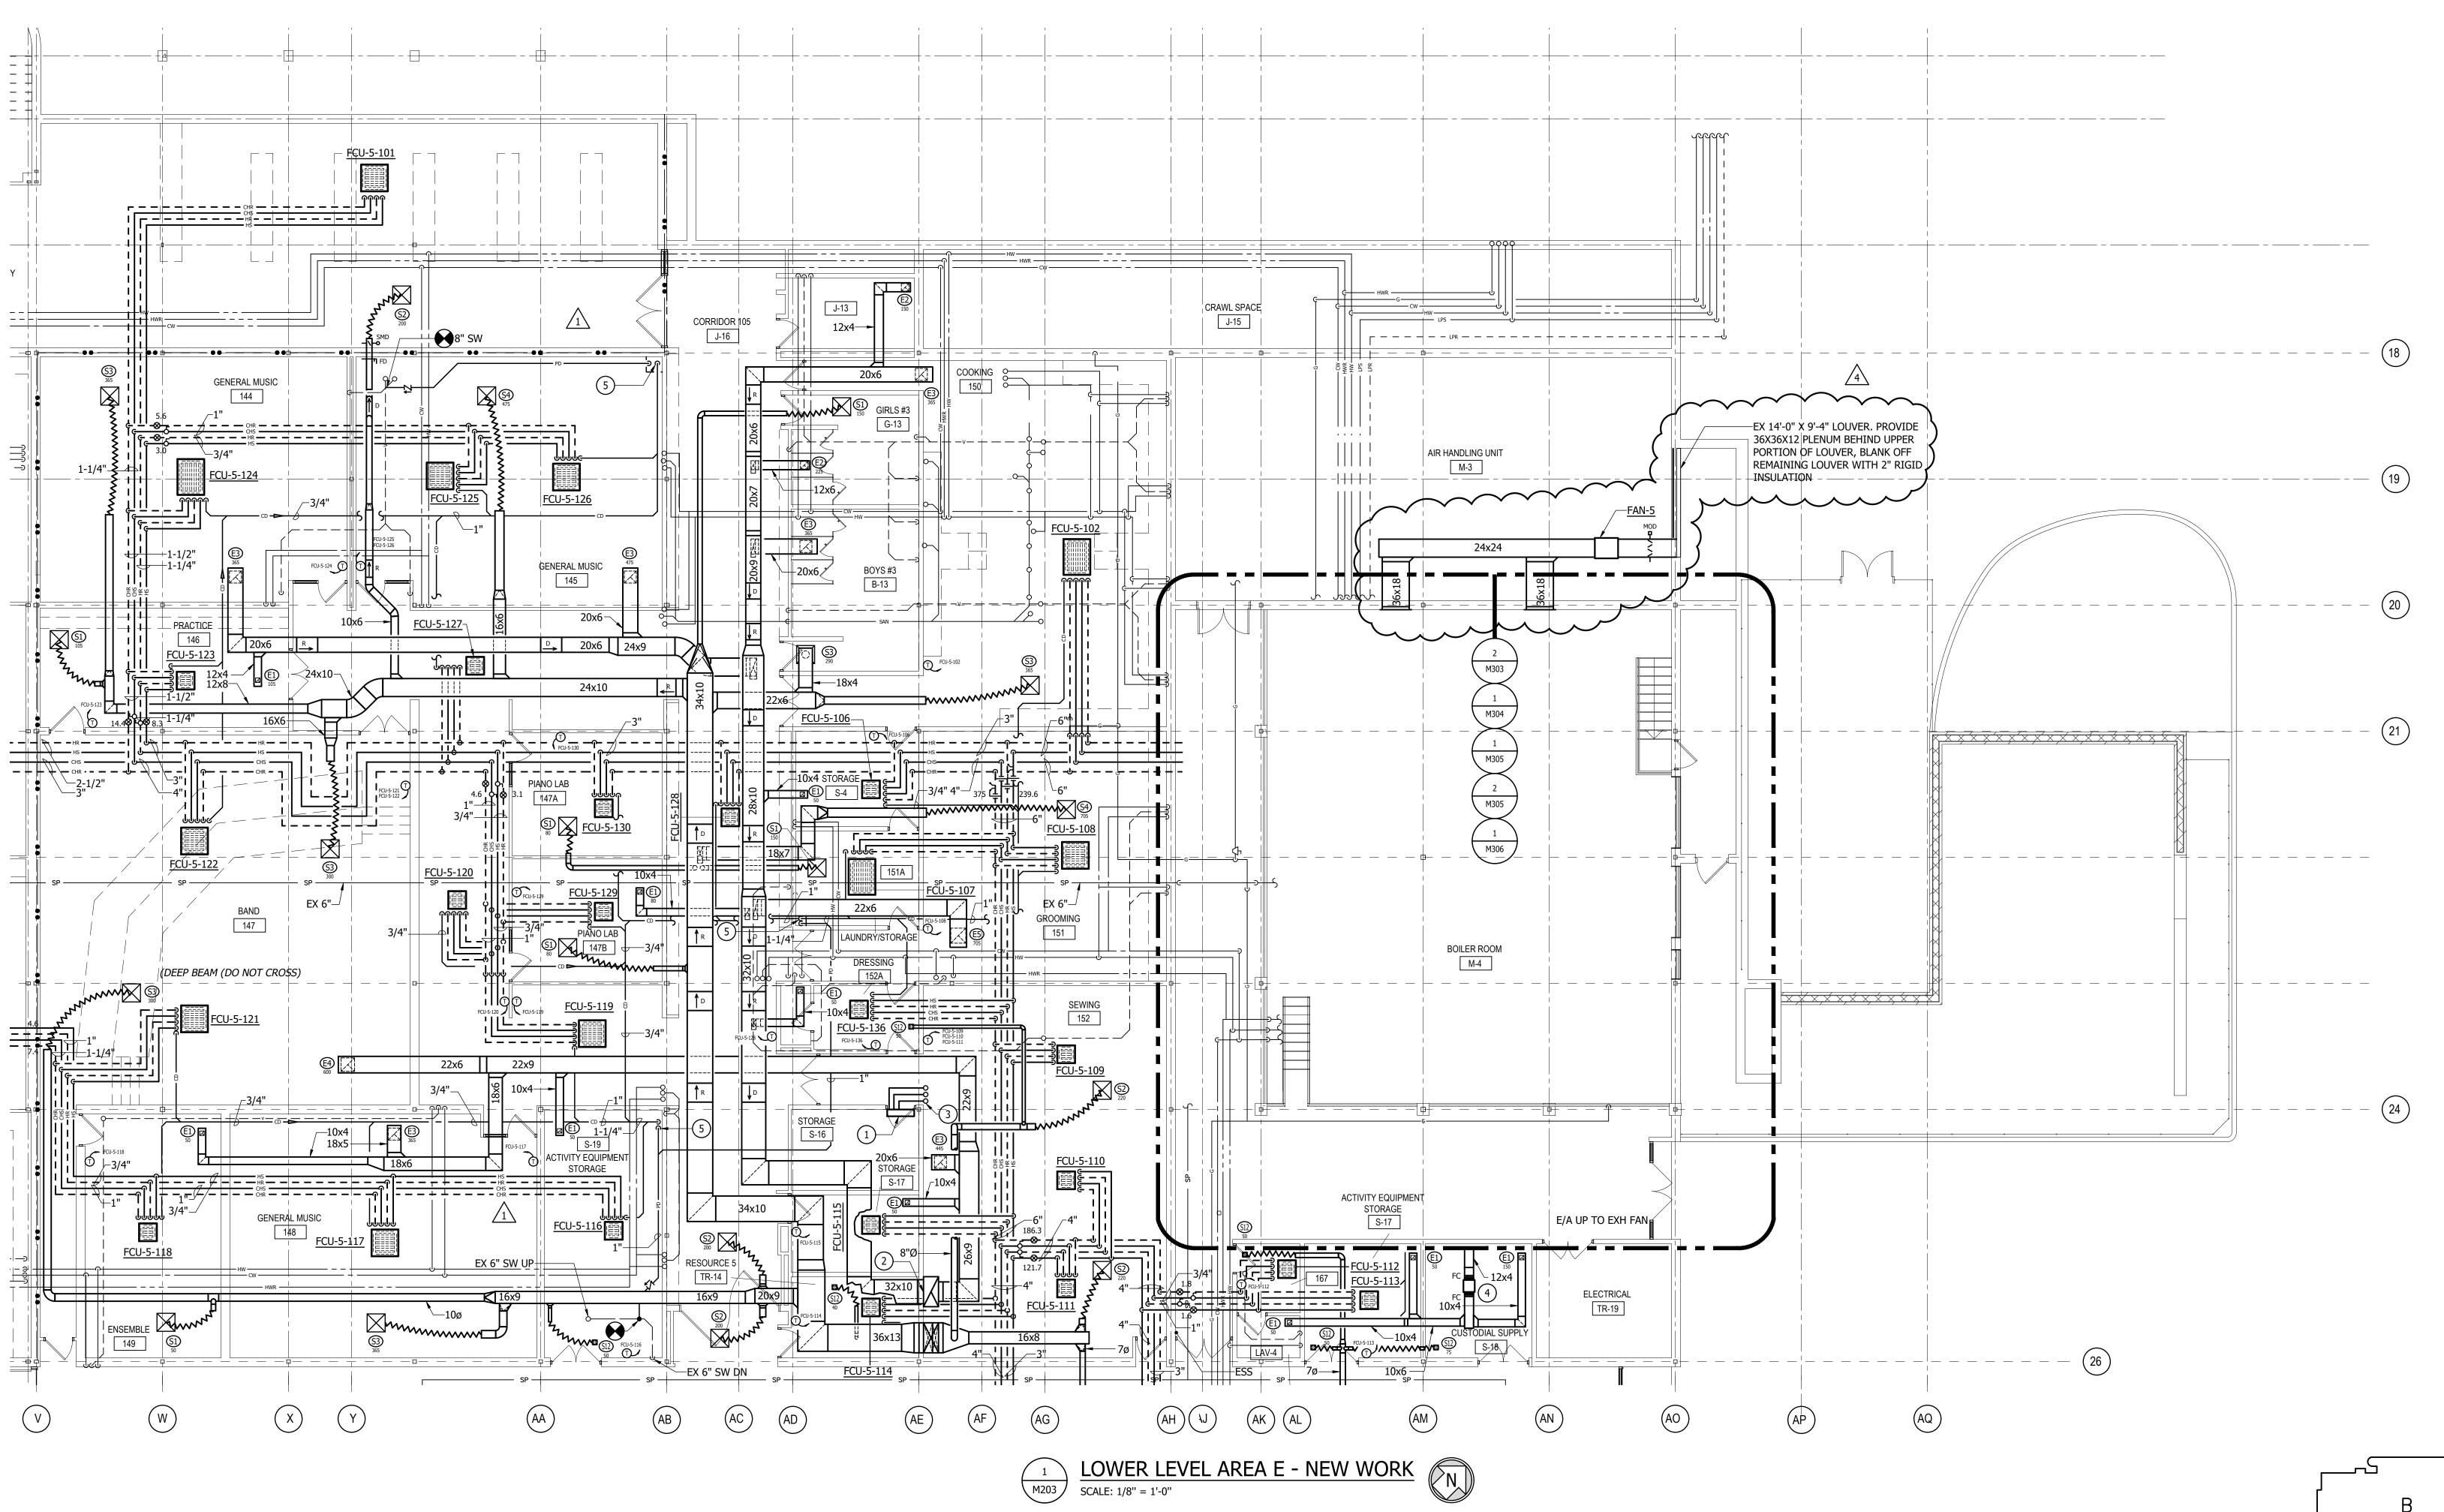


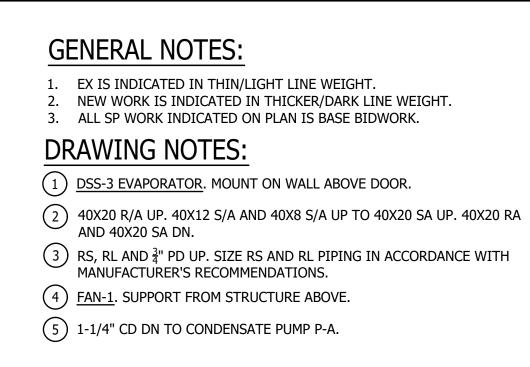


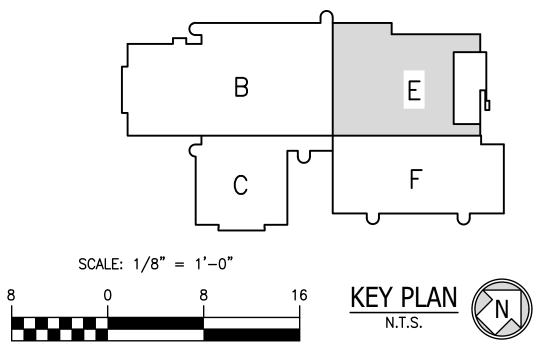


T. LINE WEIGHT. IDWORK.
IDWORK.

			DESIG DATE	PROJE MANAG		T Gine Accoriates Inc	THIS DRAWING AND THE DESIGN AND		RE	REVISIONS
•	BID	LOWER LEVEL AREA E - NEW WORK	NER	ECT	WC		CONSTRUCTION FEATURES DISCLOSED	2	JO. DATE	DESCRIPTION
-	) SU		2/		)# '	Consulting Engineers	ARE PROPRIETARY TO GIPE ASSOCIATES. INC. AND SHALL NOT BE	7	3/7/24	ADDENDUM NO. 1
20	BMIS	HARFORD COUNTY PUBLIC SCHOOLS - ABERDEEN MIDDLE SCHOOL	SE /26/	SE	2304	1220 East Joppa Road 8719 Brooke Drive Suite 223 Suite 2-5	ALTERED OR REUSED IN WHOLE OR IN	7	2 3/14/24	ADDENDUM NO. 2
	SION	HVAC SYSTEMIC RENOVATIONS	יש 202		] 43		PERMISSION OF GIPE ASSOCIATES, INC.	7	3/20/24	ADDENDUM NO. 3
		111 MT ROYAL AVE, ABERDEEN, MARYLAND 21001.	24			Fax: 410.832.2418 Fax: 410.822.6306	Copyright © 2023	7	4 3/27/24	ADDENDUM NO. 4

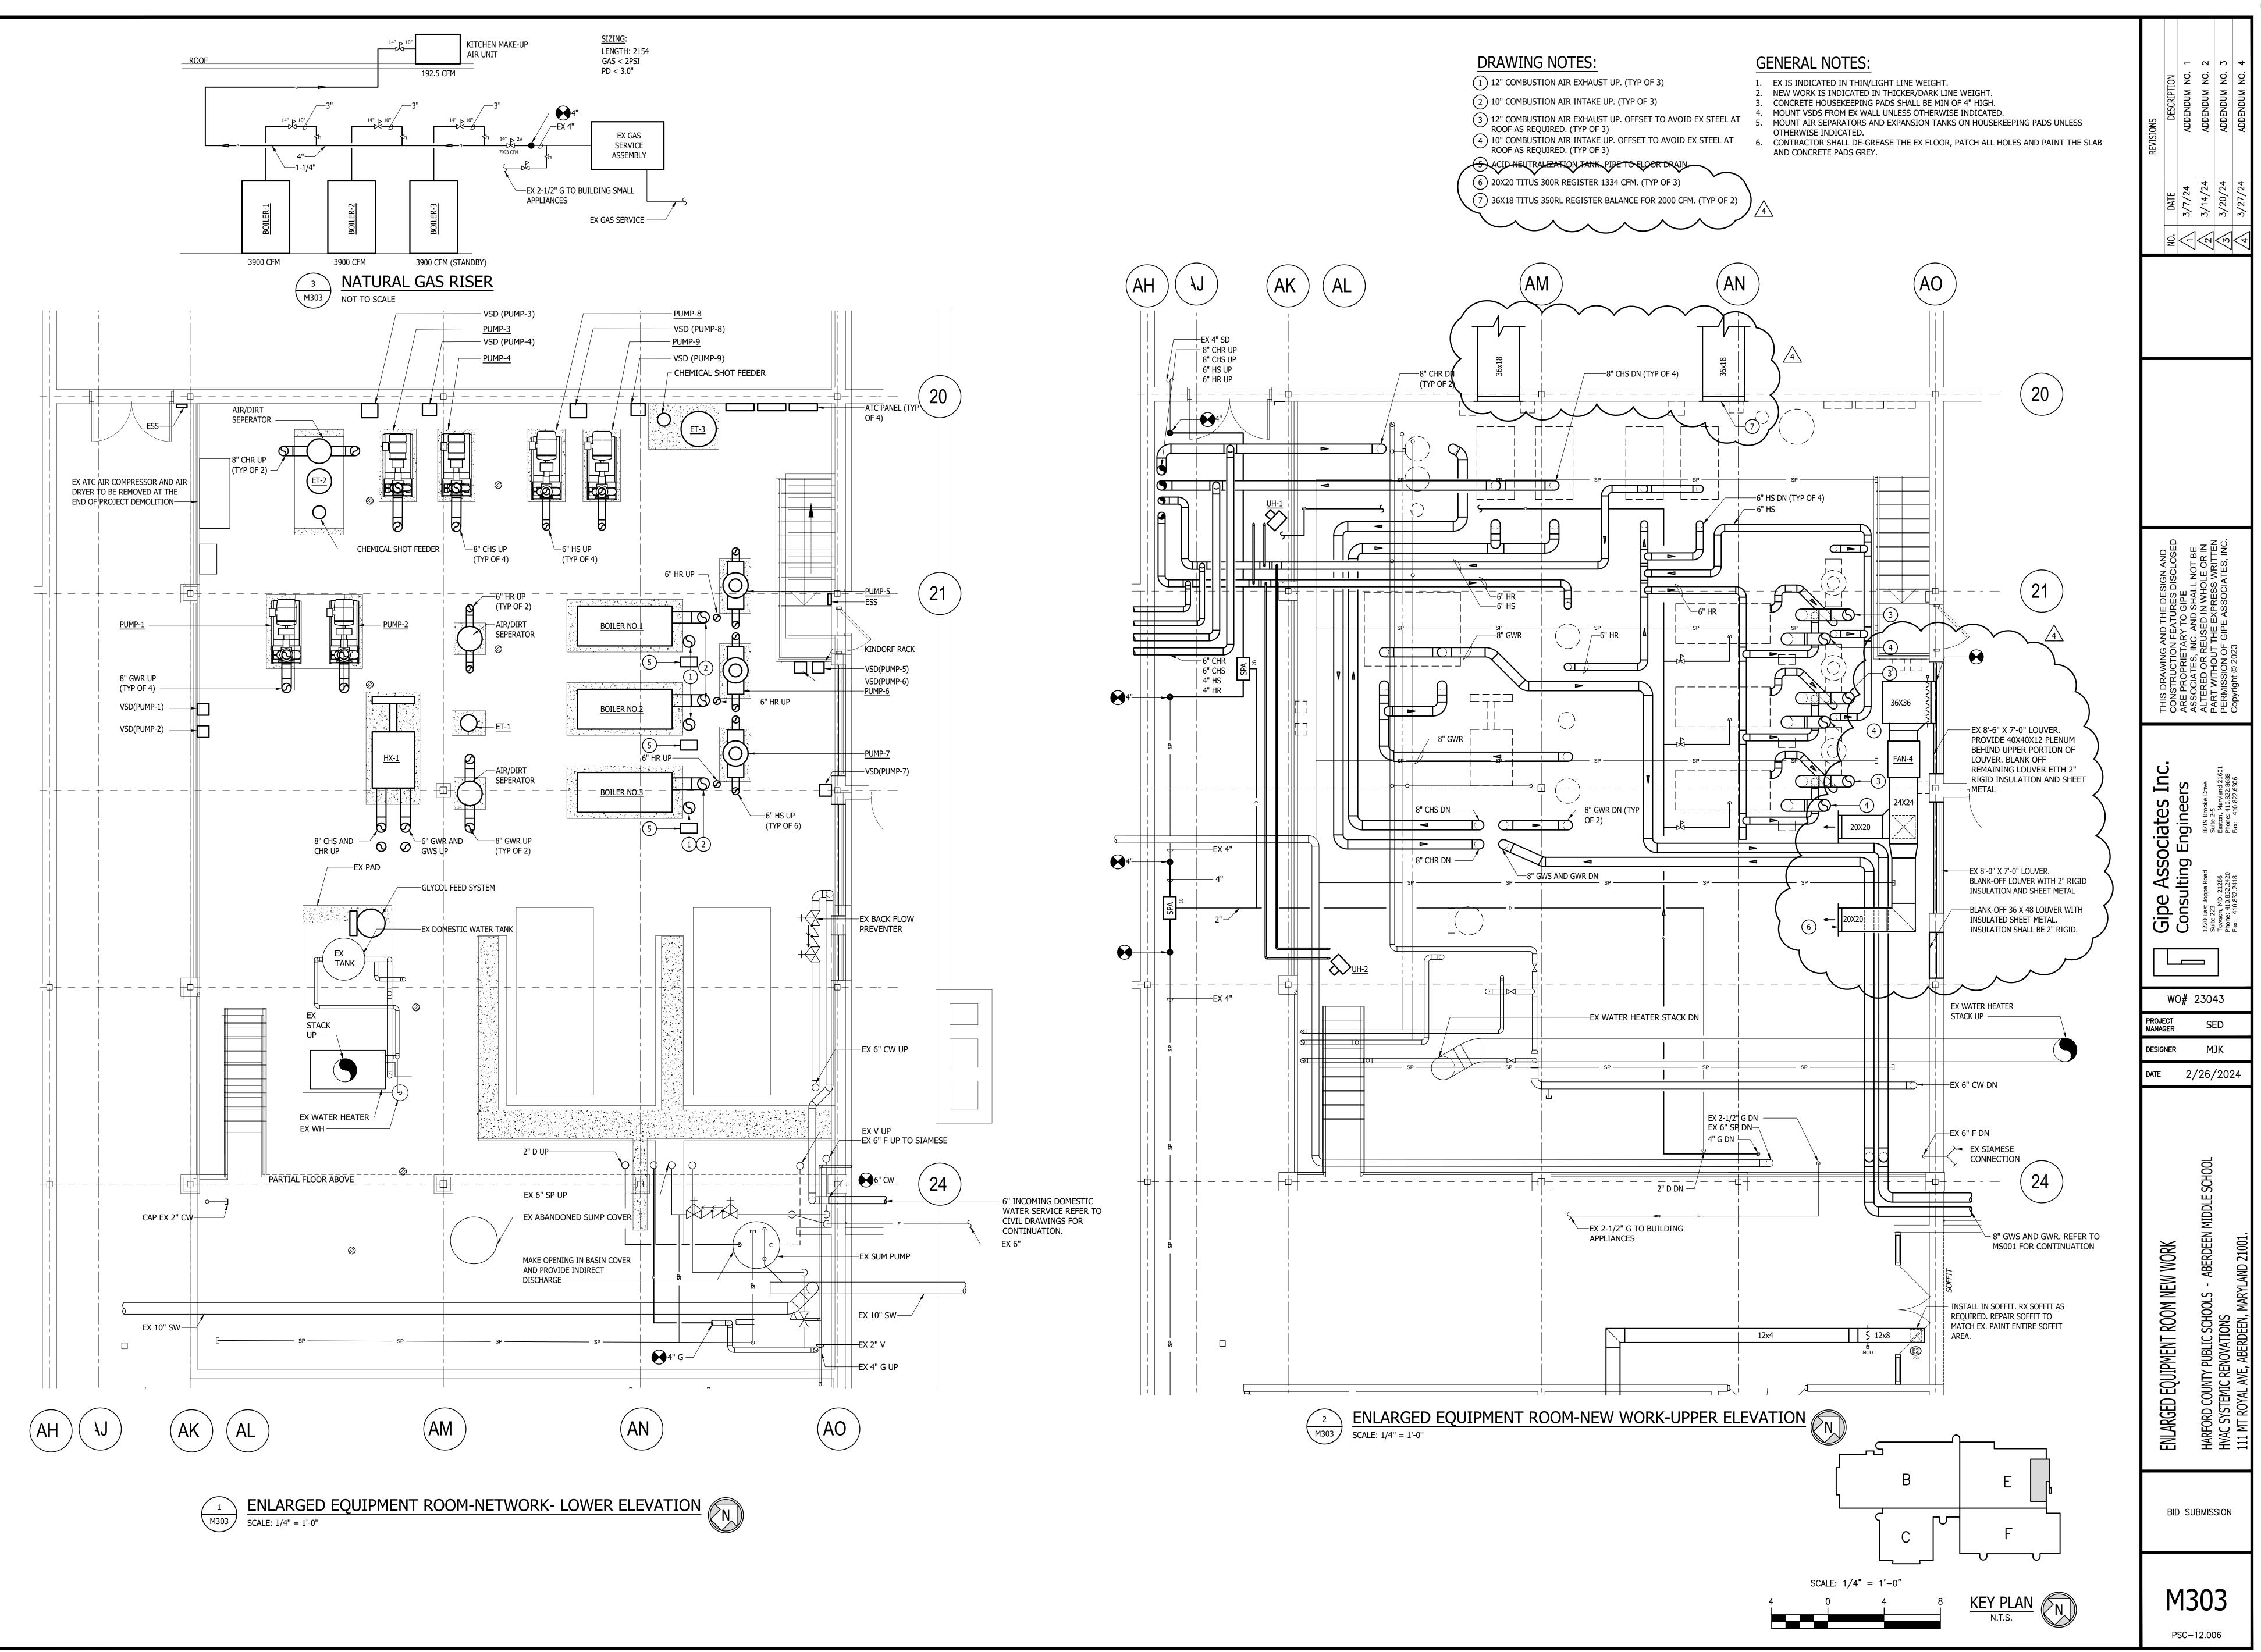


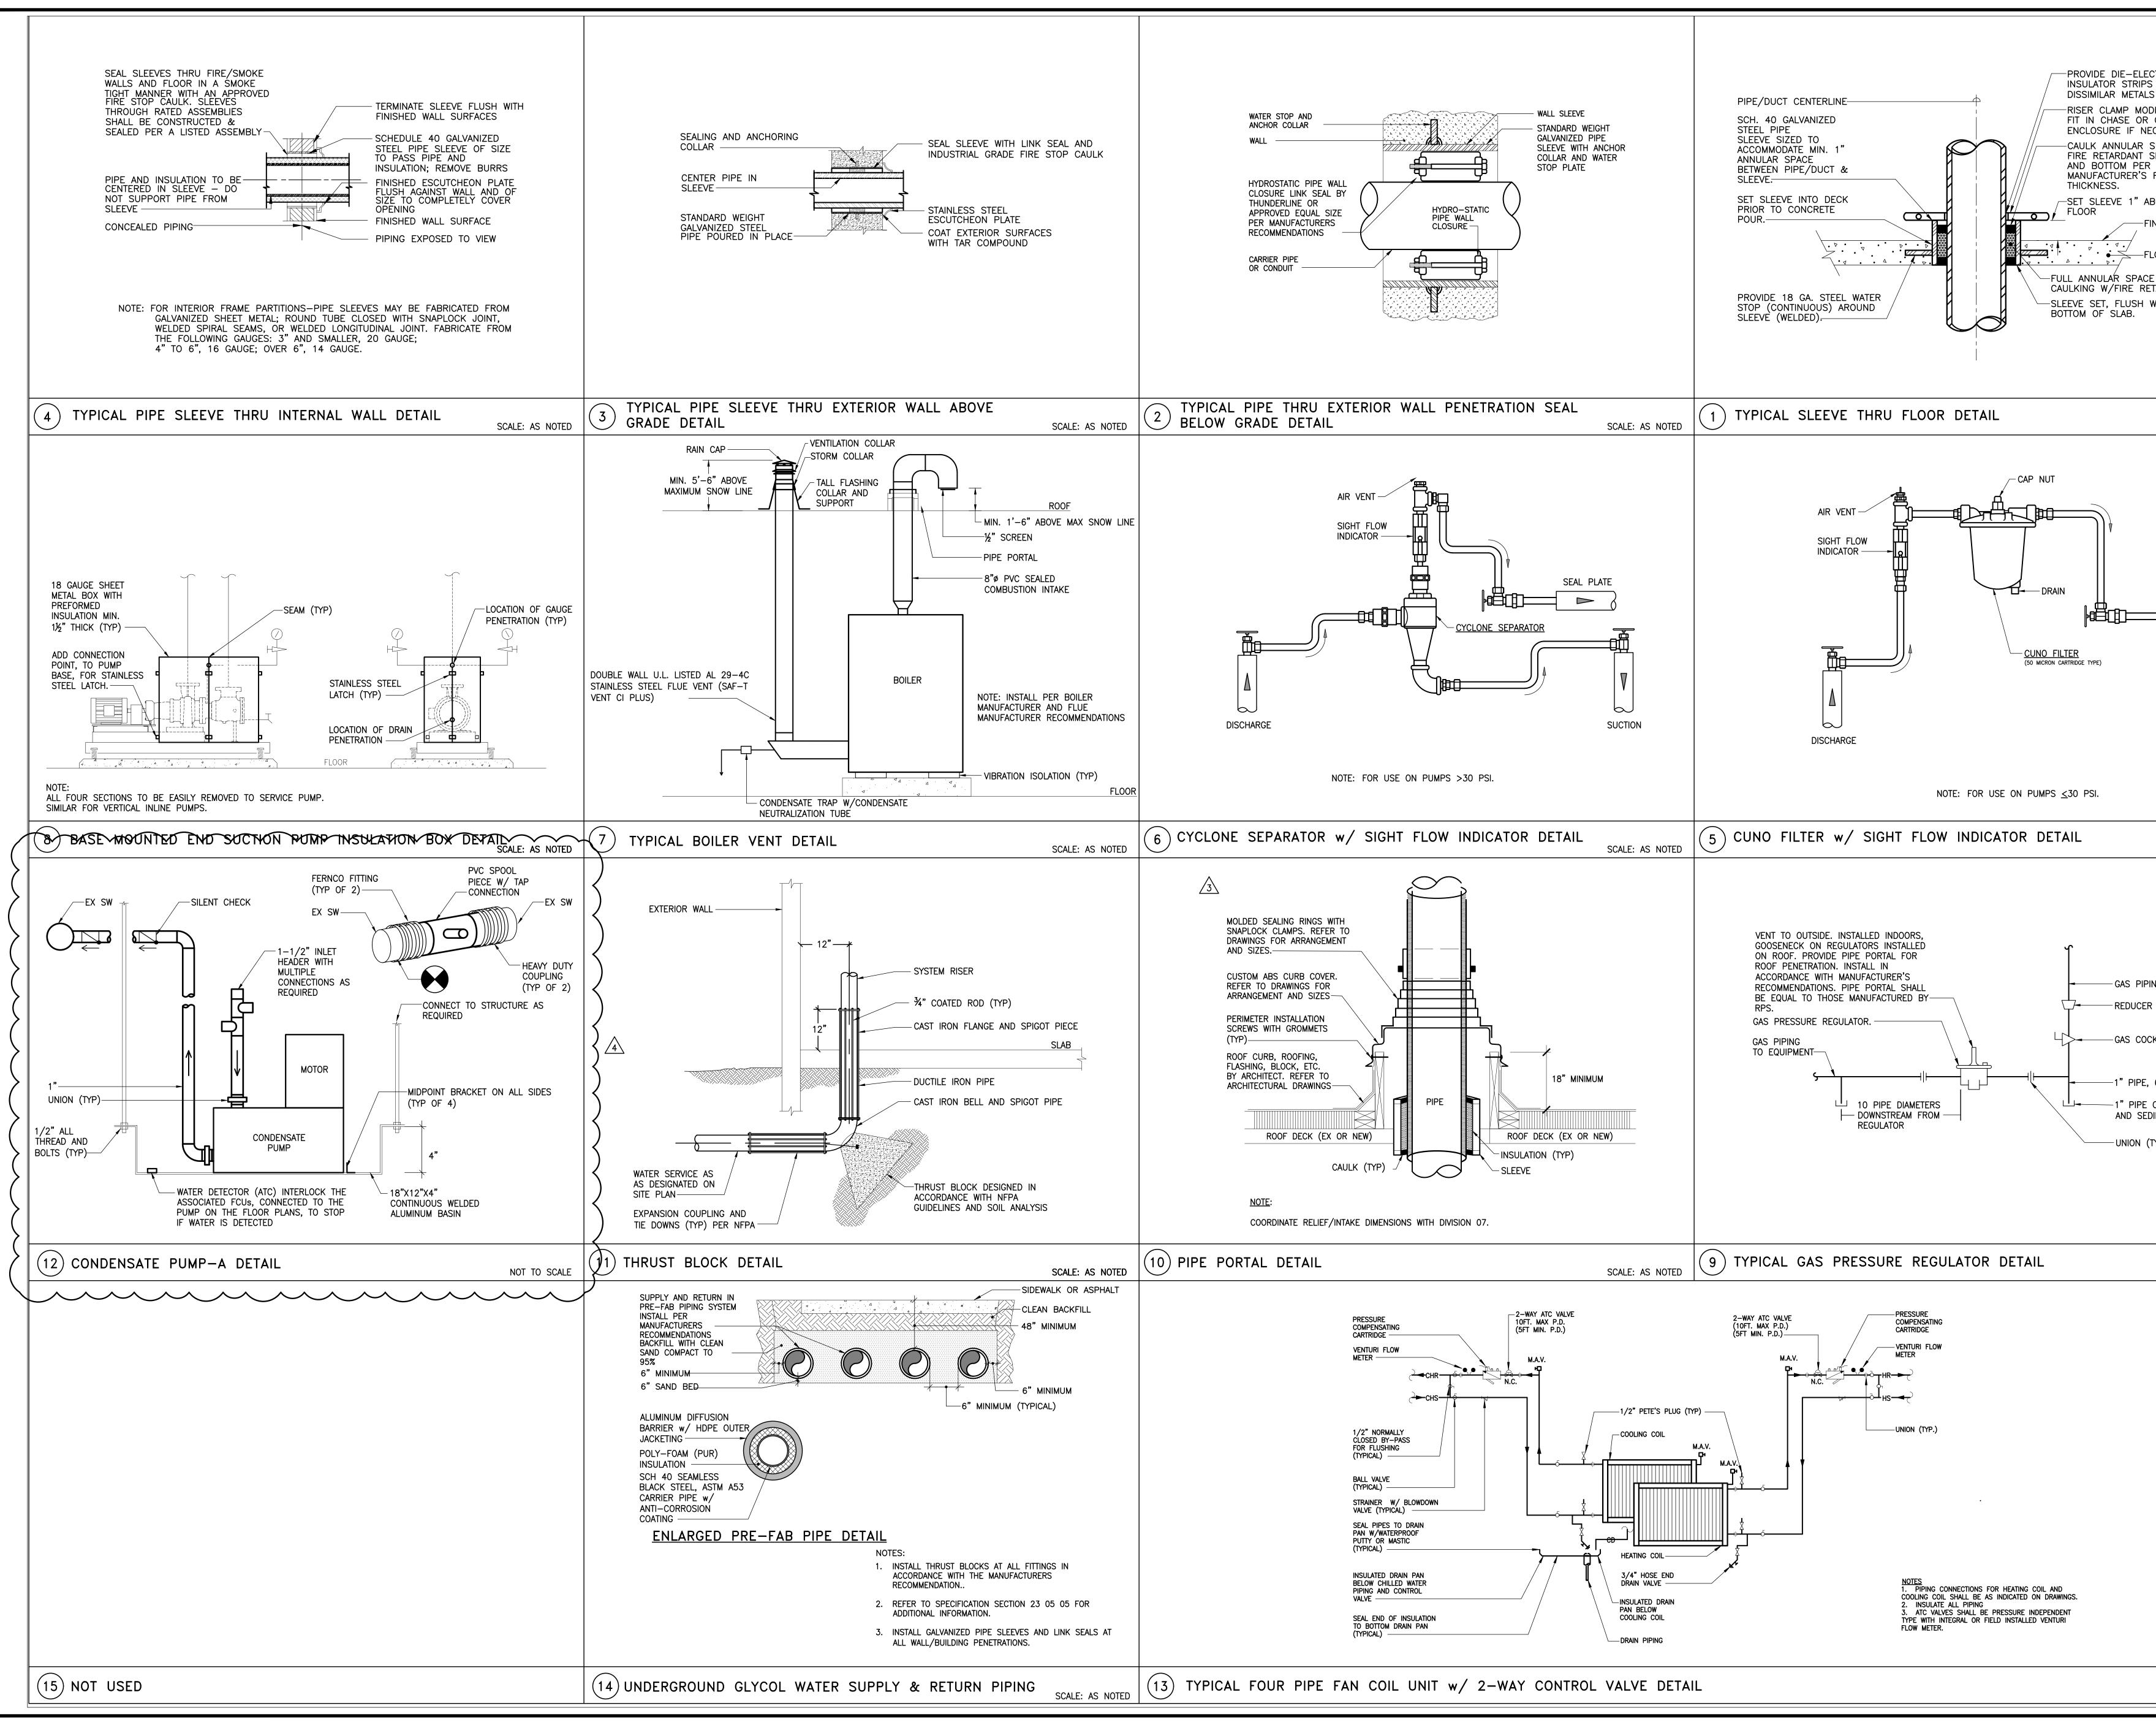

			-	2	ъ	4
CTRIC S IF S ARE USED		DESCRIPTION	ADDENDUM NO.	ADDENDUM NO.	ADDENDUM NO.	ADDENDUM NO. 4
DIFIED TO COLUMN ECESSARY	SNOIS	DES	ADDEN	ADDEN	ADDEN	ADDEN
SPACE WITH SEALER TOP	REVISIONS					
RECOMMENDED			24	/24	/24	/24
BOVE FINISHED		DATE	3/7/24	3/14/24	3/20/24	3/27/24
LOOR SLAB		9. S	$\overline{\langle}$	2	3	4
E BETWEEN						
WITH						
SCALE: AS NOTED						
	⊆	SED	ШШ	2 IN	INC.	
SEAL PLATE	DAWING AND THE DESIGN AND	CONSTRUCTION FEATURES DISCLOSED	ARE PROPRIETARY TO GIPE ASSOCIATES INC. AND SHALL NOT BE	ALTERED OR REUSED IN WHOLE OR IN	IISSION OF GIPE ASSOCIATES, INC.	
	не De 6	TURES	O GIPE		EAFRE ASSOC	
		ON FEA	TARY T INC. AN	REUSEI	DF GIPE	53
		RUCTIO	ROPRIE			ight © 2023
		CONST	ARE PF ASSOCI		PERMIS	Copyrigr
			-		- `	
		5			601 3	
	Gine Accoriates Inc		ers	ske Drive	Easton, Maryland 21601 Phone: 410.822.8688	410.822.6306
SCALE: AS NOTED	ate	יר רכ	Jgine	8719 Broc Suite 2-5	Easton, M Phone: 41	Fax: 410
			Consulting Engineers			
			sultin	oppa Road	D. 21286 832.2420	832.2418
	, in a	<u>کر</u> ا	Cons	1220 East Joppa Road Suite 223	Towson, MD. 21286 Phone: 410.832.2420	Fax: 410.
ING		T		ц о	,   	L.
R (IF REQUIRED)						
СК	PROJE	W(	D# 2	2304 SI		
6" LONG	PROJE MANAG DESIG				ED EE	
CAP FOR TEST DIMENT TRAP	DATE		2/		/202	24
TYP)						
				HOOL		
				<b>DLE SC</b>		
SCALE: AS NOTED				EN MID		<u>]</u> 1.
				<b>\BERDE</b>		L AVE, ABERDEEN, MARYLAND 21001
				NUNTY PUBLIC SCHOOLS - ABERDEEN MIDDLE SCHOOL		<b>IARYLA</b>
				, SCHOC	IONS	<b>JEEN, M</b>
				PUBLIC	FNOVAT	, ABERL
				YDUNTY	HVAC SYSTEMIC RENOVATIONS	'AL AVE,
		) - I AI S	)   :	FORD C	C SYSTE	MT ROY
		)- _	 	HAR	HVA(	111
	┢					
		BIC	) SU	BMIS	SION	
		M	17	'0	5	

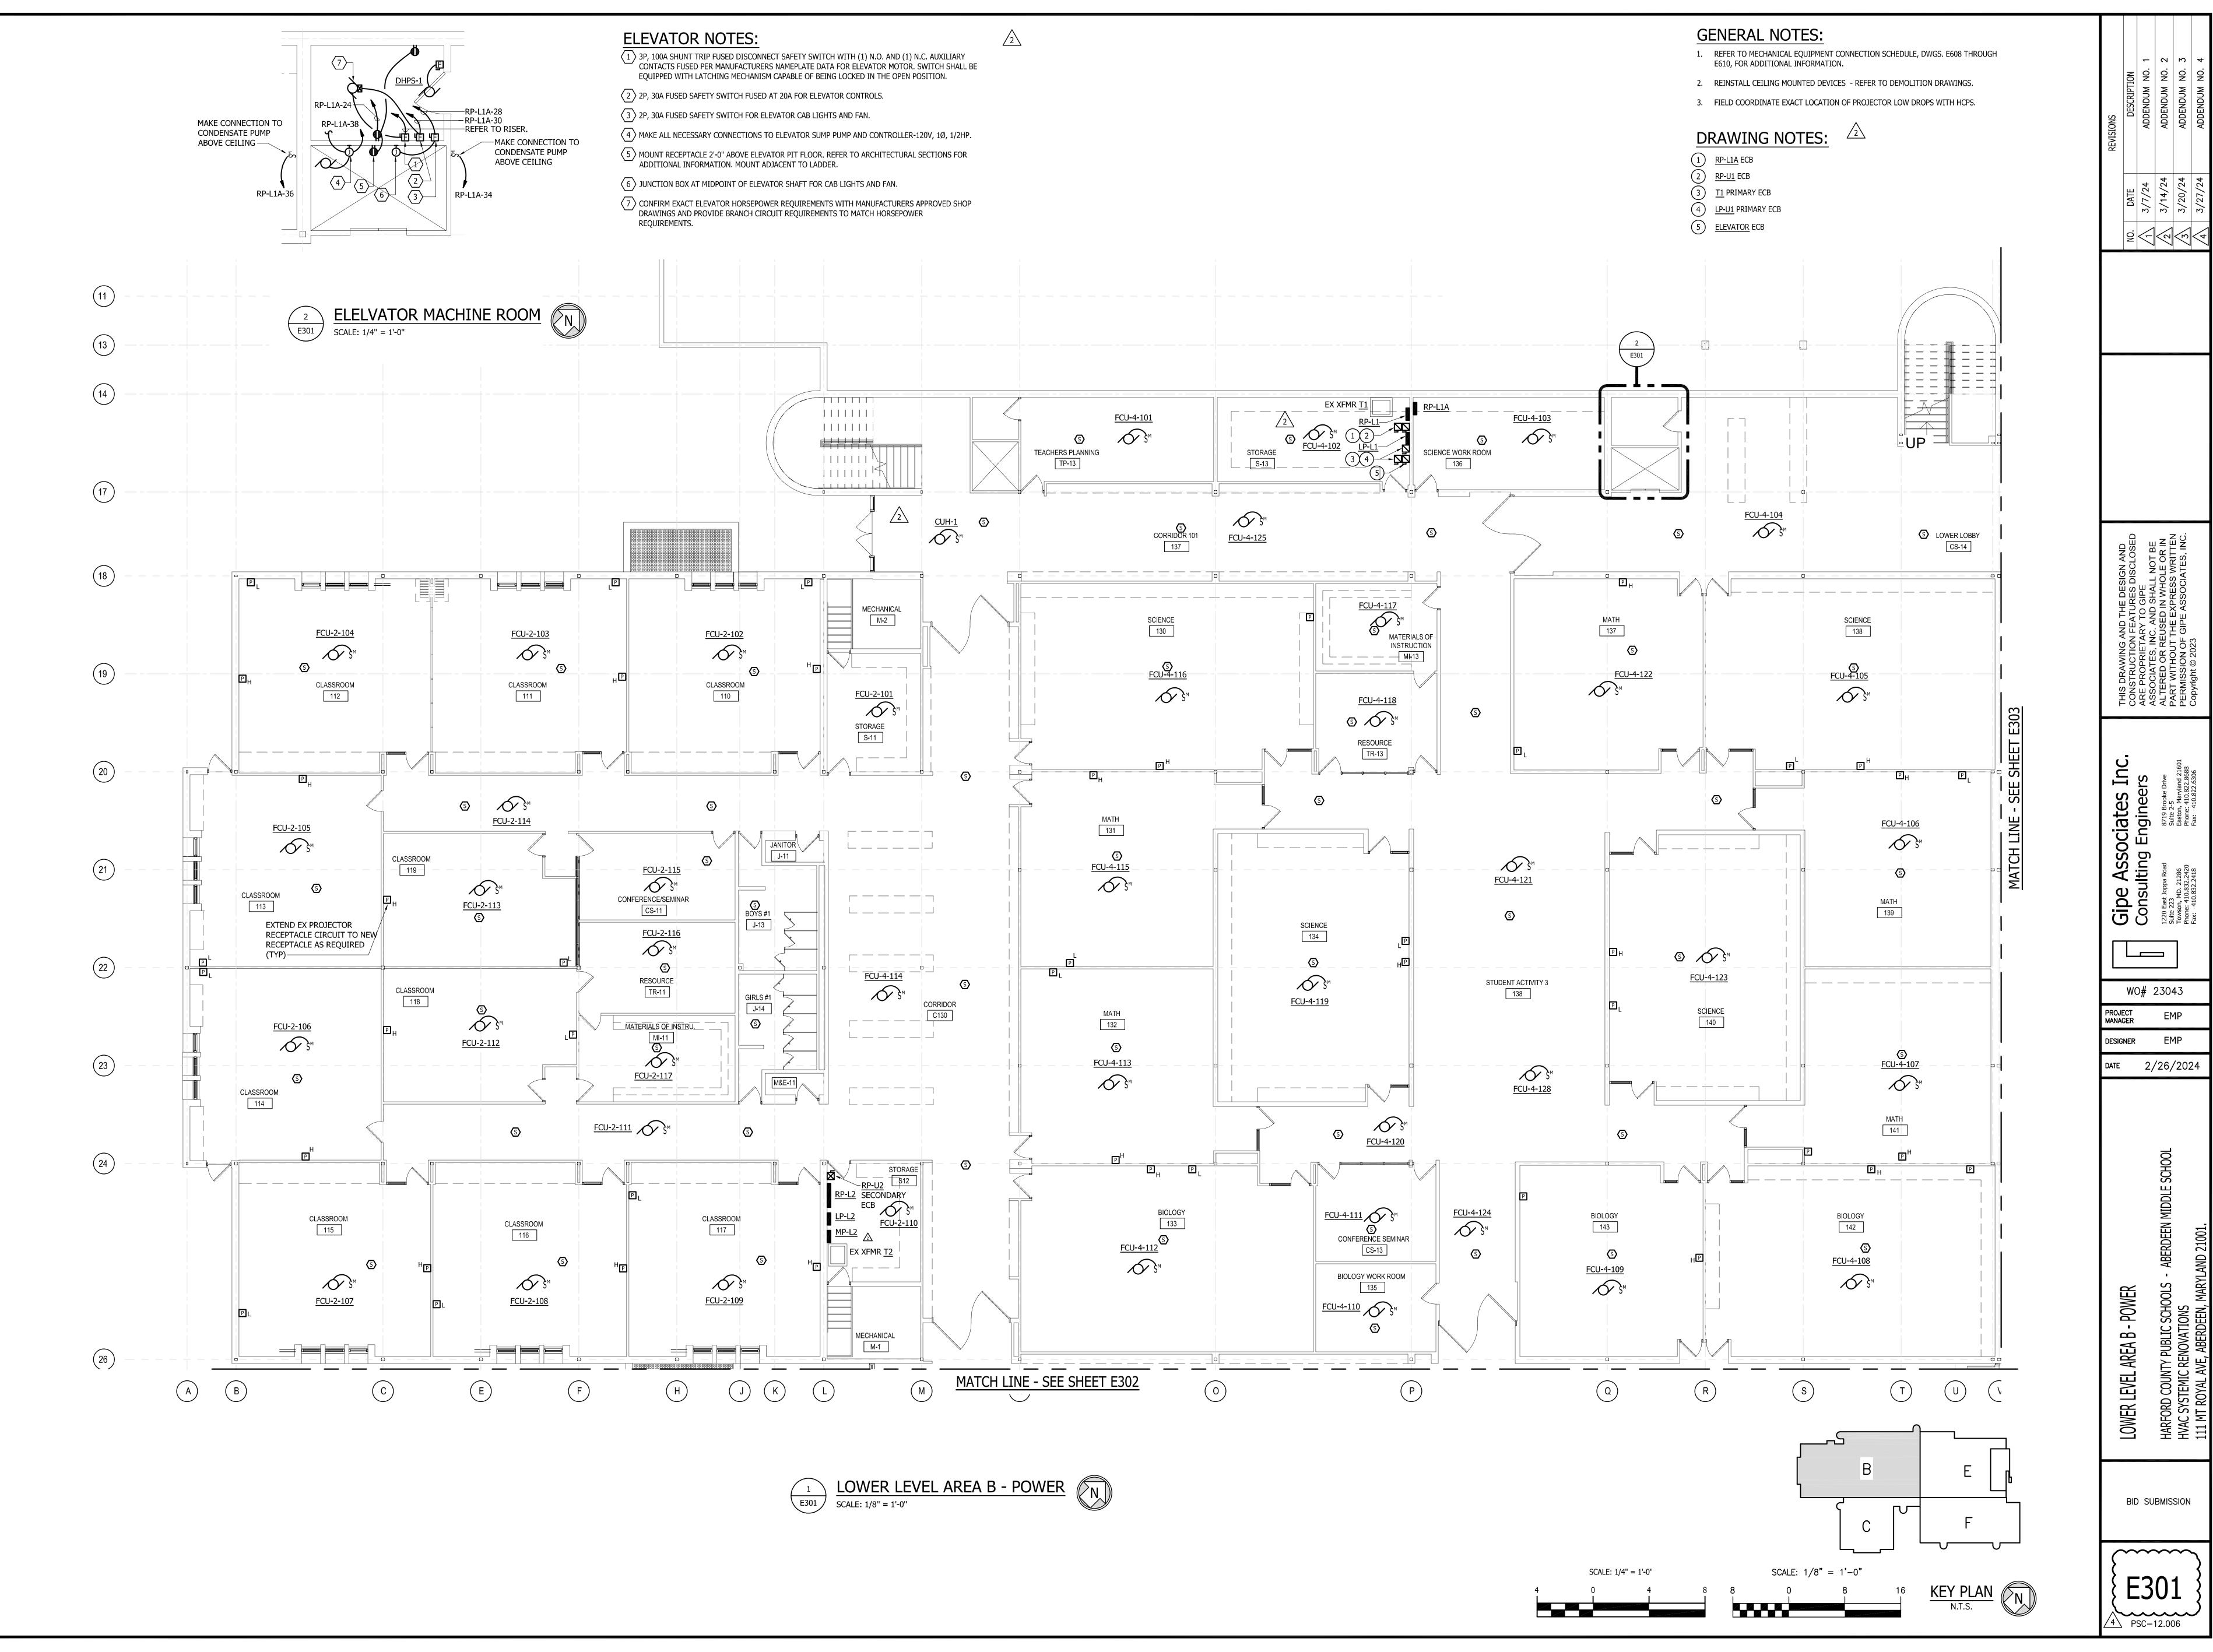



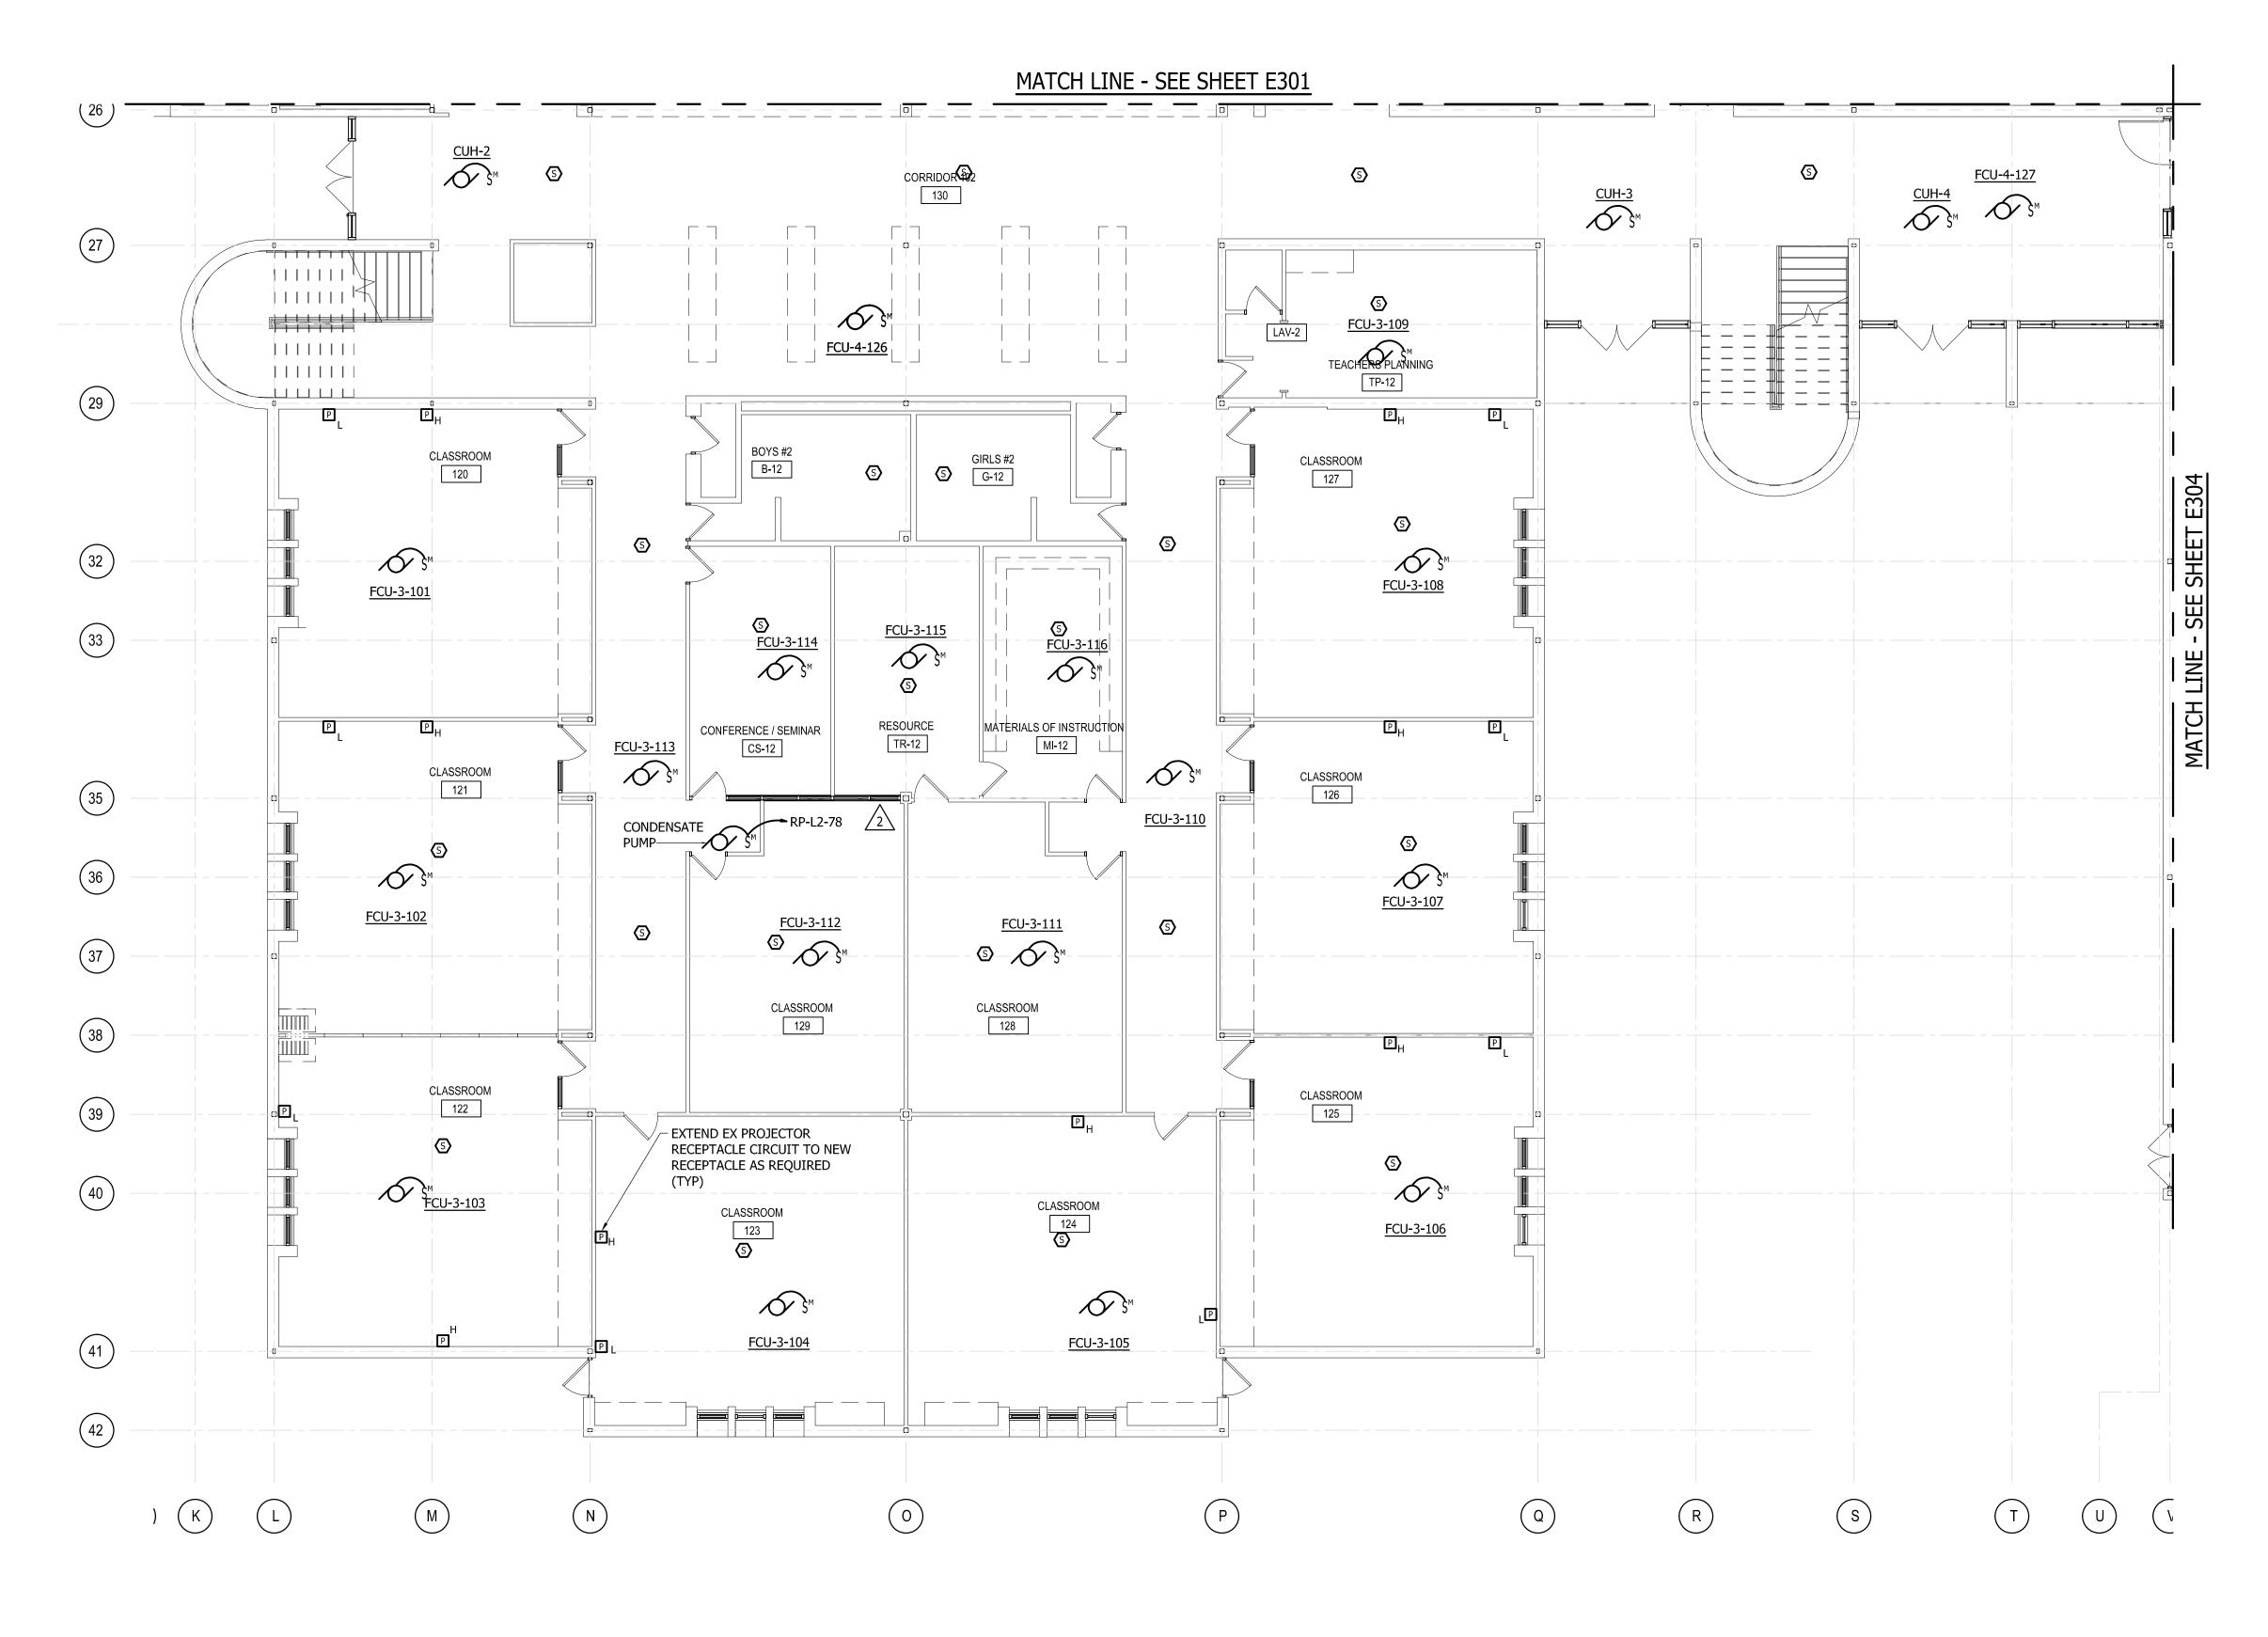





 $\begin{array}{c}
1 \\
E302
\end{array}$ LOWER LEVEL AREA C - POWER
SCALE:  $1/8^{"} = 1'-0"$ 




- 1. REFER TO MECHANICAL EQUIPMENT CONNECTION SCHEDULE, DWGS. E608 THROUGH E610, FOR ADDITIONAL INFORMATION.
- 2. REINSTALL CEILING MOUNTED DEVICES REFER TO DEMOLITION DRAWINGS.
- 3. FIELD COORDINATE EXACT LOCATION OF PROJECTOR LOW DROPS WITH HCPS.

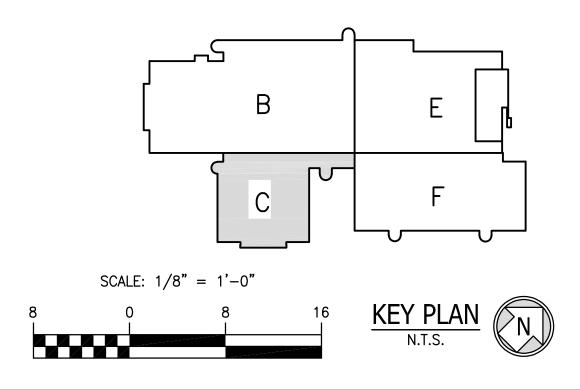


REVISIONS	NO. DATE DESCRIPTION	3/7/24         ADDENDUM NO. 1	2 3/14/24 ADDENDUM NO. 2	3/20/24 ADDENDUM NO. 3	4         3/27/24         ADDENDUM NO. 4			
	SCLOSED	NOT BE	LE OR IN WRITTEN	NTES, INC.				
		ENGINEERS ARE PROPRIETARY TO GIPE ASSOCIATES. INC. AND SHALL NOT BE		Easton, Maryland 21601 PERMISSION OF GIPE ASSOCIATES, INC.	Fax: 410.822.6306 Copyright © 2023			
DATE 2720 East Joppa Road Scociates Inc. Consulting Engineers Suite 2-3 Suite 2-3 Suite 2-3 Suite 2-3 Suite 2-3 Suite 2-3 Suite 2-3 Suite 2-5 Suite 2-5 Su								
	LOWEK LEVEL AKEA C - POWEK		HARFORD COUNTY PUBLIC SCHOOLS - ABERDEEN MIDDLE SCHOOL	HVAC SYSTEMIC RENOVATIONS	111 MT ROYAL AVE, ABERDEEN, MARYLAND 21001.			
	→ E		BMIS: 02	~~~~~~~~~~~~~~~~~~~~~~~~~~~~~~~~~~~~~~				

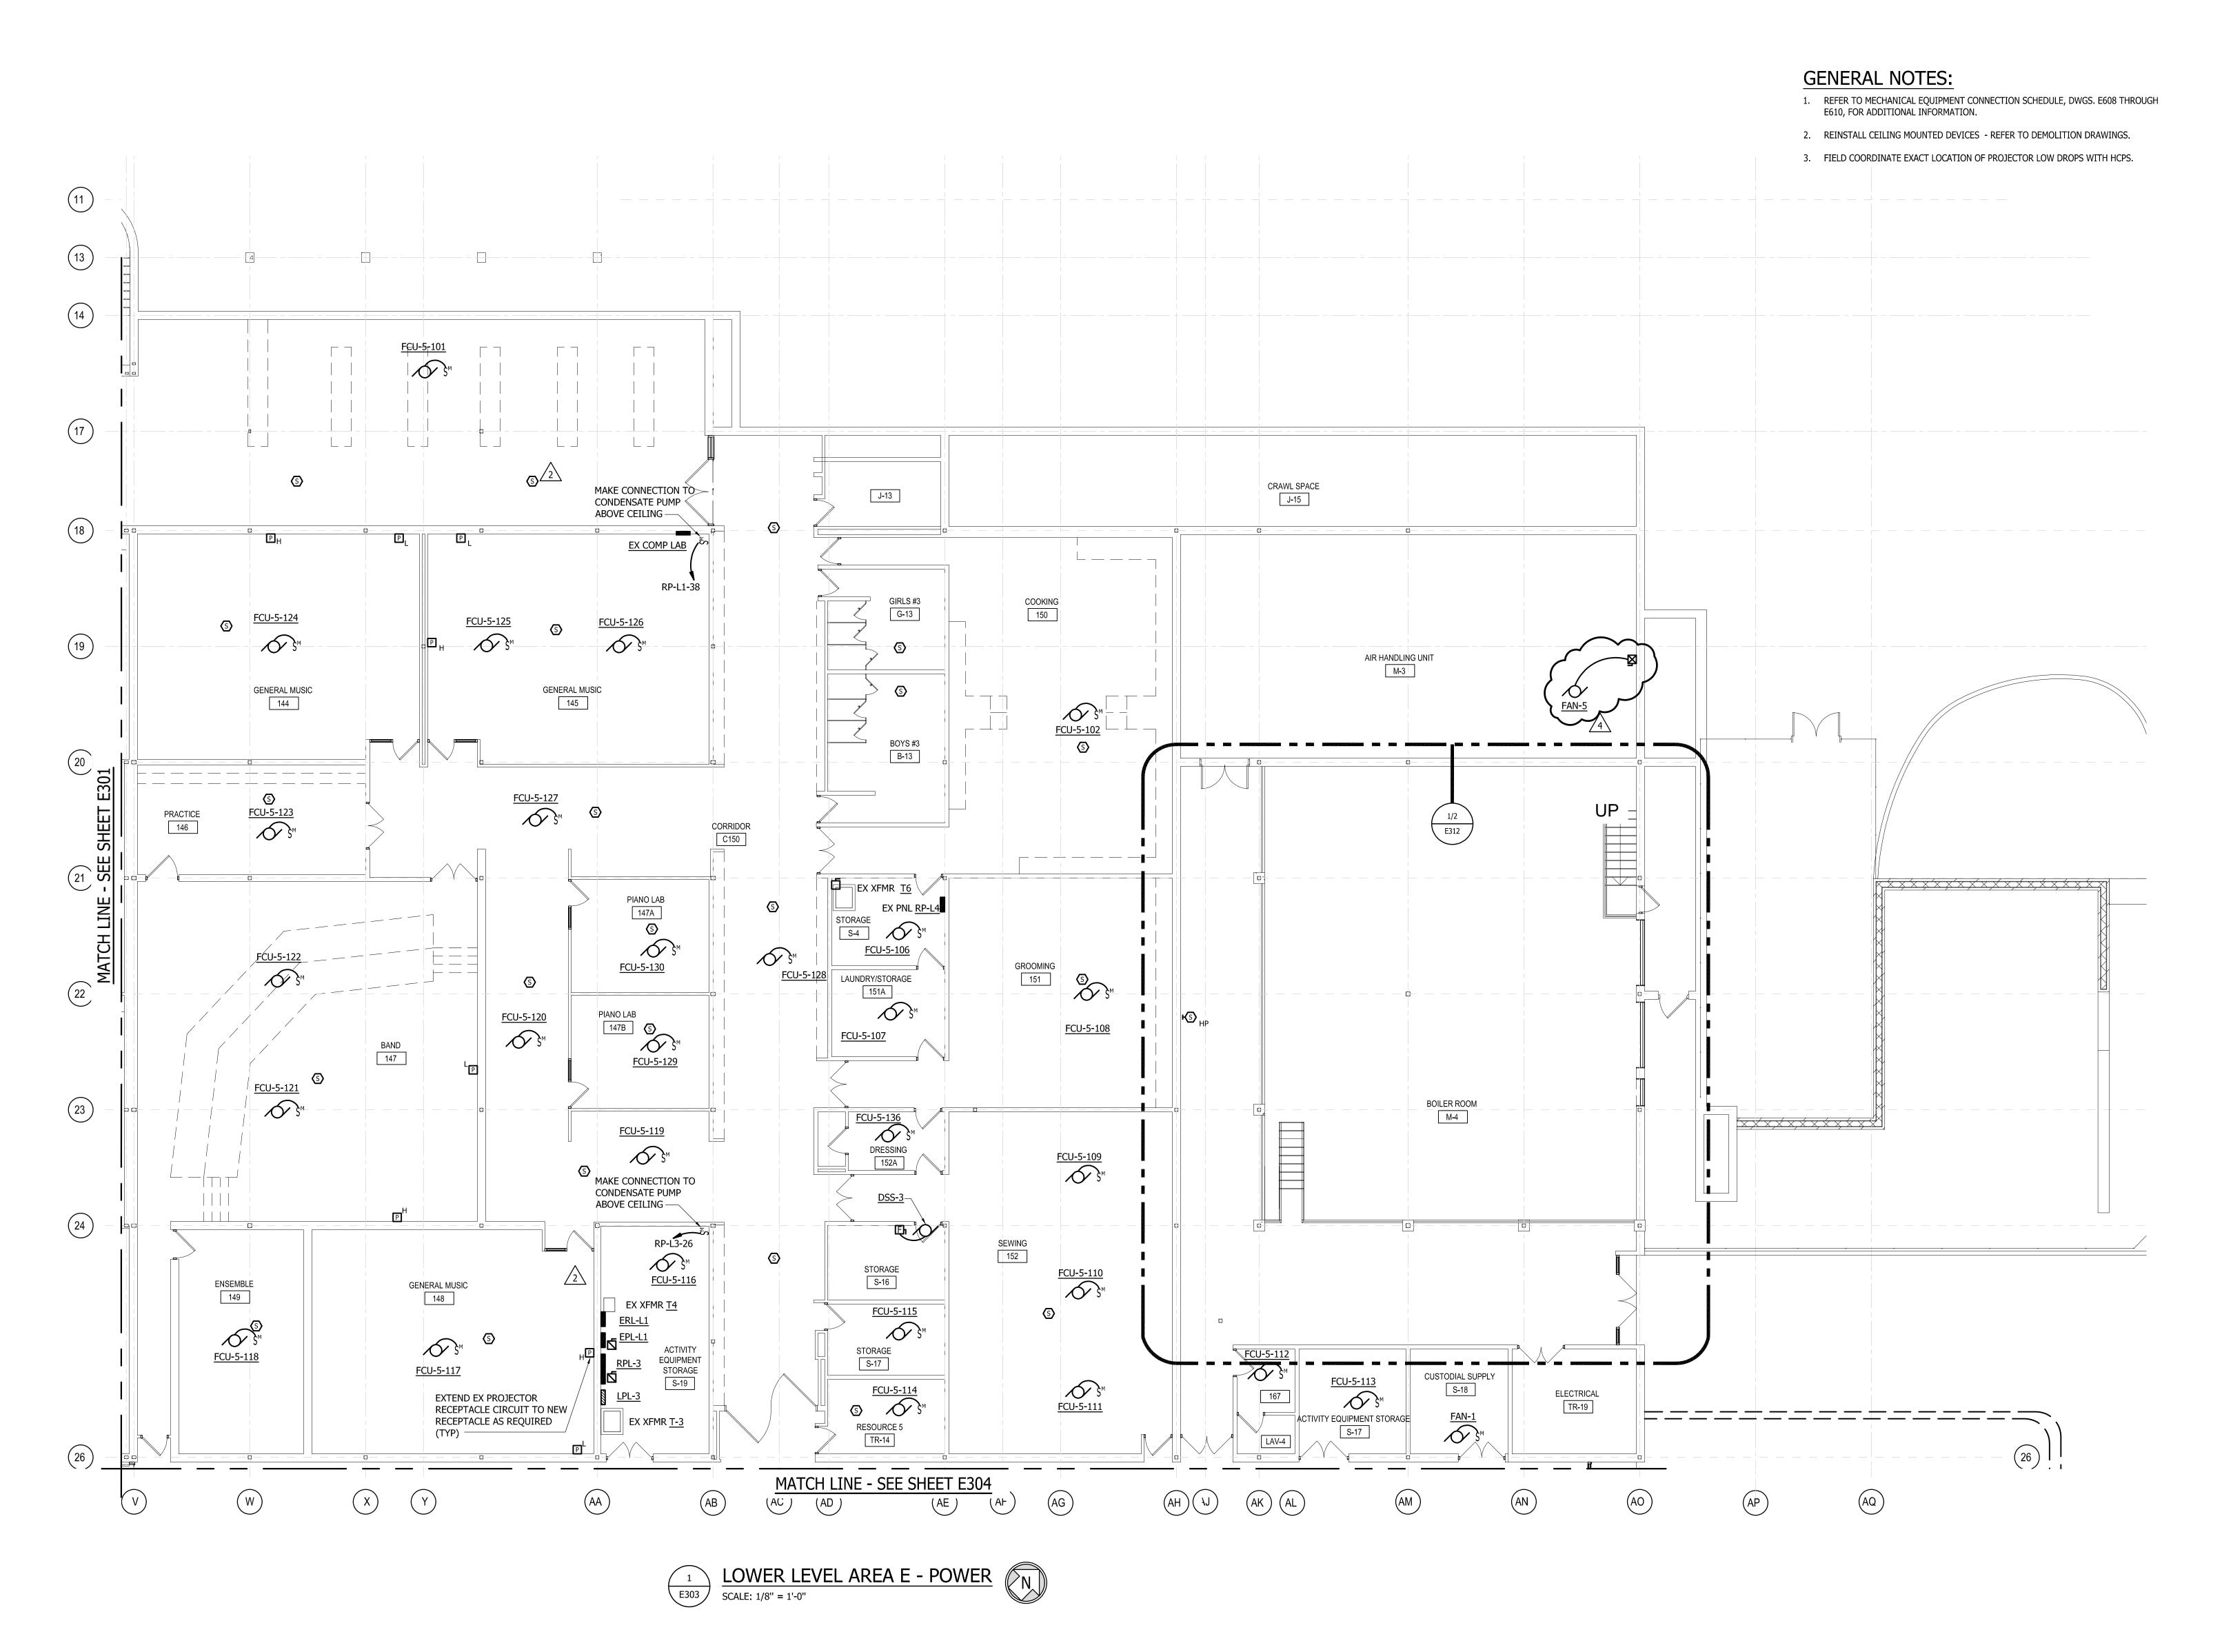

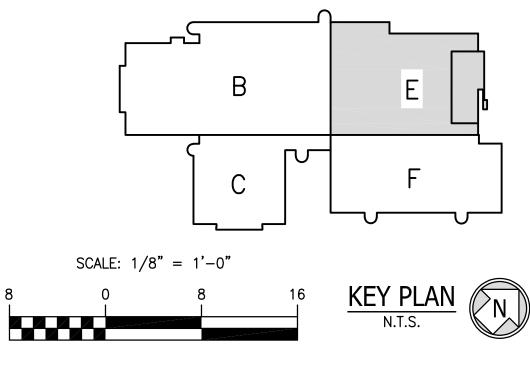


REVISIONS	NO. DATE DESCRIPTION	$\sqrt{1}$ 3/7/24 ADDENDUM NO. 1	2 3/14/24 ADDENDUM NO. 2	3/20/24 ADDENDUM NO. 3	4         3/27/24         ADDENDUM NO. 4			
	CLOSED	JOT BE	E OR IN WRITTEN	TES, INC.				
		Ingineers are proprietary to gipe associates. Inc. and shall not be		601 3	Fax: 410.822.6306 Copyright © 2U23			
DATE 2720201000 ENCLOSE 100 EN								
	LOWEK LEVEL AKEA E - POWEK		HARFORD COUNTY PUBLIC SCHOOLS - ABERDEEN MIDDLE SCHOOL	HVAC SYSTEMIC RENOVATIONS	111 MT ROYAL AVE, ABERDEEN, MARYLAND 21001.			
	← E	3	BMIS: <b>0</b>	~~ 3~~~				

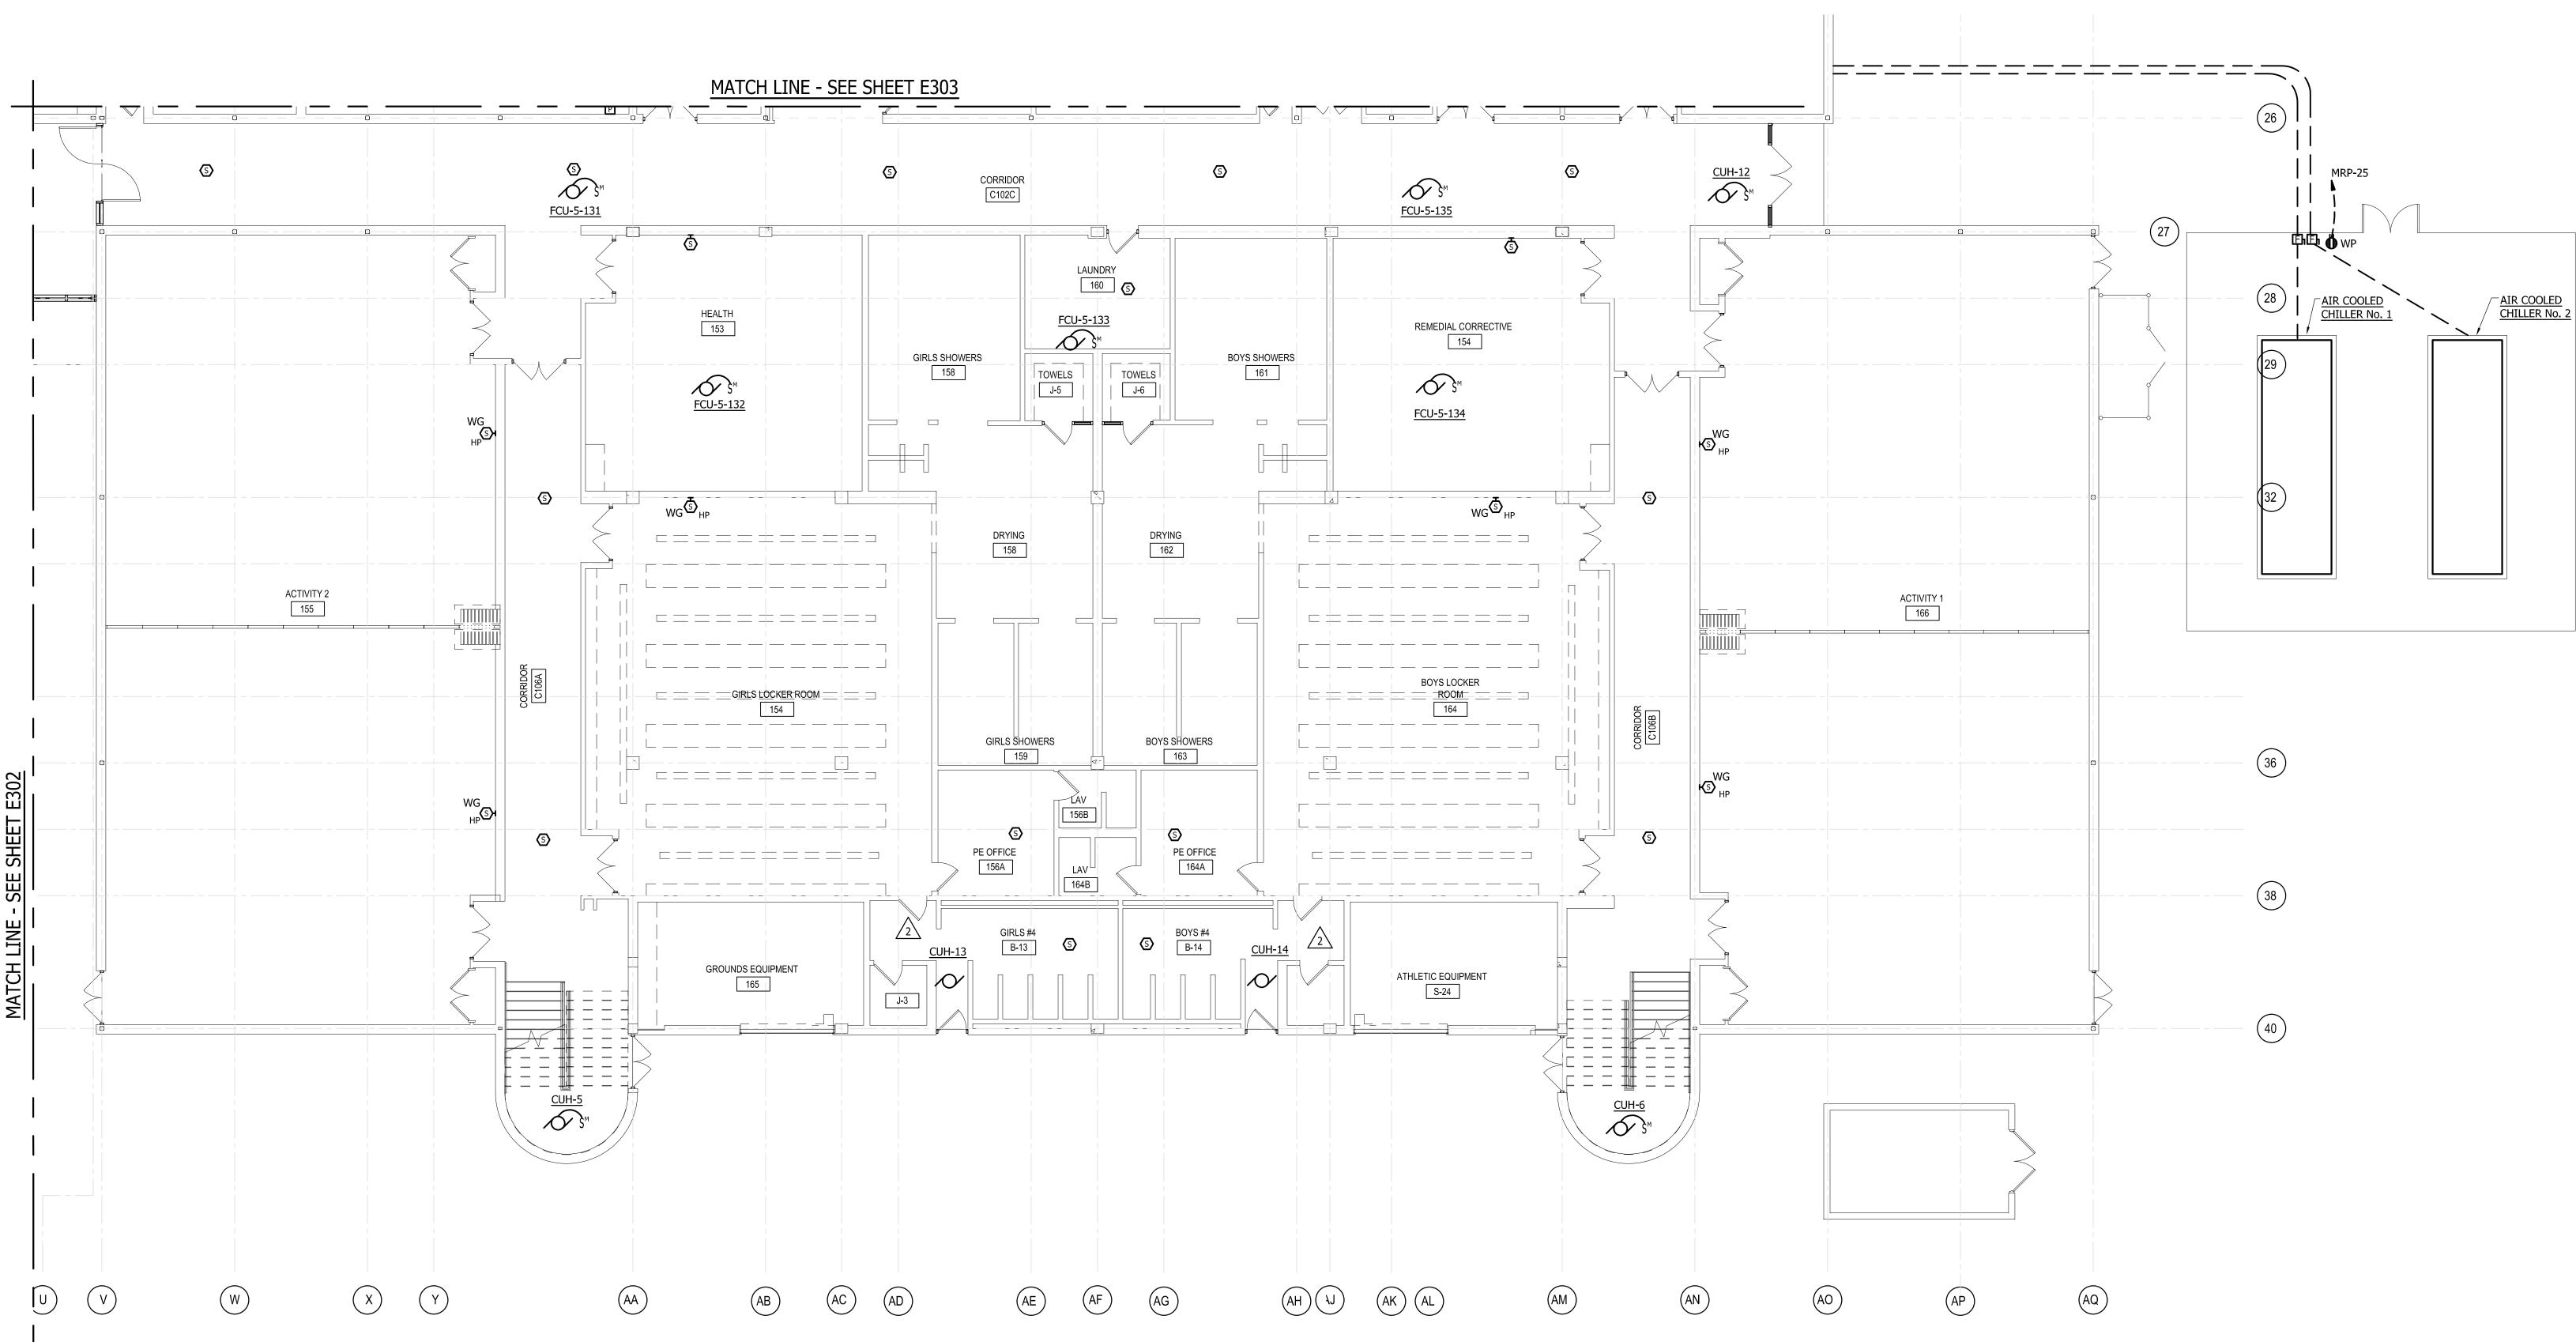




- 1. REFER TO MECHANICAL EQUIPMENT CONNECTION SCHEDULE, DWGS. E608 THROUGH E610, FOR ADDITIONAL INFORMATION.
- 2. REINSTALL CEILING MOUNTED DEVICES REFER TO DEMOLITION DRAWINGS.
- 3. FIELD COORDINATE EXACT LOCATION OF PROJECTOR LOW DROPS WITH HCPS.

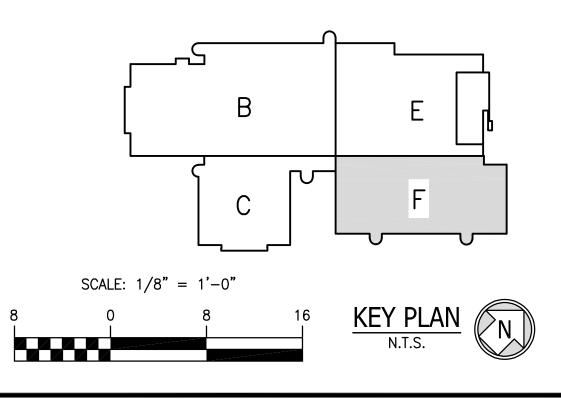




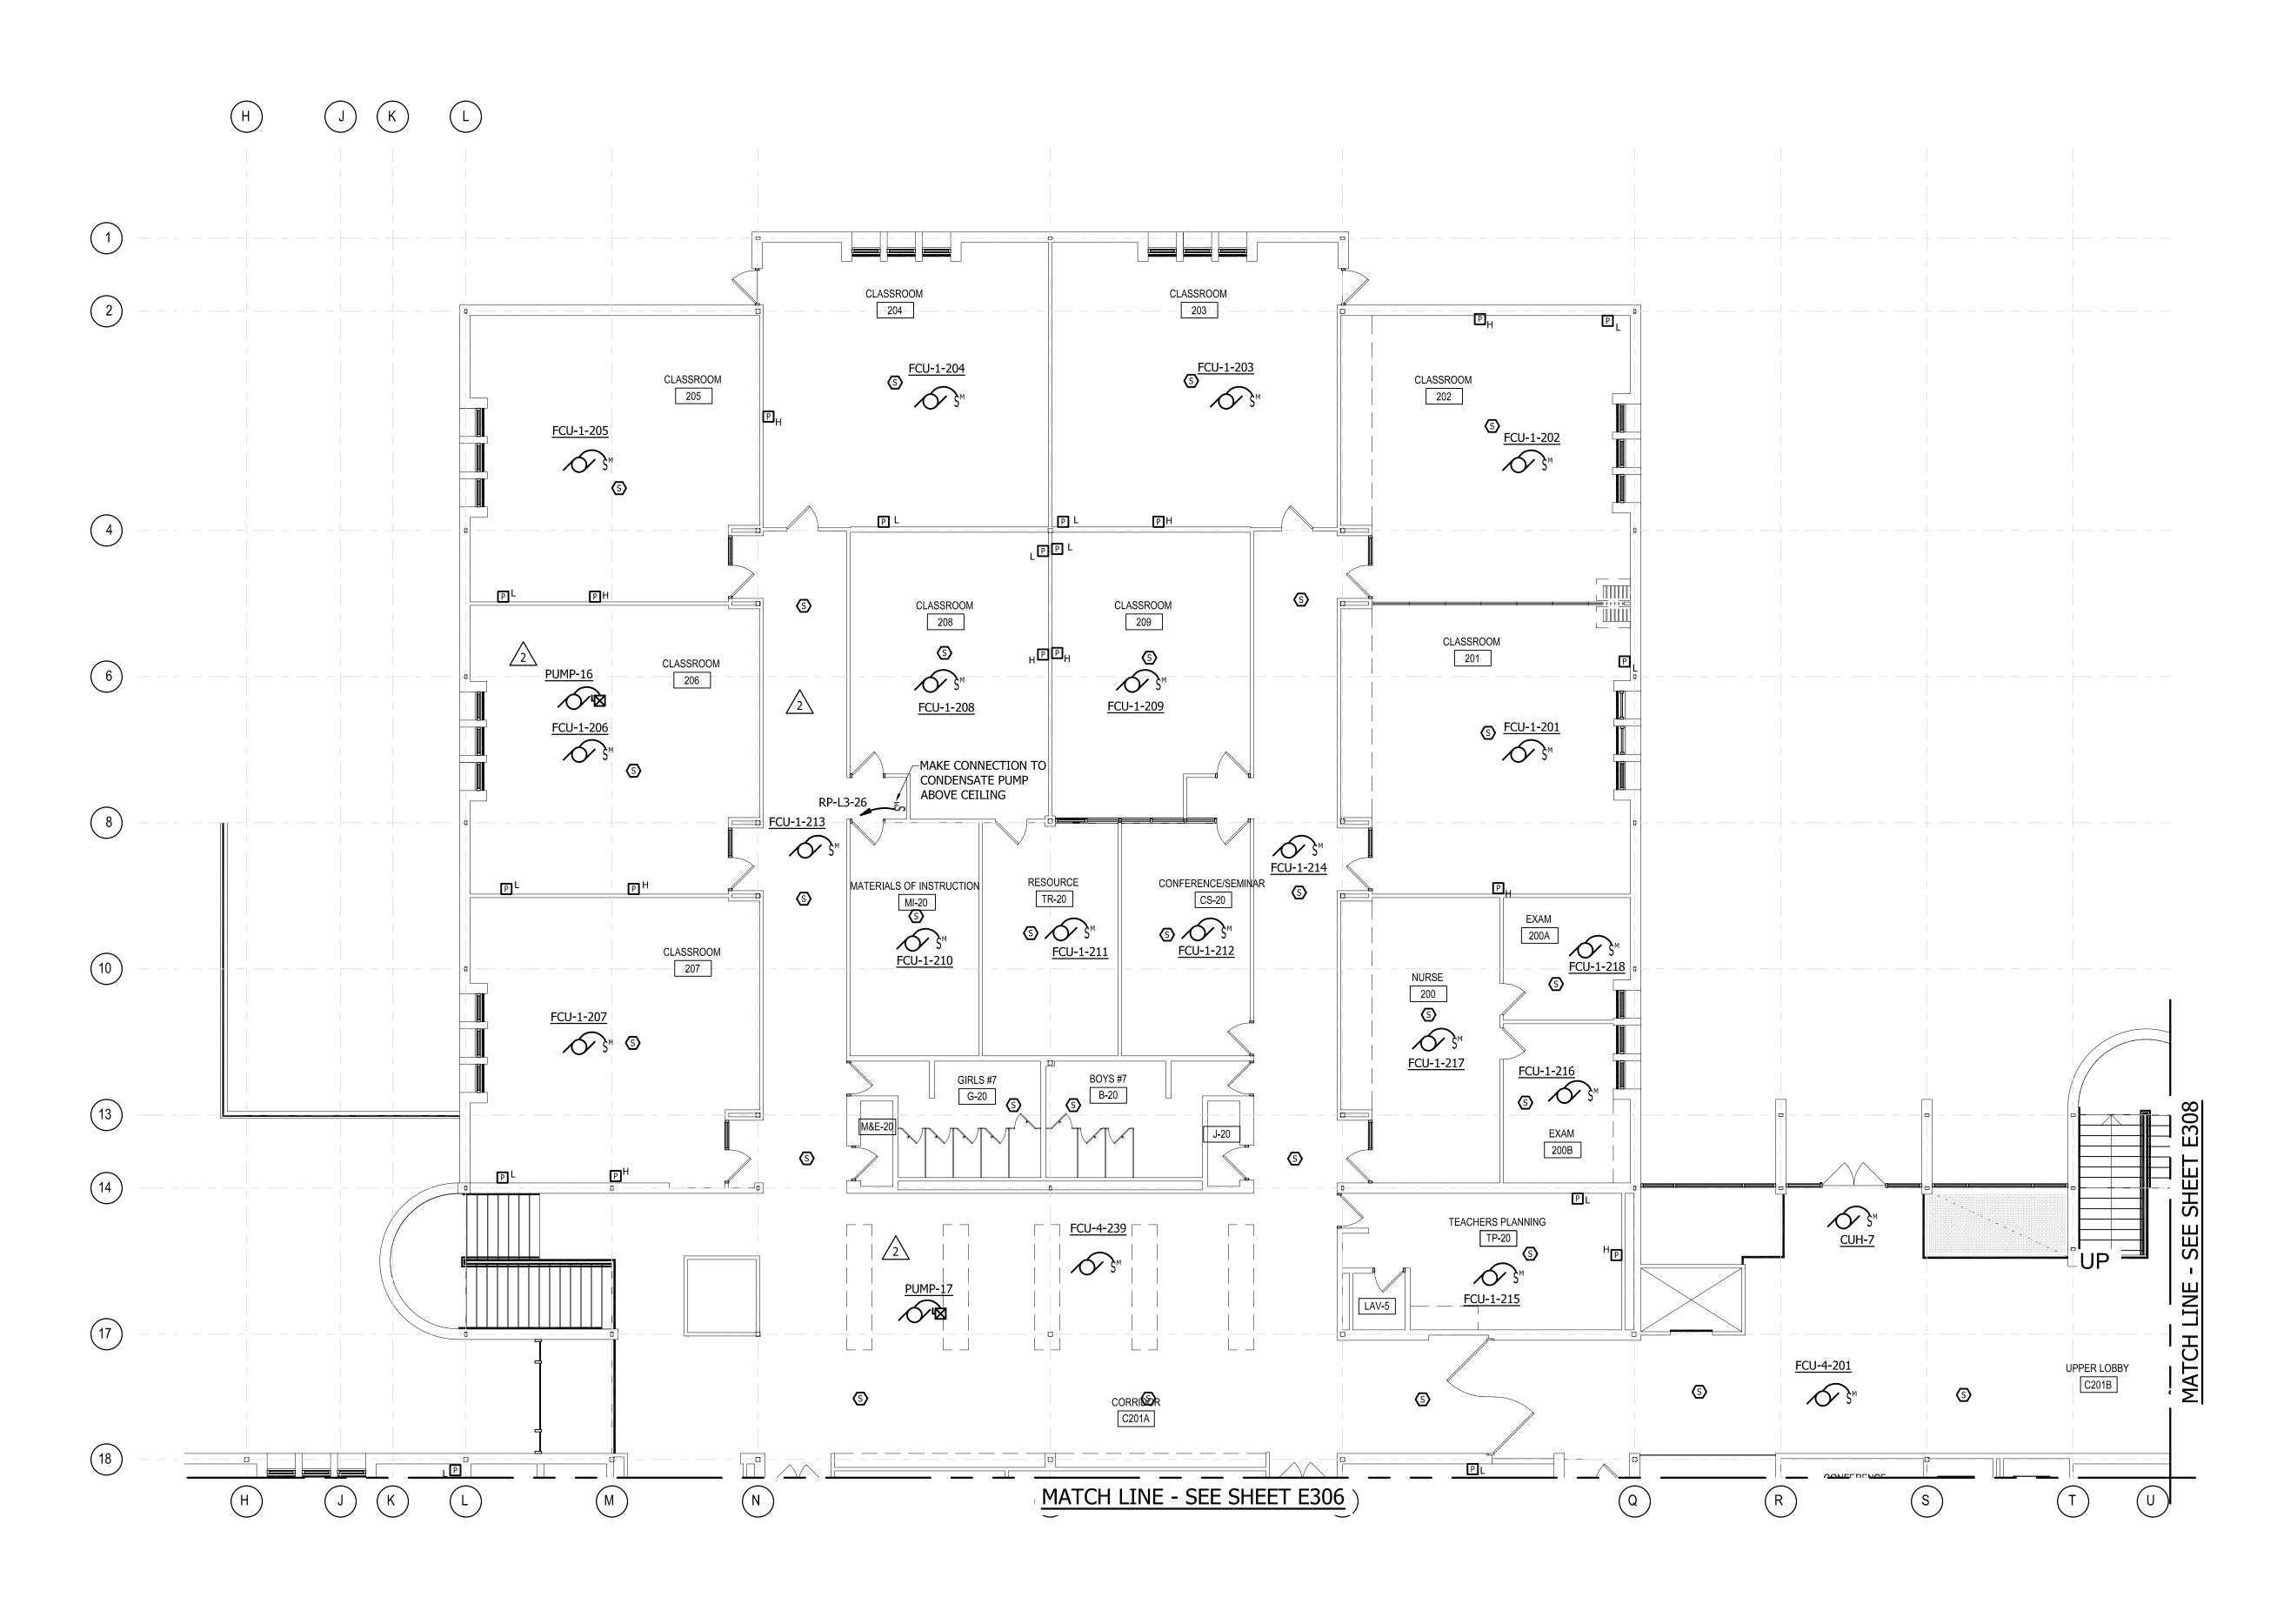


 $\underbrace{1}_{\text{E305}} \frac{\text{UPPER LEVEL AREA A - POWER}}{\text{SCALE: 1/8" = 1'-0"}}$ 



- 1. REFER TO MECHANICAL EQUIPMENT CONNECTION SCHEDULE, DWGS. E608 THROUGH E610, FOR ADDITIONAL INFORMATION.
- 2. REINSTALL CEILING MOUNTED DEVICES REFER TO DEMOLITION DRAWINGS.
- 3. FIELD COORDINATE EXACT LOCATION OF PROJECTOR LOW DROPS WITH HCPS.

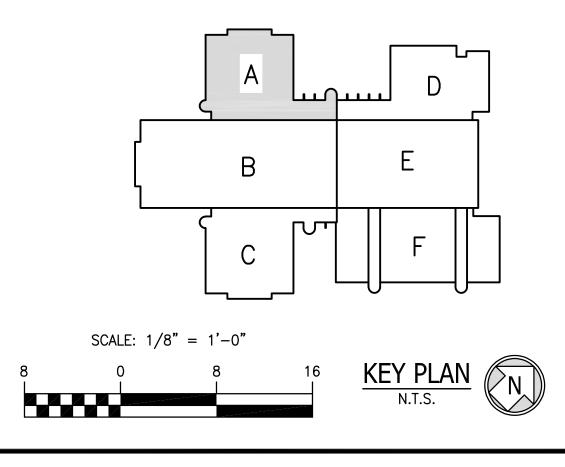

REVISIONS	NO. DATE DESCRIPTION	3/7/24 ADDENDUM NO. 1	2 3/14/24 ADDENDUM NO. 2	3/20/24 ADDENDUM NO. 3	4         3/27/24         ADDENDUM NO. 4			
	LES DISCLOSED	GIPE SHALL NOT BE	N WHOLE OR IN	SSOCIATES, INC.				
Gine Accoriates Inc		Consulting Engineers Are proprietary to gipe Associates. Inc. and shall		Easton, Maryland 21601 Phone: 410.822.868	Fax: 410.832.2418 Fax: 410.822.6306 Copyright © 2U23			
WO# 23043 WO# 23043 PROJECT EMP DESIGNER EMP DATE 2/26/2024								
	UPPEK LEVEL AKEA A - POWEK		HARFORD COUNTY PUBLIC SCHOOLS - ABERDEEN MIDDLE SCHOOL	HVAC SYSTEMIC RENOVATIONS	111 MT ROYAL AVE, ABERDEEN, MARYLAND 21001.			
	← E	3	вміs О.	~ 5 ~				

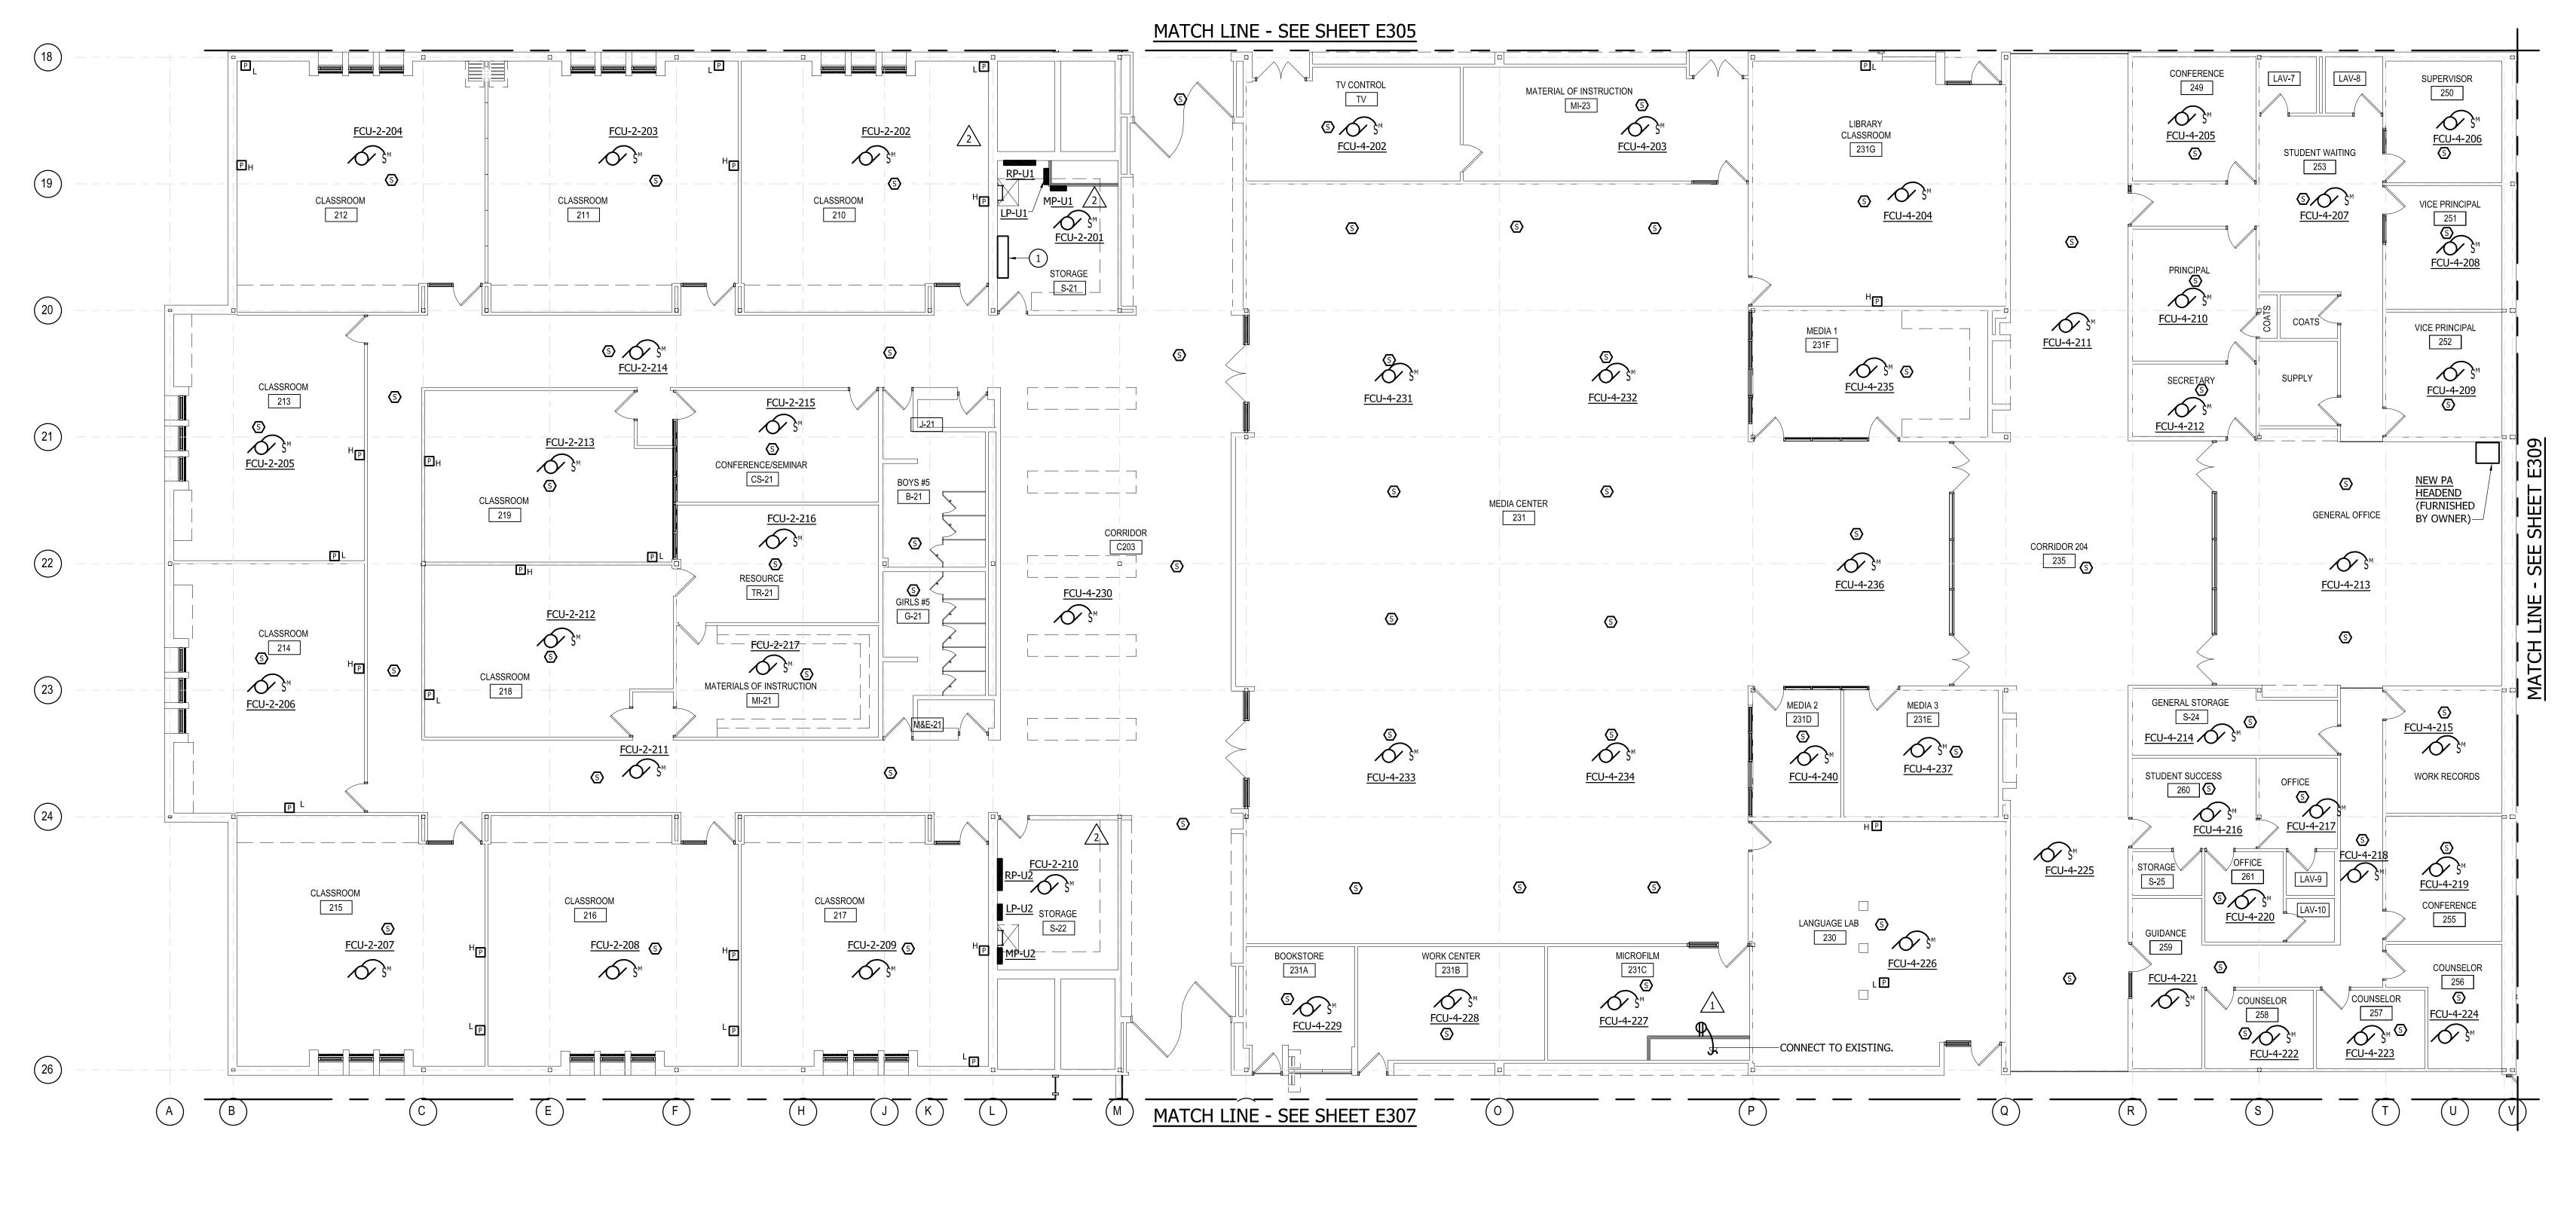





# **GENERAL NOTES:**

 REFER TO MECHANICAL EQUIPMENT CONNECTION SCHEDULE, I THROUGH E610, FOR ADDITIONAL INFORMATION.
 REINSTALL CEILING MOUNTED DEVICES - REFER TO DEMOLITIVE 3DRAWING TENOTICES ION OF PROJECTOR LOW DROPS WITH THE PROJECTOR LOW DR

1 INTERCEPT EX BRANCH CIRCUITS ABOVE CEILING, AND PROVIDE NEC. EXTEND EXISTING BRANCH CIRCUITS TO NEW PANEL LOCA

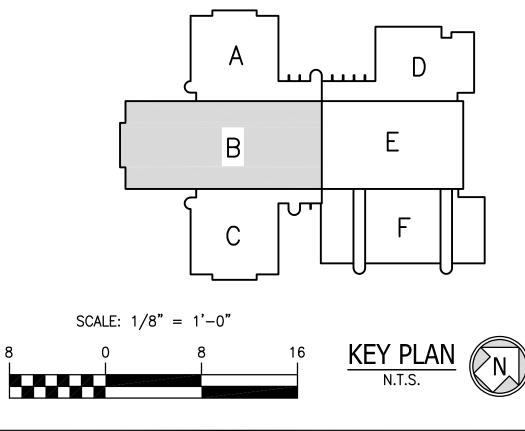


, DWGS. E608 TION DRAWINGS. /ITH HCPS. IDE JB'S, SIZED PER CATION AS REQUIRED.	REVISIONS	DESCRIPTION	ADDENDUM NO. 1	ADDENDUM NO. 2	ADDENDUM NO. 3	ADDENDUM NO. 4
		NO. DATE	<u>7</u> 3/7/24	2 3/14/24	3/20/24	4 3/27/24
		)ED	ш		NC.	
		IN FEATURES DISCLOS	ARE PROPRIETARY TO GIPE ASSOCIATES. INC. AND SHALL NOT BE	ALTERED OR REUSED IN WHOLE OR IN	MISSION OF GIPE ASSOCIATES, INC.	m
		CONSTRUCTIC	ARE PROPRIET ASSOCIATES.			Copyright © 2023
	iatac Inc		ngineers	8719 Brooke Drive Suite 2-5	Easton, Maryland 21601 Phone: 410.822.8688	Fax: 410.822.6306
	Gine Accoriated Inc		Consulting Engineers	1220 East Joppa Road Suitte 223	Towson, MD. 21286 Phone: 410.832.2420	Fax: 410.832.2418
		W	)# 2	<b>_</b> 2304		
	PROJI MANA				4P 4P	
	DATE		2/	′26 <sub>/</sub>	/202	24
	Í	UPPER LEVEL AREA B - POWER		HARFORD COUNTY PUBLIC SCHOOLS - ABERDEEN MIDDLE SCHOOL	HVAC SYSTEMIC RENOVATIONS	111 MT ROYAL AVE, ABERDEEN, MARYLAND 21001.
		BIC	) SU	BMIS	SION	
		~ E	3	~ 00	5	}

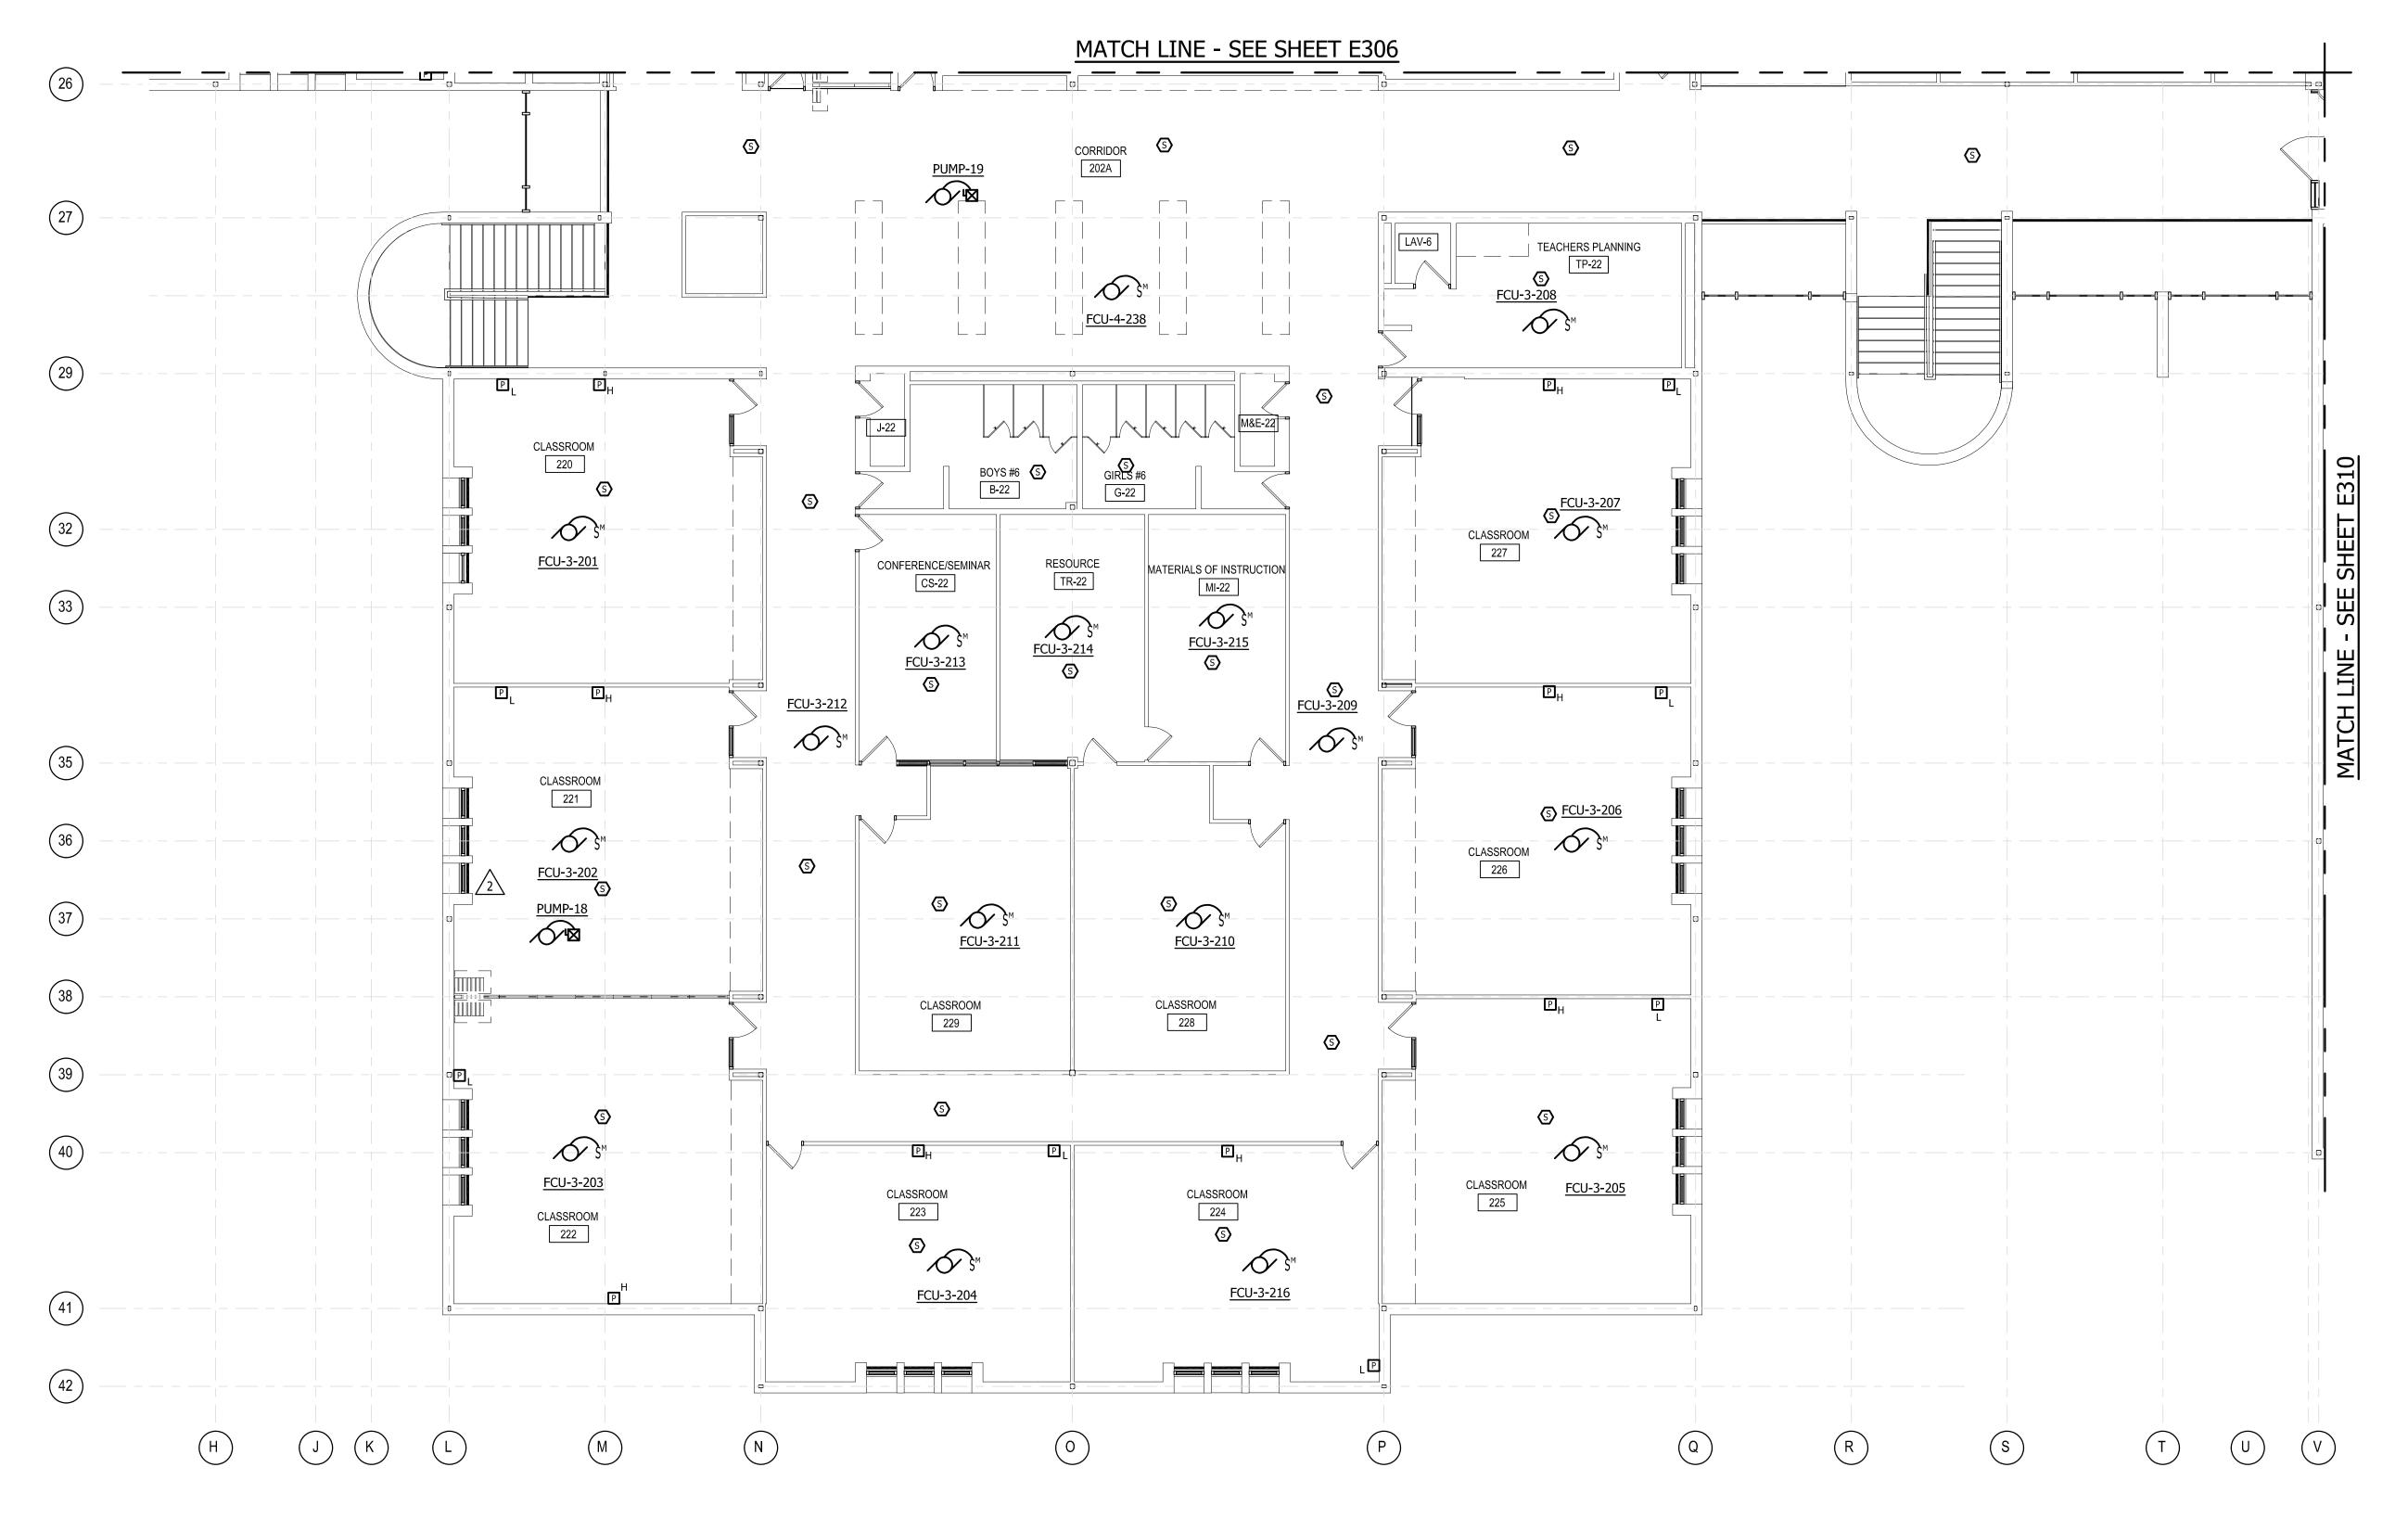

 $\underbrace{1}_{\text{E307}} \frac{\text{UPPER LEVEL AREA C - POWER}}{\text{SCALE: 1/8'' = 1'-0''}}$ 


- 1. REFER TO MECHANICAL EQUIPMENT CONNECTION SCHEDULE, DWGS. E608 THROUGH E610, FOR ADDITIONAL INFORMATION.
- 2. REINSTALL CEILING MOUNTED DEVICES REFER TO DEMOLITION DRAWINGS.
- 3. FIELD COORDINATE EXACT LOCATION OF PROJECTOR LOW DROPS WITH HCPS.

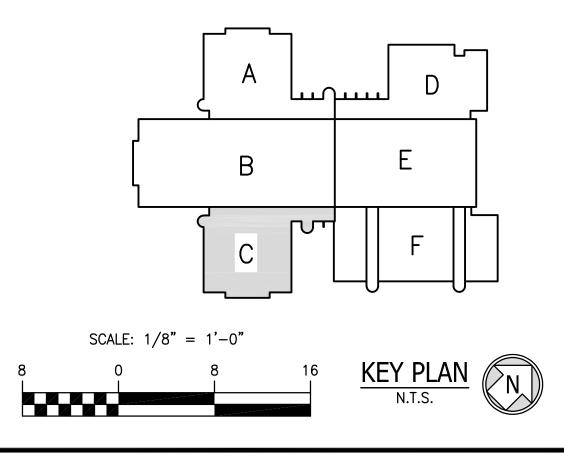


REVISIONS	NO. DATE DESCRIPTION	$\sqrt{1}$ 3/7/24 ADDENDUM NO. 1	2 3/14/24 ADDENDUM NO. 2	3/20/24 ADDENDUM NO. 3	$\sqrt[]{4}$ 3/27/24 addendum No. 4
THIS DRAWING AND THE DESIGN AND	CONSTRUCTION FEATURES DISCLOSED	ARE PROPRIETARY TO GIPE ASSOCIATES. INC. AND SHALL NOT BE	ALTERED OR REUSED IN WHOLE OR IN	PERMISSION OF GIPE ASSOCIATES, INC.	Copyright © 2023
		Consulting Engineers		Towson, MD. 21286 Phone: 410.832.2420	Fax: 410.832.2418 Fax: 410.822.6306
PROJE MANAC DESIG	Ger			MP MP	
DATE		2/	′26/	/202	24
	UPPER LEVEL AREA C - POWER		HARFORD COUNTY PUBLIC SCHOOLS - ABERDEEN MIDDLE SCHOOL	HVAC SYSTEMIC RENOVATIONS	111 MT ROYAL AVE, ABERDEEN, MARYLAND 21001.
	BID	) SU	BMIS	SION	
	~				



- 1. REFER TO MECHANICAL EQUIPMENT CONNECTION SCHEDULE, DWGS. E608 THROUGH E610, FOR ADDITIONAL INFORMATION.
- 2. REINSTALL CEILING MOUNTED DEVICES REFER TO DEMOLITION DRAWINGS.
- 3. FIELD COORDINATE EXACT LOCATION OF PROJECTOR LOW DROPS WITH HCPS.

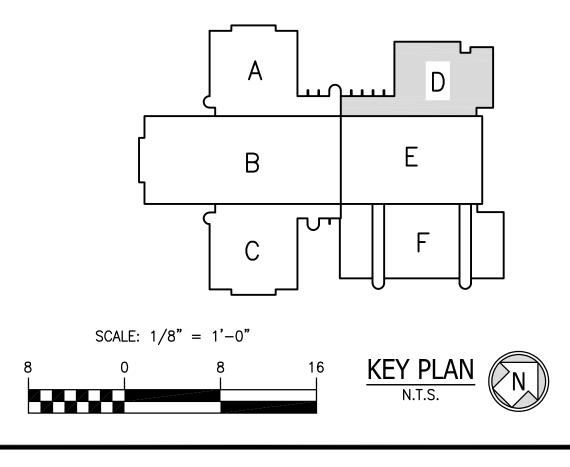

			desig Date	PROJE MANAG	Line Accoriates Inc	THIS DRAWING AND THE DESIGN AND		R	REVISIONS
F E	BID	UPPER LEVEL AREA U - POWER	NER			CONSTRUCTION FEATURES DISCLOSED		NO. DATE	DESCRIPTION
<u> </u>	SU		2/	# 2	consulung Engineers	ARE PROPRIETARY TO GIPE ASSOCIATES. INC. AND SHALL NOT BE		<u> 1</u> 3/7/24	ADDENDUM NO. 1
	BMIS	HARFORD COUNTY PUBLIC SCHOOLS - ABERDEEN MIDDLE SCHOOL	E№ ′26/	2304 EM	1220 East Joppa Road 8719 Brooke Drive Suite 223 Suite 2-5	ALTERED OR REUSED IN WHOLE OR IN		2 3/14/24	ADDENDUM NO. 2
<u> </u>	SION	HVAC SYSTEMIC RENOVATIONS		13 1P	0. 21286 E	PERMISSION OF GIPE ASSOCIATES, INC.		3/20/24	ADDENDUM NO. 3
		111 MT ROYAL AVE, ABERDEEN, MARYLAND 21001.	24	_	Fax: 410.832.2418 Fax: 410.822.6306	Copyright © 2023		<u></u> 4 3/27/24	ADDENDUM NO. 4

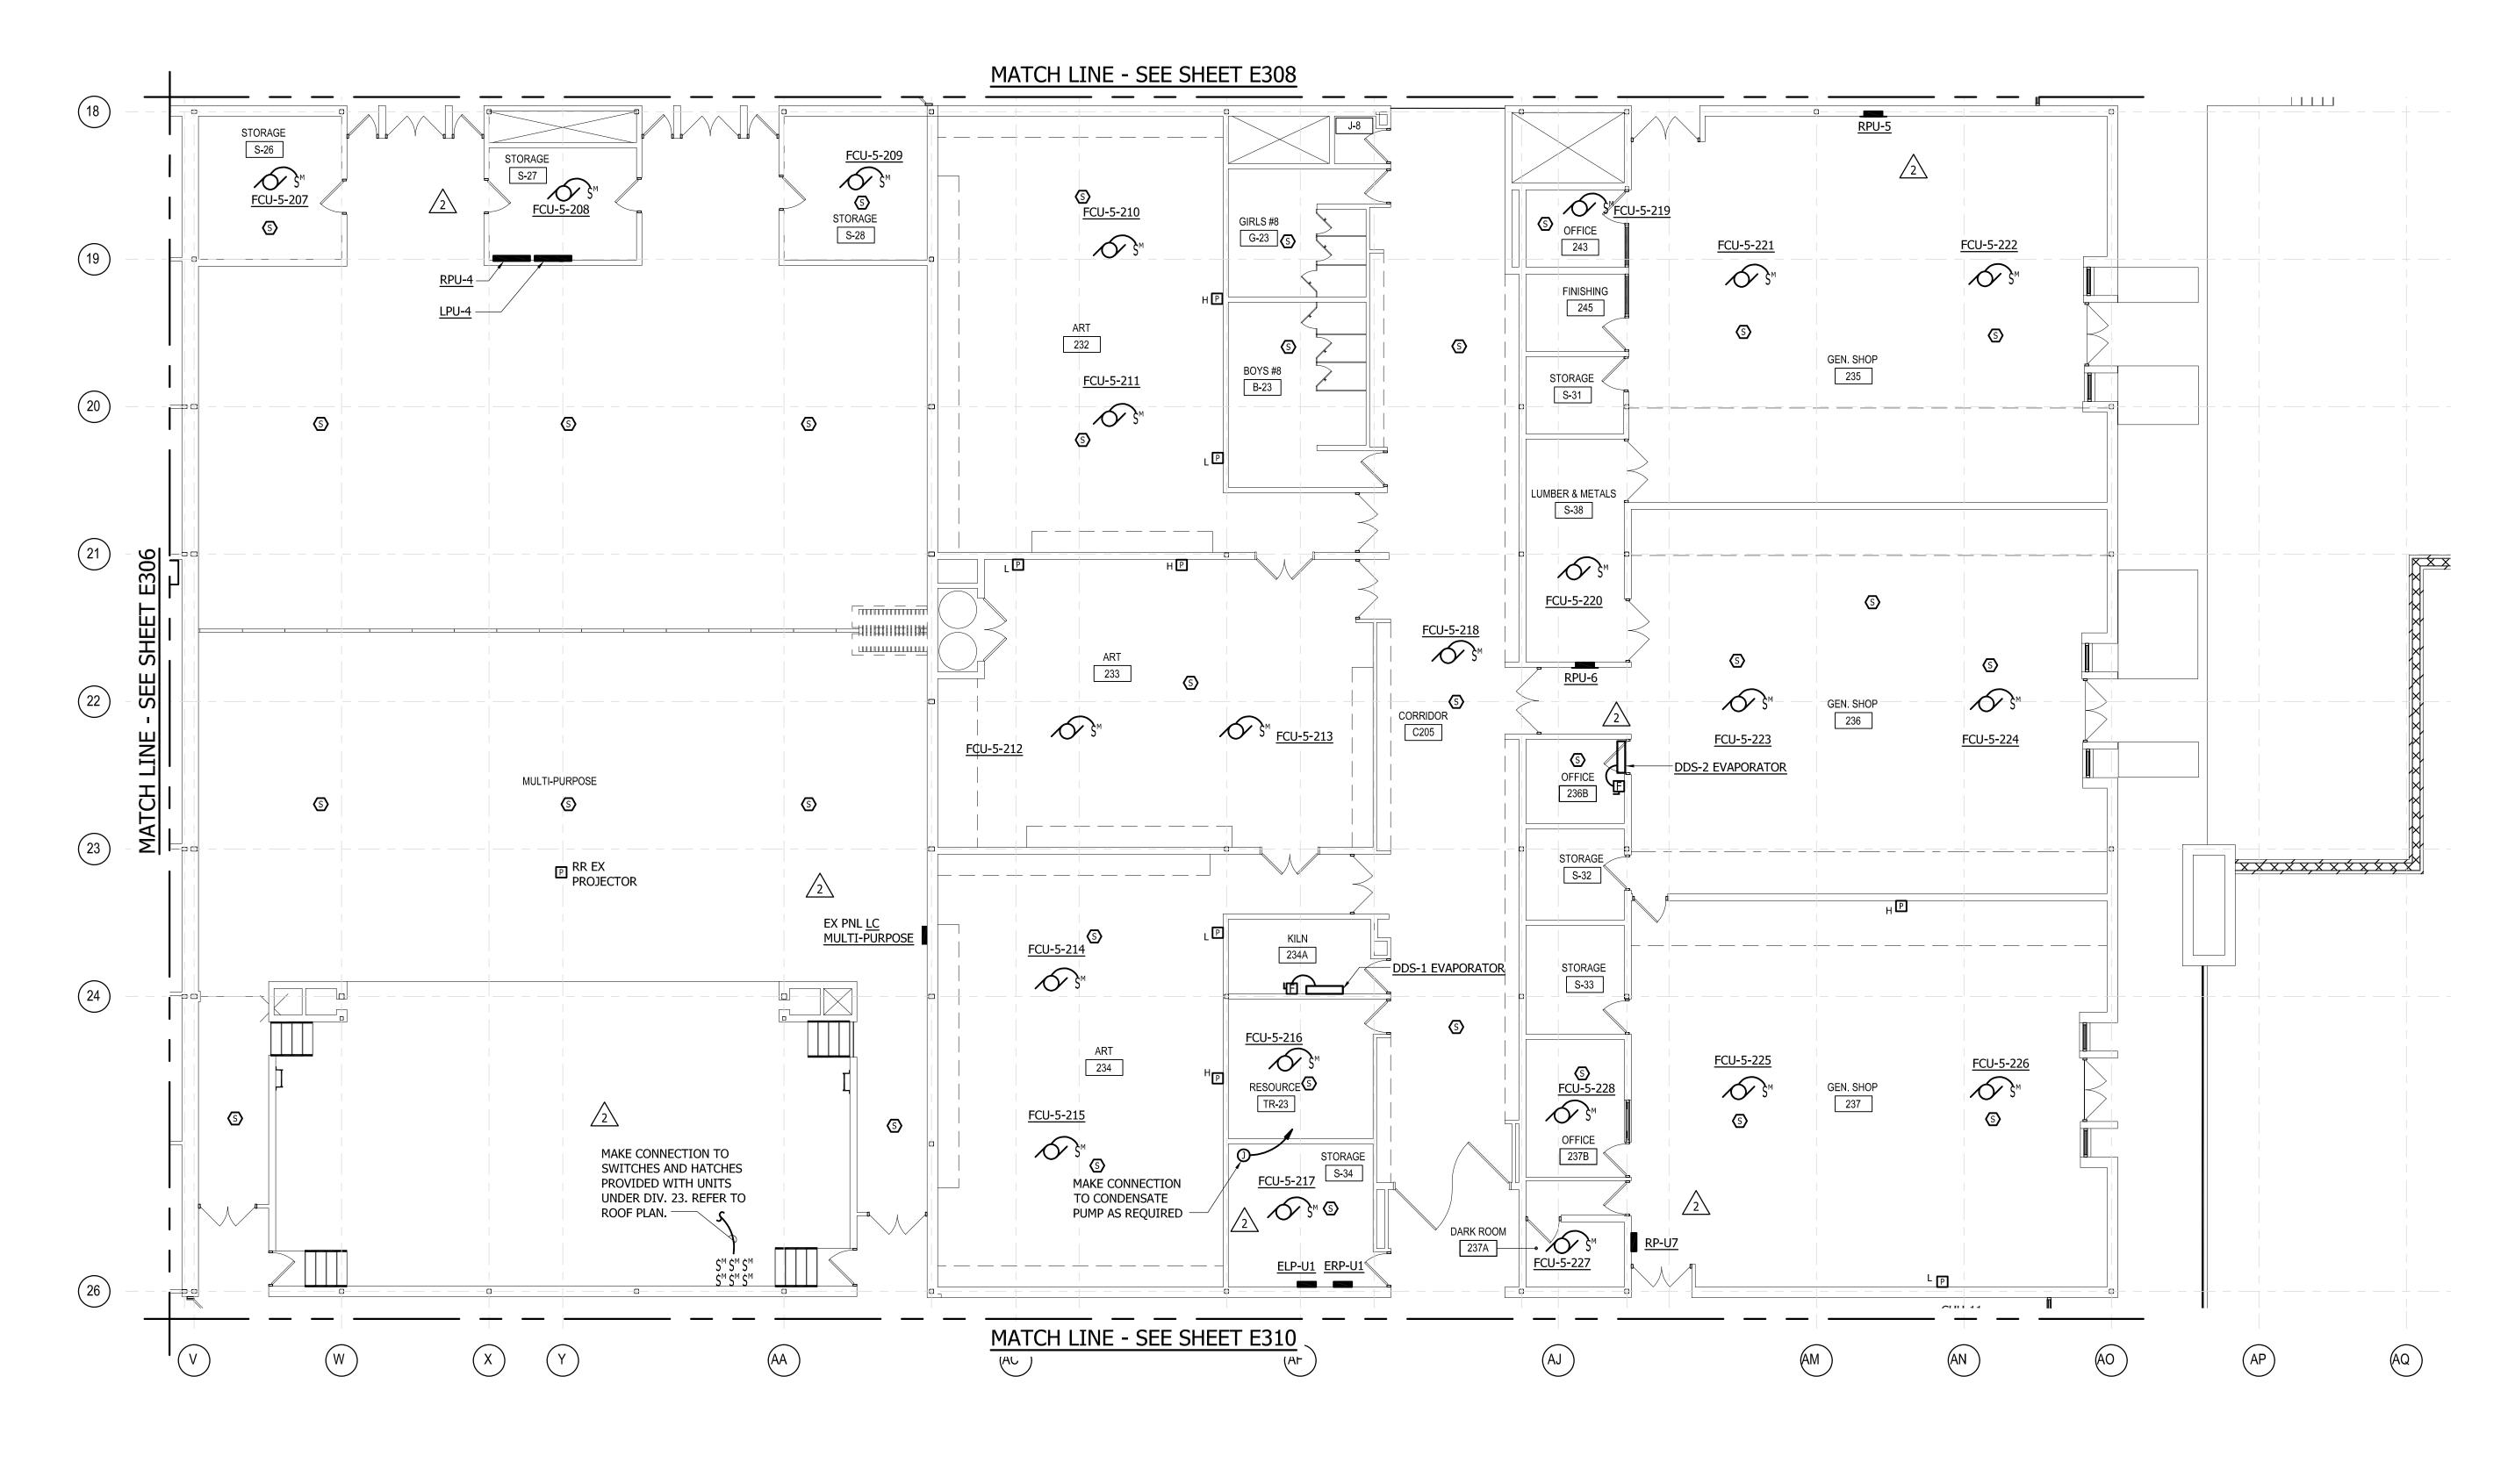




 $\underbrace{1}_{\text{E309}} \frac{\text{UPPER LEVEL AREA E - POWER}}{\text{SCALE: 1/8'' = 1'-0''}}$ 


# **GENERAL NOTES:**

- 1. REFER TO MECHANICAL EQUIPMENT CONNECTION SCHEDULE, DWGS. E608 THROUGH E610, FOR ADDITIONAL INFORMATION.
- 2. REINSTALL CEILING MOUNTED DEVICES REFER TO DEMOLITION DRAWINGS.

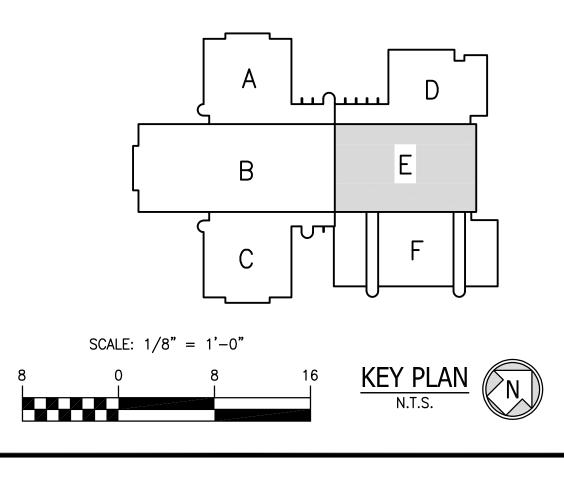

3. FIELD COORDINATE EXACT LOCATION OF PROJECTOR LOW DROPS WITH HCPS.

THIS I CONS ARE F ASSO ALTEF PART PERM COPY Gipe Associates Inc Consulting Engineers 8719 | Suite 2 Eastor Phone Fax: MD. 21286 10.832.2420 0.832.2418 1220 East Suite 223 Towson, N Phone: 410 Fax: 410 WO**#** 23043 PROJECT MANAGER EMP DESIGNER EMP date 2/26/2024 **IDDLE SCHOOL** EEN Harford County Public Schools -Hvac Systemic Renovations 111 MT Royal Ave, Aberdeen, Maryl UPPER LEVEL AREA E - POWER BID SUBMISSION  $\sim$ E309 4 PSC-12.006

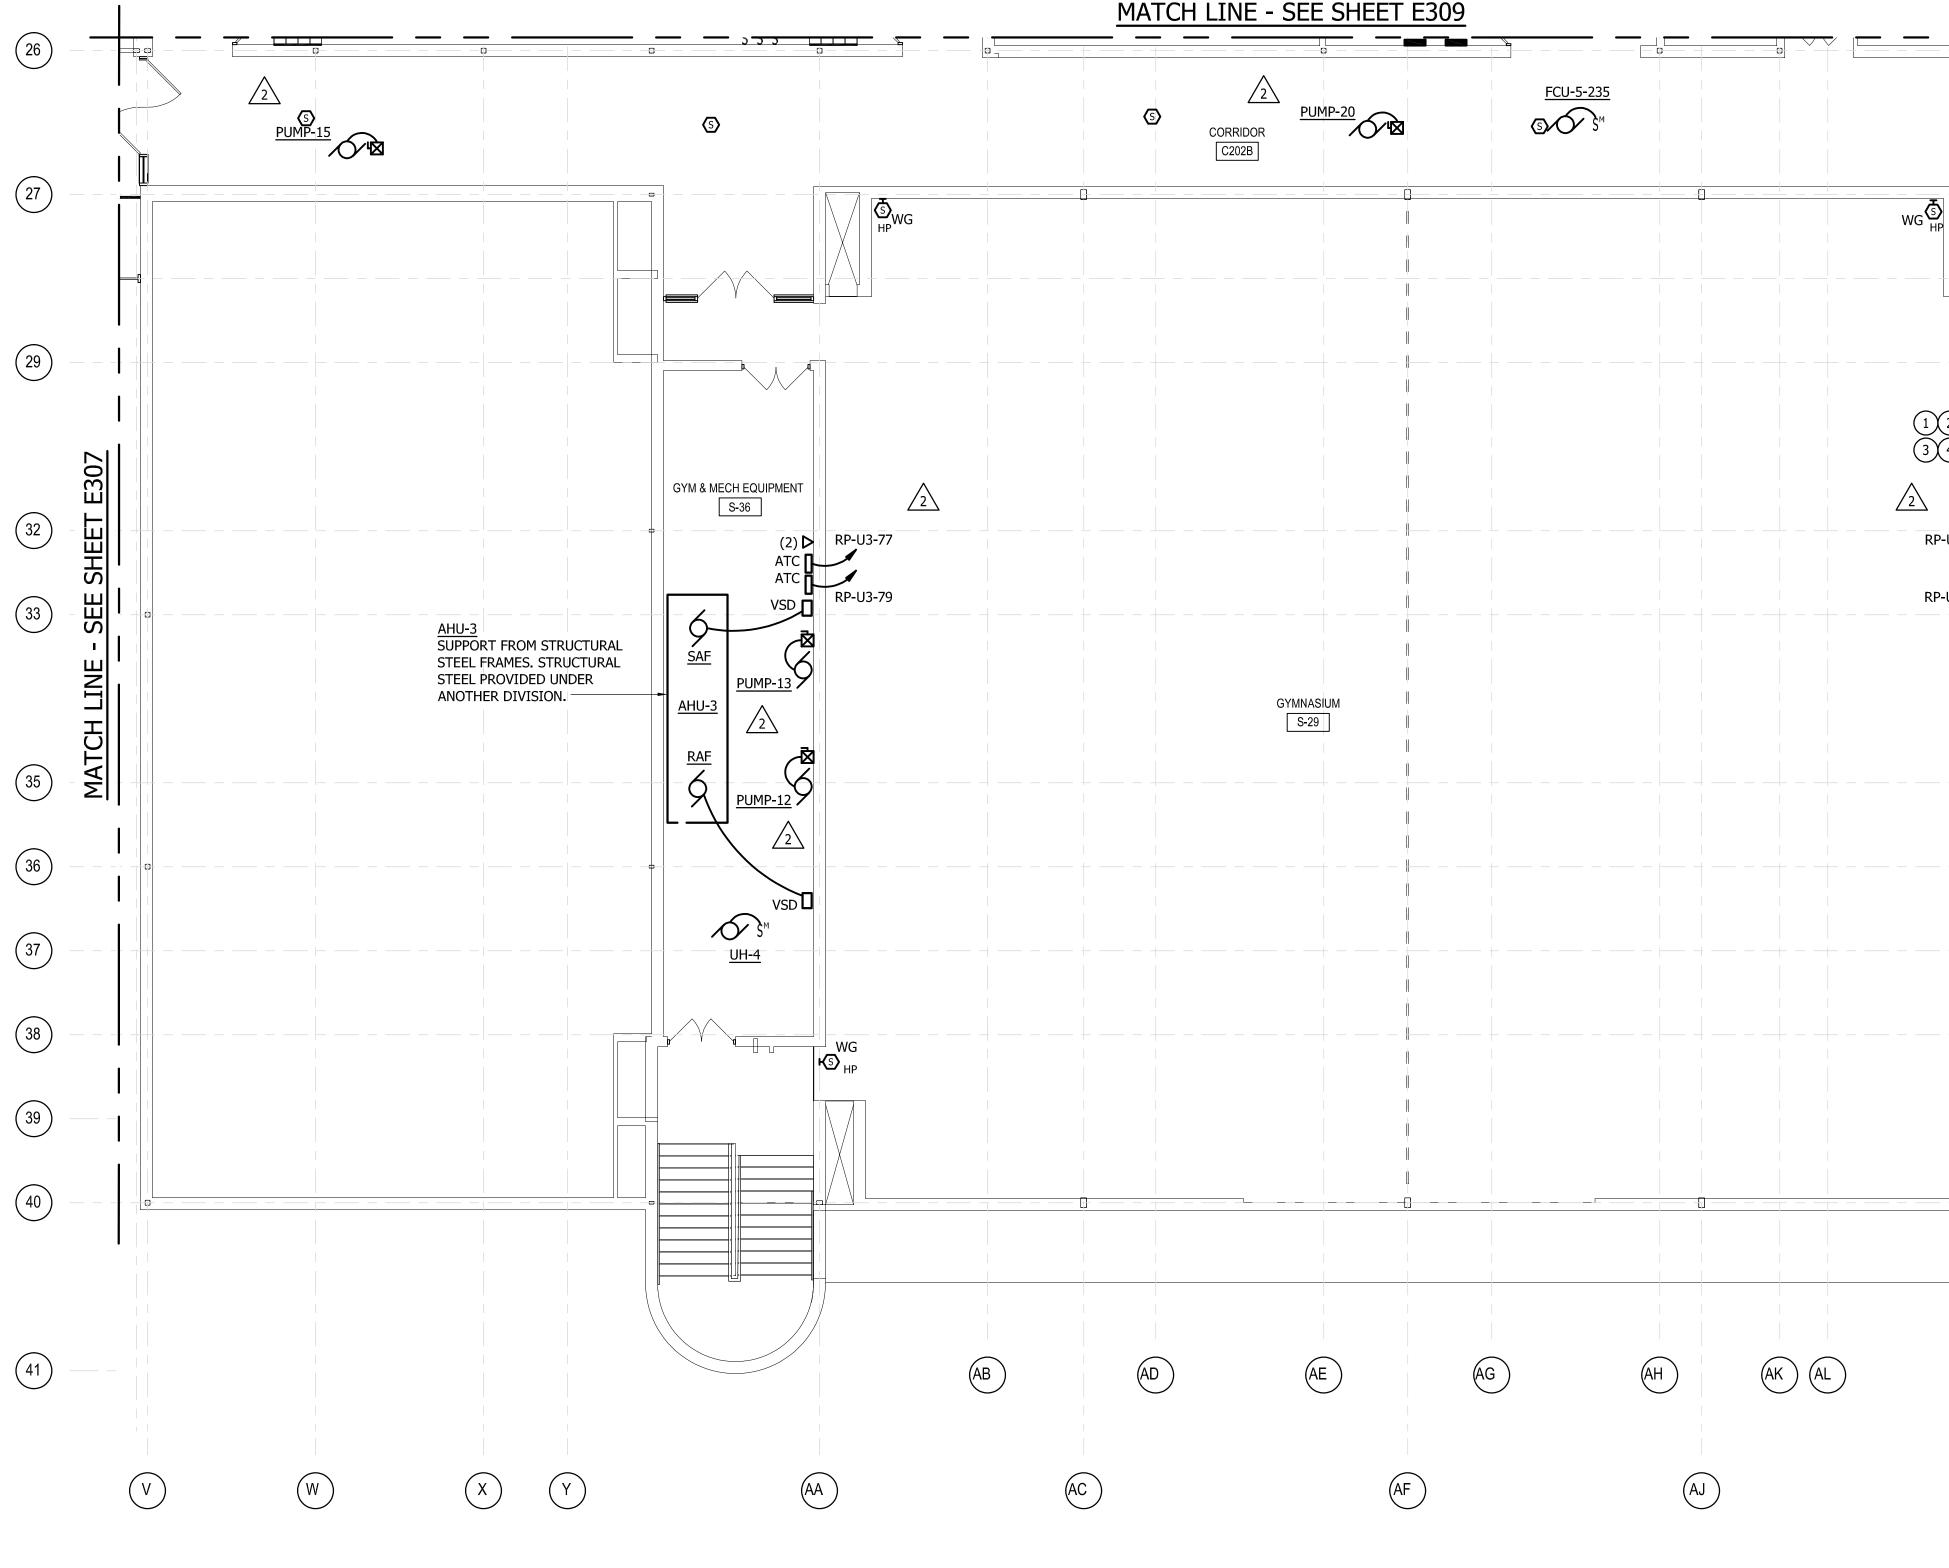

MATCH LINE - SEE SHEET E309

 $\underbrace{1}_{\text{E310}} \frac{\text{UPPER LEVEL AREA F - POWER}}{\text{SCALE: 1/8'' = 1'-0''}}$ 

# **GENERAL NOTES:**

1. REFER TO MECHANICAL EQUIPMENT CONNECTION SCHEDULE, DWGS. E608 THROUGH E610, FOR ADDITIONAL INFORMATION.

2. REINSTALL CEILING MOUNTED DEVICES - REFER TO DEMOLITION DRAWINGS.








3 <u>RP-U6</u> ECB (4) <u>RP-U7</u> ECB

<u>CUH-11</u> ∑S<sup>™</sup>  ${}^{\odot}$ EXXFMR RP-U3-8 RP-U3-83 —<u>AHU-2</u> MOUNT ON STRUCTURAL STEEL STRUCTURAL STEEL PROVIDED UNDER ANOTHER DIVISION 2 <u>PUMP-11</u> <u>AHU-2</u> VSD GYM & MECH EQUIPMENT S-35 <sup>₩Ġ</sup>IJ AP AQ AM AN ÂO AP

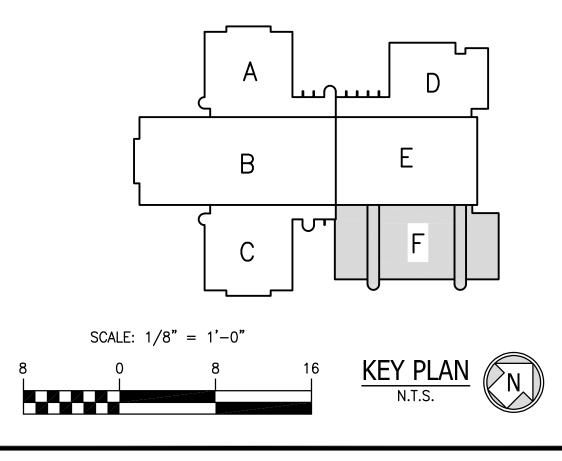

 $\overline{-}$ THIS I CONS ASSO ALTEF PART PERM COPY Gipe Associates In Consulting Engineers ID 21286 0.832.2420 832.2418 1220 I Suite Towsc Phone Fax: WO# 23043 PROJECT MANAGER EMP DESIGNER EMP date 2/26/2024 00 S DLE - AREA F EEN MJ UPPER LEVEL FLOOR PLAN - ELECTRICAL AB OLS SCI TONS Harford County Public Hvac Systemic Renovat 111 mt Royal Ave, Abere BID SUBMISSION  $\sim$ E310 4 PSC-12.006

EX PA	ANEI	L KP-U1				BACKB	ох			
VOLTA	GE:	208/120V, 3PH, 4W								
400 AM	IPERE	BUS		400A M	LO					
CONN			BR	EAKER		CIRCL	JIT WIR	ING		
KVA	скт	DESCRIPTION	Ρ	AMPS	NO	SIZE	GND	С	СКТ	DESCR
	1	REFRIGERATOR	1	20					2	MILK DISPEN
	3	REFRIGERATOR	1	20					4	CONVECTION
	5	SLICER	1	20					6	CONVECTION
	7	CASHIER	1	20					8	FOOD CUTTEI
	9	ICE CREAM	1	20					10	REFRIGERAT
	11	MILK DISPENSER	1	20					12	RECP
	13	CASHIER	1	20					14	RECP
	15	ICE CREAM	1	20					16	WALK-IN REF
	17	MILK DISPENSER	1	20					18	WASHER
	19	DRYER	2	30					20	FREEZER LT
	21	-	-	-					22	SPARE
	23	HOT FOOD WARMER	2	30					24	HOT FOOD W
	25	-	-	-					26	-
	27	HOT FOOD WARMER	2	20					28	WALK-IN LT/R
	29	-	-	-					30	WALK-IN LT/R
	31	GARBAGE DISPOSAL	3	20					32	REFRIGERAT
	33	-	-	-					34	COMPRESSO
	35	-	-	-					36	-
	37	WALK-IN FREEZER	3						38	SUBPANEL
	39	-	-	-					40	-
	41	-	-	-					42	-
TOTAL	CON	NECTED LOAD	0	KVA						KVA PER PHA

PANEL KP-U1 VOLTAGE: 208/120V, 3PH, 4W

400 AN	IPER	EBUS		400A M	LO					
CONN			BR	EAKER		CIRCL	JIT WIRI	NG		
KVA	скт	DESCRIPTION	Р	AMPS	NO	SIZE	GND	С	Скт	DESCRI
	1	REFRIGERATOR	1	20GFI					2	MILK DISPENS
	3	REFRIGERATOR	1	20GFI					4	CONVECTION
	5	SLICER	1	20GFI					6	CONVECTION
	7	CASHIER	1	20GFI					8	FOOD CUTTER
	9	ICE CREAM	1	20GFI					10	REFRIGERATO
	11	MILK DISPENSER	1	20GFI					12	RECP
	13	CASHIER	1	20GFI					14	RECP
	15	ICE CREAM	1	20GFI					16	WALK-IN REFF
	17	MILK DISPENSER	1	20GFI					18	WASHER
	19	DRYER	2	30GFI					20	FREEZER LT
	21	-	-	-					22	SPARE
	23	HOT FOOD WARMER	2	30GFI					24	HOT FOOD WA
	25	-	-	-					26	-
	27	HOT FOOD WARMER	2	20GFI					28	WALK-IN LT/RE
	29	-	-	-					30	WALK-IN LT/RE
	31	GARBAGE DISPOSAL	3	20					32	REFRIGERATO
	33	-	-	-					34	COMPRESSO
	35	-	-	-					36	-
	37	WALK-IN FREEZER	3						38	SUBPANEL
	39	-	-	-					40	-
	41	-	-	-					42	-
TOTAL	CON	NECTED LOAD	0	KVA						KVA PER PHA

VOL	.TAGE: 480/277				HORIZON	NTAL B	US: 120	0A							A.I.C. RATING: 65,000	0
	ATION: MECH RM 208														1200 AMPERE MLO	
СКТ					CIRCUI	Γ BREA	KER			VIRING			START	ER		CONN
NO	SERVES	HP	κw	Р	FRAME		SETS	NO	SIZE	GND	С	SIZE	TYPE	AUX	REMARKS	KVA
1	DHWC-7	1/2														
2	EF-4 S/ AHU-1	3														
3	EF-5	3														
4	EF-6	3														
5	EF-7	3														
6	PUMP-13 AHU-1 PREHEAT	3/4														
7	HWP-16 H&V-1	3/4														
8	HWP-17 H&V-2	3/4														
9	EF-13 H&V-1	5														
10	AHU-8 (H&V-2 SHOPS)	1														
11	EF-11 H&V-2	5														
12	EF-12 KITCHEN HOOD VFD	5														
13	H&V-1 KITCHEN	1														
14	SAF-15 BOILER RM	15														
15	SPARE (CT FAN-1)	25														
16	SPARE	25														
17	SPARE	25														
18	SPARE	25														
19	SPARE	25														
20	SPARE	25														
21	PUMP-5 HW	40														
22	PUMP-6 HW	40														
23	SPACE															
24	PUMP-1 CHW	50														
25	PUMP-2 CHW	50														
26	SPACE															
27	AHU-1	75														
28	AHU-3 SAF-3	60														
29	AHU-2 SAF-2 ADMIN MEDIA CLSRN	60														
30	CW PUMP-3	60														
31	CW PUMP-4	60														
32	SPACE															
33	SPACE															
34	SPACE						1									
35	SPACE												İ			

MOTOR STARTER AUXILIARY DEVICESA120 VOLT CONTROL POWER TRANSFORMER

B RED "ON" INDICATEING LIGHT

C GREEN "OFF" INDICATING LIGHT

D HAND-OFF-AUTOMATIC SELECTOR SWITCH E 2-NO, 2-NC AL

AUXILIARY	CONTACTS		
			-

	DISTRIBUTION PANEL MCC1							
MOL	INTING: SURFACE		A.I.C. R4	TING:				
VOL	TAGE: 480/277, 3 PHASE, 4 WIRE		A MAIN	BUS				
			DISTRI	BUTIC	N SEC	CTIO	N	
FDR		CIR		EAKER			WIRING	
NO	SERVES	Ρ	FRAME	TRIP	SETS	NO	SIZE	Ģ
1	OIL PUMP			15				
2	SPARE			15				
3	SPARE			15				
4	SPARE			15				
5	SPARE			20				
6	SPARE			15				
7	?			20				
8	SPARE			20				
9	SPARE			20				
10	SPARE			20				
11	SPARE			20				
12	SPARE			20				
13	SPARE			50				
14	?			20				
15	HWP-20&21, EF-10, AHU-5, AHU-6, EF-8			50				
16	BOILER-2			30				
17	EF-9. AHU-4, AHU-9, HWP-18&19			60				
18	COMPRESSOR			30				
19	?			60				
20	BOILER-1			30				
						тс	TAL CON	INE

	MO	UNTING	: RE	CESSE	D		
	LO	CATION	: KI	CHEN			
100% RATE	) NE	UTRAL	BUS			22,000	A.I.C.
	BR	EAKER		CIRCL	IIT WIR	ING	CONN
IPTION	Ρ	AMPS	NO	SIZE	GND	С	KVA
SER	1	20					
OVEN	1	20					
OVEN	1	20					
२	1	20					
OR WALL	1	20					
	1	20					
	1	20					
RIGERATOR	1	20					
	1	20					
	1	20					
	1	40					
ARMER	2	20					
	-	-					
ECP	1	20					
ECP	1	20					
OR	3	20					
R	-	-					
	-	-					
	3	100					
	-	-					
	-	-					
ASE:	Α	0	В	0	С	0	

				D		
) NE	UTRAL	BUS			22,000	A.I.C.
BR	EAKER		CIRCU	IT WIR	ING	CONN
Р	AMPS	NO	SIZE	GND	С	KVA
1	20GFI					
1	20GFI					
1	20					
1	40					
2	20GFI					
-	-					
1	20GFI					
1	20GFI					
3	20					
-	-					
-	-					
3	100					
-	-					
-	-					
A	0	В	0	С	0	
	LOO NE BRI P 1 1 1 1 1 1 1 1 1 1 1 1 1	LOCATION       DEUTRAL       BREAKER       P       AMPS       1     20GFI       3     20       1     -       3     100       1     -       3     100	LOCATION: KIT         NEUTRAL BUS         BREAKER       NO         I       20GFI       I         1       20GFI       I         2	INPERIMENTION: KITCHEN         DEUTRAL BUS         BREAKER       CIRCU         P       AMPS       NO       SIZE         1       20GFI       A       A         2       20GFI       A       A         1       20GFI       A       A         2       20GFI       A       A         3       20       A       A         3       20       A       A	BREAKER       CIRCUTVIR         P       AMPS       NO       SIZE       GND         1       20GFI       I       I       I         1       20GFI       I       I       I	Delutral BUS       22,000         BREAKER       CIRCUT WIRING         P       AMPS       NO       SIZE       GND       C         1       20GFI       I       I       I       I         1       20GFI       I       I       I       I       I         1

	TAL CONNECTED LOAD IN KVA: 0
--	------------------------------


		LOCATION: MECHANICAL RO A MCB	OM	
GND	С	REMARKS		CONN KVA
	LOAD	); 	0.0	KVA

٦	DISTRIBUTION PAN				DISTRIBUTION PANEL DPM (ALT 1)
	MOUNTING: SURFACE VOLTAGE: 480/277, 3 PHA:	A.I.C. RATINO	,	LOCATION: MECHANICAL ROOM	MOUNTING: SURFACE A.I.C. RATING: 65,000 LOCATION: MECHANICAL RO VOLTAGE: 480/277, 3 PHASE, 4 WIRE 1200A MAIN BUS 1000A MCB
F	FDR	CIRCUIT BREAKE		CONN	DISTRIBUTION SECTION         FDR       CIRCUIT BREAKER       WIRING         NO       SERVES       P       FRAME       TRIP       SETS       NO       SIZE       GND       C       REMARKS
	NO         SER'           1         PUMP-1	3 60 40	0 1 3 8 10 3/4	REMARKS   KVA     17.4	
_	2 PUMP-2 3 PUMP-3 4 PUMP-4	3         60         40           3         125         125           3         125         125	5 1 3 2 6 1 1/4		4         3         PUMP-3         3         60         40         1         3         8         10         3/4           0         4         PUMP-4         3         60         40         1         3         8         10         3/4
	5         PUMP-5           6         PUMP-6	3         30         15           3         30         15           3         30         15	5 1 3 12 12 3/4	6.3 6.3	5         PUMP-5         3         60         40         1         3         8         10         3/4           6         PUMP-6         3         30         25         1         3         10         10         3/4
	7 PUMP-7 8 PUMP-8 9 PUMP-9	3         30         15           3         100         70           3         100         70	0 1 3 6 8 3/4	STANDBY         0.0           28.2           STANDBY	8         PUMP-8         3         30         25         1         3         10         10         3/4           9         SPACE         3         100         4         4         4
	9         POMP-9           10         PANEL MP           11         DOAS-1	3         100         70           3         225         225           3         60         35	5 1 3 4/0 4 2	STANDBY         0.0           133.9         13.7	.9         10         PANEL MP         3         225         225         1         3         4/0         4         2           11         DOAS-1         3         60         35         1         3         8         10         1
	12 DOAS-2 13 DOAS-3	3         100         80           3         100         80           3         100         80	0 1 3 2 8 1-1/2	33.2	13         DOAS-3         3         100         80         1         3         2         8         1-1/2           14         DOAS 4         2         100         70         1         2         8         1-1/2
	14         DOAS-4           15         DOAS-5           16         AHU-1	3         100         70           3         100         80           3         60         60	0 1 3 2 8 1-1/2	33.2	3         15         DOAS-5         3         100         80         1         3         2         8         1-1/2           16         AHU-1         3         60         40         1         3         8         10         1
	17 AHU-4 18 AHU-5	3         60         50           3         30         40	0 1 3 6 10 1	20.4 13.3	3         3         30         30         1         3         8         10         1           3         30         30         30         1         3         8         10         1
	19 AHU-6 20 21	3 30 40	0 1 3 6 10 1	12.9	9         20         0         00         0         0         0         1         1           21
	22 23				22         23         23         24         24         24<
	24 25 26				25         26         26         27         28         27         28         27         27         <th27< th="">         27         27         27<!--</td--></th27<>
	27 28				27         28         1         1         	~~~~~~~~~~~~~~~~~~~~~~~~~~~~~~~~~~~~~~~	~~~~~~~~~~~~~~~~~~~~~~~~~~~~~~~~~~~~~~~			
<b>EL MP</b> AGE: 480/2 MPERE BL	277, 3PH, 4W JS	*GFEP TYPE (SECTION I)	L	MOUNTING: SURFACE LOCATION: MECHANICAL RM NEUTRAL BUS 42K A.I.C.	PANEL MP (ALT 1)       MOUNTING: SURFACE         VOLTAGE: 480/277, 3PH, 4W       LOCATION: MECHANICAL RM         .C.       225A AMPERE BUS       225A MCB
скт	DESCRIPTION	FUSE     CIRCUIT WIRING       P     AMPS     NO     SIZE     GND     C		FUSE     CIRCUIT WIRING     CONN       P     AMPS     NO     SIZE     GND     C     KVA	
3 -	DILER-1	3     30     3     10     10     3/4       -     -     -     -     -     -	2 BOILER-2 4 -	3     30     3     10     10     3/4     3.3       -     -     -     -     -     3.3	3 3 SPACE 4 SPACE 4 SPACE
5 - 7 BO 9 -	DILER-3	-     -     -     -     -       3     30     3     10     10     3/4	6 - 8 AHU-2 SAF 10 -	-     -     -     -     3.3       3     20     3     10     10     3/4     3.0       -     -     -     -     -     3.0	0 7 SPACE 8 AHU-2 SAF 3 20 3 10 10
11 -	IU-3 SAF	-         -         -         -         -           3         20         3         10         10         3/4	12 - 14 AHU-2 RAF	-         -         -         -         3.0           3         15         3         10         10         3/4         1.9	0 11 SPACE
15 - 17 -	IU-3 RAF	-         -         -         -         -           -         -         -         -         -         -           3         15         3         10         10         3/4	16 - 18 - 20 PUMPS 10, 11, 12, 13, 14, 15, 20	-         -         -         -         1.9           -         -         -         -         -         1.9           3         15         3         10         10         3/4         2.7	9 3.0 17 18
21 - 23 -		-     -     -     -     -       -     -     -     -     -	22 - 22 - 24 -	<u>-</u> 2.7 2.7	7 1.9 21 22
27 FC	U-5-101 THRU FCU-5-110 U-5-111 THRU FCU-5-120 U-5-121 THRU FCU-5-129		26         FCU-5-201         THRU FCU-5-210           28         FCU-5-211         THRU FCU-5-220           30         FCU-5-221         THRU FCU-5-229	1     15     2     12     12     3/4     3.9       1     15     2     12     12     3/4     3.9       1     15     2     12     12     3/4     3.5	9       3.9       27       FCU-5-111 THRU FCU-5-120       1       15       2       12       12       3/4       28       FCU-5-211 THRU FCU-5-220       1       15       2       12       12
31 FC	U-5-130 THRU FCU-5-134 U-5-230 THRU FCU-5-235	1         15         2         12         12         3/4           1         15         2         12         12         3/4           1         15         2         12         12         3/4           1         15         2         12         12         3/4	30         FC0-3-221 THRO FC0-3-229           32         HEAT TRACE           34         HEAT TRACE	1         15         2         12         12         3/4         3.5           1         20*         2         10         10         1         2.0           1         20*         2         10         10         1         2.0	0 1.9 31 FCU-5-130 THRU FCU-5-134 1 15 2 12 12 3/4 32 SPACE
37 HE	AT TRACE	1     20*     2     10     10     1       1     20*     2     10     10     1       1     20*     2     10     10     1	36     SPARE       38     PANEL MRP	1         20	
41 HE	AT TRACE AT TRACE DAD (SECTION I)	1         20*         2         10         10         1           1         20*         2         10         10         1           130.3 KVA         130.3 KVA         10         1         1	40 VIA XFMR T10 42 - KVA PER PHASE:	-     -     -     -     11.6       -     -     -     -     -     11.5       A     44.803     B     43.956     C     41.535	
EL MP		( SECTION II)		MOUNTING: SURFACE	PANEL MP (ALT 1) (SECTION II) MOUNTING: SURFACE
	277, 3PH, 4W JS	225A       BREAKER       CIRCUIT WIRING	L 100% RATED	LOCATION: MECHANICAL RM NEUTRAL BUS 42K A.I.C.	VOLTAGE: 480/277, 3PH, 4W     LOCATION: MECHANICAL RM       .C.     225A AMPERE BUS     225A       100% RATED NEUTRAL BUS     Image: Constraint of the second
СКТ 43 FA	DESCRIPTION	BREAKER     CIRCUIT WIRING       P     AMPS     NO     SIZE     GND     C       3     15     3     12     12     3/4		BREAKER     CIRCUIT WIRING     CONN       P     AMPS     NO     SIZE     GND     C       3     15     3     12     12     3/4     0.6	A     BREAKER     BREAKER <t< td=""></t<>
45 - 47 -			46 - 48 -	0.6 0.6	6     0.6     45     -     -     -     -     -     -     46     -     -     49 SP 51 - 53 -	ARE	3     15       -     -       -     -       -     -	50         SPARE           52         -           54         -	3     15       -     -       -     -       -     -	49       SPARE       3       15       50       SPARE       3       15       50         51       -       -       -       -       -       52       -       -       55 SP. 57 -	ARE	3     30       -     -	56         SPARE           58         -	3     30       -     -       -     -	53       -       -       -       -       -       54       -       -       59 - 61 SP 63 SP		-     -     -     -     -       1     20	60 - 62 SPACE 64 SPACE	 1 20	59       -       -       -       -       60       -       -       65 SP	ARE	1         20           1         20           1         20	66     SPACE       68     SPACE	1     20       1     20       1     20	63       SPARE       1       20       64       SPACE       1       20       64         65       SPARE       1       20       66       SPACE       1       20       66         67       SPARE       1       20       68       SPACE       1       20       68
69 SP 71 SP 73 SP	ARE	1     20       1     20	70SPACE72SPACE74SPACE	1     20       1     20	69         SPARE         1         20         70         SPACE         1         20            71         SPARE         1         20         72         SPACE         1         20         1         20         1         1         20         1         20         1         1         20         1         1         20         1         1         20         1         1         20         1         1         20         1         1
73 SP 75 SP 77 SP	ACE		74     SPACE       76     SPACE       78     SPACE	1	73       SPACE       1       74       SPACE       1       1       1         75       SPACE       1       76       SPACE       1       1       1       1         77       SPACE       1       78       SPACE       1       1       1       1       1
79 SP 81 SP 83 SP	ACE	1	80SPACE82SPACE84SPACE	1	79         SPACE         1         80         SPACE         1             81         SPACE         1         82         SPACE         1
IECTED LC	DAD (SECTION II)	3.6 KVA 133.89 <b>KVA</b>	KVA PER PHASE:	A         1.2         B         1.2         C         1.2           A         46.003         B         45.156         C         42.735	83         SPACE         1         84         SPACE         1         I         I         <th< td=""></th<>
PANEL	MRP		N	MOUNTING: SURFACE	I TOTAL CONNECTED LOAD         102.89 KVA         KVA PER PHASE:         A 35.403         B 35.356         C 3           I PANEL MRP (ALT 1)         MOUNTING: SURFACE
VOLTAG	E: 208/120V, 3PH, 4W PERE BUS	150 A MCB	L	LOCATION: MECHANICAL ROOM NEUTRAL BUS 10,000 A.I.C.	VOLTAGE: 208/120V, 3PH, 4W         LOCATION: MECHANICAL ROO           D:         150 AMPERE BUS         100% RATED NEUTRAL BUS         1
CONN KVA (	CKT DESCRIPTION	BREAKER CIRCUIT WIRING P AMPS NO SIZE GND C	C CKT DESCRIPTION	BREAKER     CIRCUIT WIRING     CONN       P     AMPS     NO     SIZE     GND     C	A KVA CKT DESCRIPTION P AMPS NO SIZE GND C CKT DESCRIPTION P AMPS NO SIZE GND
0.2	1 FAN-1 3 UH-1 AND UH-2	1         15         2         12         12         3/           1         15         2         12         12         3/           2         15         3         12         12         3/	/4 4	3         30         4         8         10         1         2.1                 2.1	0.4         3         UH-1 AND UH-2         1         15         2         12         14         4           1         1.2         5         DSS 1         2         15         2         12         12         2/4         6
1.2 1.2 1.2	5 DSS-1 7 9 DSS-2	2     15     3     12     12     3/       2     15     3     12     12     3/	8 KITCHEN MAKE-UP UNIT	3         60         4         4         10         1-1/4         5.0	1.2       7        8       KITCHEN MAKE-UP UNIT       3       60       4       4       10       10         1.2       9       DSS-2       2       15       3       12       12       3/4       10       10       1.2	11 13 DSS-3	2 15 3 12 12 3/	12       /4     14       14     CHEMICAL SHOT       16     ATC PANEL	1         20         2         12         12         3/4         0.5           1         20         2         12         12         3/4         0.5	1.2     13     DSS-3     2     15     3     12     12     3/4     14     CHEMICAL SHOT     1     20     2     12     12       1     1     1.2 1.0 1.0	15        17     RECEPTACLE       19     GLYCOL FEED	1         20         2         12         12         3/           1         20         2         12         12         3/	/4 18 ATC PANEL	1     20     2     12     12     3/4     0.5       1     20     2     12     12     3/4     0.5       1     20     2     12     12     3/4     0.5	1.0       17       RECEPTACLE       1       20       2       12       12       3/4       18       ATC PANEL       1       20       2       12       12         5       1.0       19       GLYCOL FEED       1       20       2       12       12       3/4       18       ATC PANEL       1       20       2       12       12
0.5	21 CHEMICAL SHOT 23 BOILER SHUT-DOWN 25 RECERTACIE	1         20         2         12         12         3/           1         20         2         12         12         3/           1         20         2         12         12         3/           1         20         2         12         12         3/	/4 24 SPACE		1.0       21       CHEMICAL SHOT       1       20       2       12       12       3/4       22       ATC PANEL       1       20       2       12       12         23       SPARE       1       20       2       12       12       24       SPACE       1       20       2       12       12         25       SPARE       1       20       20       2       12       26       SPACE       1       20       1       1       20       1       1       20       1       1       20       1       1       20       1       1       20       1       1       20       1       1       20       1       26       SPACE       1       1       <td< td=""></td<>
0.2	<ul><li>25 RECEPTACLE</li><li>27 FLOW METERS</li><li>29 SPARE</li></ul>	1         20         2         12         12         3/           1         20         2         12         12         3/           1         20         2         12         12         3/			27         SPARE         1         20         28         SPACE         0         0         </td
	31SPARE33SPARE	1     20       1     20	32SPACE34SPACE		31         SPARE         1         20         32         SPACE         1         1         20         32         SPACE         1         1         1         1         20         34         SPACE         1         1         1         20         34         SPACE         1         1         1         1         20         34         SPACE         1         1         1         1         1         1         20         34         SPACE         1         1         1         1         20         36         SPACE         1         1         1         1         20         36         SPACE         1         1         1         1         1         20         36         SPACE         1         1         	<ul><li>35 SPARE</li><li>37 SPARE</li><li>39 SPARE</li></ul>	1         20           1         20           1         20	36 SPACE 38 SPACE		35       SPARE       1       20       36       SPACE       1       1       <t< td=""></t<>
	39 SPARE 41 SPARE	1 20 1 20 35 KVA	40 SPACE 42 SPACE		39     SPARE     1     20     40     SPACE     1       41     SPARE     1     20     42     SPACE     1     1       TOTAL CONNECTED LOAD     35     KVA     KVA PER PHASE:     A     11.7     B     11.9     C     1
•		35 KVA		A 11.9 B 11.6 C 11.454	


	MOUNTING: SURFACE			ATING: 65,	,000			ON: MECHAN	NICAL ROOM	1	F	MOUNTING: SURFACE VOLTAGE: 480/277, 3 PHASE, 4		.I.C. RATIN 200A MAIN		00		LOCATION 1000A MCB		ANICAL RO
	VOLTAGE: 480/277, 3 PHA	ISE, 4 WIRE	DISTRI		SECTION		1000A N	ICB			Ē									
	FDR NO SEF	VES	CIRCUIT BRE		WIRING ETS NO SIZE		С	REMAR	٢S	CONN KVA	ļ	FDR NO SERVES	P	UIT BREAK	RIP SE		GND C		REMA	RKS
	1 PUMP-1 2 PUMP-2		3 60 3 60	40 40	1         3         8           1         3         8		3/4 3/4			17.4 17.4	-	1 PUMP-1 2 PUMP-2	3	100 1	00 1 00 1	3 3 3 3	8 1-1 8 1-1	/4		
$\left  \right $	3         PUMP-3           4         PUMP-4		3         125           3         125	125 125	1         3         2           1         3         2		1/4   1/4	STANDE	3Y	54.0 0.0	-	3 PUMP-3 4 PUMP-4 5 PUMP-5	3 3 3	60 4	10 1 10 1	3 8 3 8 3 8	10 3/- 10 3/- 10 3/-	4		
	5 PUMP-5 6 PUMP-6		3 30 3 30	15 15	1         3         12           1         3         12		3/4 3/4			6.3 6.3	-	5 PUMP-5 6 PUMP-6 7 PUMP-7	3	30 2	10 1 25 1 25 1	3 8 3 10 3 10	10 3/4 10 3/4 10 3/4	4		
$\left  \right $	7         PUMP-7           8         PUMP-8		3 30 3 100	15 70	1         3         12           1         3         6		3/4 3/4	STANDE		0.0 28.2	-	7         POMP-7           8         PUMP-8           9         SPACE	3		25 1 25 1	3 10	10 3/- 10 3/-			
	9 PUMP-9 10 PANEL MP		3         100           3         225	70 225	1         3         6           1         3         4/0	4	3/4 2	STANDE	3Y	0.0 133.9	-	9         SPACE           10         PANEL MP           11         DOAS-1	3	225 2	25 1 35 1	3 4/0	4 2			
ŀ	11         DOAS-1           12         DOAS-2		3 60 3 100	35 80	1         3         8           1         3         2		1			13.7 33.2	-	12 DOAS-2 13 DOAS-3	3	100 8	30 1 30 1	3         2           3         2	8 1-1 8 1-1			
	13         DOAS-3           14         DOAS-4		3 100 3 100	80 70	1         3         2           1         3         3	8 1	-1/2  -1/4			33.2 25.3	-	14 DOAS-4 15 DOAS-5	3	100 7	70 1 30 1	3 3 3 2	8 1-1 8 1-1	/4		
	15 DOAS-5 16 AHU-1		3 100 3 60	80 60	1         3         2           1         3         4           1         2         2	10 1	-1/2			33.2 24.5	-	16 AHU-1 17 AHU-4	3	60 4	10 1 10 1	3 8 3 8	10 1 10 1			
┠	17 AHU-4 18 AHU-5		3 60 3 30	50 40	1         3         8           1         3         6	10	1			20.4	-	18 AHU-5 19 AHU-6	3	30 3	30 1 30 1	3 8 3 8	10 1 10 1			
ŀ	19 AHU-6 20		3 30	40	1 3 6	10	1			12.9	-	20 21								
	21 22										-	22 23								
	23 24										-	24 25								
ŀ	25 26										-	26 27								
ŀ	27 28										ŀ	28								
]	~~~~~~~~~~~~~~~~~~~~~~~~~~~~~~~~~~~~~~~	~~~~~~~~~~~~~~~~~~~~~~~~~~~~~~~~~~~~~~~	~~~~~~~~~~~~~~~~~~~~~~~~~~~~~~~~~~~~~~~	~~~~	TOTAL CO					3.4 KVA										
ЛР	0/277, 3PH, 4W	*GFEP TYPE					MOUNTIN	G: SURFACE N: MECHANIC	AL RM	42K A.I.C.		EL MP (ALT 1) AGE: 480/277, 3PH, 4W AMPERE BUS	225A MCB					MOUNTING: S LOCATION: N ED NEUTRAL BU	SURFACI /IECHANI	E
кт	DESCRIPTION		CIRCUIT WIRING	3 С СКТ	DESCRIF		FUSE P AMPS		IT WIRING GND C	CONN KVA		CKT DESCRIPTION				KT DESCR	RIPTION	FUSE P AMPS N		
-	OILER-1	P         AMPS         NO           3         30         3			BOILER-2		3 30	NO         SIZE           3         10	10 3/4	3.3		1 SPACE				2 SPACE				
, <u>-</u>				- 4 - 6	- -					3.3		3 SPACE 5 SPACE				4 SPACE 3 SPACE				
B  -	OILER-3	3 30 3	10 10 3	3/4 8 - 10	AHU-2 SAF -		3 20	3 10 	10 3/4 	3.0		7 SPACE 9 SPACE				3 AHU-2 SAF 0 -		3 20 3	3 10 	-
- A	HU-3 SAF	-     -     -       3     20     3	 10 10 3		- AHU-2 RAF		3 15	 3 10	 10 3/4		3.0	11 SPACE 13 AHU-3 SAF	3 20 3 10	10	3/4	2 - 4 AHU-2 RAF		3 15 3	 3 10	- 10
-				- 16 - 18	- -					1.9 1.9	3.0 3.0	15 - 17 -		-	- /	6 - 8 -				
A -	HU-3 RAF	3     15     3       -     -     -	10 10 3 	3/4 20 - 22	PUMPS 10, 11, 12 -	2, 13, 14, 15	5, 2 <b>0</b> 3 15	3 10 	10 3/4 	2.7	1.9 1.9	19 AHU-3 RAF 21 -	3 15 3 10 	-	- 2	0 PUMPS 10, 1 2 -	1, 12, 13, 14,	1 3 15 3	3 10 	- 10
- F	CU-5-101 THRU FCU-5-110	 1 15 2	 12 12 3				 1 15	 2 12	 12 3/4	2.7 3.9	1.9 3.9	23 - 25 FCU-5-101 THRU FCU-5-110	 1 15 2 12		3/4 2	4 - 6 FCU-5-201 TH			 2 12	- 12 ;
	CU-5-111 THRU FCU-5-120 CU-5-121 THRU FCU-5-129	1     15     2       1     15     2			FCU-5-211 THRU FCU-5-221 THRU		1 15 1 15	2 12 2 12	12 3/4 12 3/4		3.5	27 FCU-5-111 THRU FCU-5-120 29 FCU-5-121 THRU FCU-5-129	1 15 2 12			8 FCU-5-211 TH 0 FCU-5-221 TH				
+	CU-5-130 THRU FCU-5-134 CU-5-230 THRU FCU-5-235	1     15     2       1     15     2			HEAT TRACE		1 20* 1 20*	2 10 2 10	10 1 10 1	2.0		31         FCU-5-130         THRU FCU-5-134           33         FCU-5-230         THRU FCU-5-235				2 SPACE 4 SPACE				
	EAT TRACE EAT TRACE	1     20*     2       1     20*     2	10     10       10     10		SPARE PANEL MRP		1 20 3 90	REFER TO XI	FMR SCHEDULE	11.9		35 SPARE 37 SPARE	1     20       1     20			6 SPACE 8 PANEL MRP		3 90	REFER TO	XFMR SCHED
_	EAT TRACE EAT TRACE	1     20*     2       1     20*     2	10     10       10     10	1 40 1 42	VIA XFMR T10 -					11.6 11.5		39 SPARE 41 SPARE	1         20           1         20			0 VIA XFMR T10 2 -	)			-
DI	OAD (SECTION I)	130.3 KVA			KVA PER PHASE		A 44.803	B 43.956	C 41.5	35	CONN	ECTED LOAD (SECTION I)	99.3 KVA			KVA PER PH	ASE:	A 34.203	B 34.15	56 C 30
<b>)</b>		(	SECTION II)					G: SURFACE				EL MP (ALT 1)	( SEC	CTION II)				MOUNTING: S		
	0/277, 3PH, 4W 3US	225A				100% RAT	TED NEUTRAL			42K A.I.C.		AGE: 480/277, 3PH, 4W AMPERE BUS	225A				100% RATE	LOCATION: N		
T	DESCRIPTION	P AMPS NO		с скт		TION		NO SIZE			CONN KVA	CKT DESCRIPTION			G C C	KT DESCF	RIPTION	BREAKER P AMPS N		CUIT WIRING
F. -	AN-4	3         15         3           -         -         -	12 12 3 	- 46	FAN-5 -		3 15	3 12 	12 3/4 	0.6		43 FAN-4 45 -	3         15         3         12           -         -         -         -         -	12		4 FAN-5 6 -		3 15 3	3 12 	12 :
- S	PARE	 3 15			- SPARE		3 15			0.6		47 - 49 SPARE	 3 15	-	- 4	8 - 0 SPARE		· 3 15		
- 3 -				- 52 - 54								51 - 53 -	 	-	- !	2 - 4 -		·		
7 -	PARE	3 30 		- 58	SPARE -		3 30 					55 SPARE 57 -	3 30 		- !	6 SPARE		3 30		
	PARE	 1 20			- SPACE		 1 20					59 - 61 SPARE	 1 20	-	- (	0 - 2 SPACE		·		
5 S	PARE PARE	1     20       1     20		66	SPACE SPACE		1 20 1 20					63 SPARE 65 SPARE	1     20       1     20       1     20		(	4 SPACE		1     20       1     20       1     20		+
) s	PARE PARE	1     20       1     20		70	SPACE SPACE		1 20 1 20					67 SPARE 69 SPARE	1         20           1         20           1         20			8 SPACE		1 20 1 20 1 20		+++
_	PARE PACE	1     20       1		72	SPACE SPACE		1 20 1					71 SPARE 73 SPACE	1 20 1 20		-	2 SPACE		1 20		+
7 S	PACE PACE	1		78	SPACE SPACE		1					75 SPACE 77 SPACE				6 SPACE		1		+++
31 S	PACE PACE	1		82	SPACE SPACE		1					79 SPACE 81 SPACE			8	0 SPACE		1		+
33 S	DACE OAD (SECTION II)	1 3.6 KVA		84	SPACE KVA PER PHASE	:	1 A 1.2	P. B. 1.2	C ,	1.2		83 SPACE	261010			4 SPACE		1	R 4	
	ECTED LOAD	133.89 <b>KVA</b>			KVA PER PHASE			B 45.156				ECTED LOAD (SECTION II) _ CONNECTED LOAD	3.6 KVA 102.89 <b>KVA</b>			KVA PER PH KVA PER PH		A 1.2 A 35.403		.2 C 56 C 3
ANE							MOUNTIN	G: SURFACE			PANE	L MRP (ALT 1)						MOUNTING: \$	SURFAC	
DLTA	GE: 208/120V, 3PH, 4W PERE BUS	150 A	МСВ			100% RAT	LOCATIOI TED NEUTRAL	I: MECHANIC . BUS		00 A.I.C.		GE: 208/120V, 3PH, 4W PERE BUS	150 A MCB				100% RATE	LOCATION: M D NEUTRAL BU		
	CKT DESCRIPTION	BREAKER	CIRCUIT WIR O SIZE GND				BREAKER	CIRCU NO SIZE	IT WIRING	CONN	CONN KVA		BREAKER CIRC P AMPS NO SIZE		) C Cł	T DESCR	IPTION	BREAKER P AMPS NO		
.VA ).2	1 FAN-1	1 15 2			2 KITCHEN EXH		3 30	4 8	10 1	2.1	0.2	1 FAN-1	1 15 2 12	12 3	3/4 2	KITCHEN EXH		3 30 4	8	10
4 2	3 UH-1 AND UH-2 5 DSS-1	1 15 2 2 15 3			4 6					2.1 2.1	1.2		1         15         2         12           2         15         3         12		3/4 4 3/4 6					
	7 9 DSS-2	2 15 3			8 KITCHEN MAR	E-UP UNIT	3 60	4 4	10 1-1/			9 DSS-2	2 15 3 12	12 :	3/4 1		e-up unit	3 60 4	4	10 1
		2 15 3			12 14 CHEMICAL SH	IOT	1 20	2 12	12 3/4	5.0	1.2	11 13 DSS-3	2 15 3 12	12 :		2 4 CHEMICAL SH	IOT	1 20 2	. 12	
2 		1 20 2			16 ATC PANEL 18 ATC PANEL		1 20 1 20	2 12 2 12	12 3/4 12 3/4	0.5	1.0	15 17 RECEPTACLE	1 20 2 12		3/4 1	ATC PANEL ATC PANEL		1     20     2       1     20     2	12 12	
.2 .2 .2 .2		1 20 2 1 20 2	. 12 12	3/4	20 ATC PANEL 22 SPACE		1 20	2 12	12 3/4		1.0	19GLYCOL FEED21CHEMICAL SHOT	1         20         2         12           1         20         2         12		3/4 2	ATC PANEL ATC PANEL		1     20     2       1     20     2	12 12	12 3 12 3
.2 .2 .2 .2 .0 .0	19     GLYCOL FEED       21     CHEMICAL SHOT				24 SPACE							23SPARE25SPARE	1 20 1 1 20		2	4 SPACE 6 SPACE				
.2 .2 .2 .0 .0 .0 .0 .5	<ol> <li>19 GLYCOL FEED</li> <li>21 CHEMICAL SHOT</li> <li>23 BOILER SHUT-DOWN</li> </ol>	1 20 2 1 20 2	. 12 12	3/4	26 SPACE							27 SPARE				3 SPACE				
1.0 0.5 0.2	<ol> <li>19 GLYCOL FEED</li> <li>21 CHEMICAL SHOT</li> <li>23 BOILER SHUT-DOWN</li> <li>25 RECEPTACLE</li> <li>27 FLOW METERS</li> </ol>	1 20 2 1 20 2		3/4	28 SPACE					-∥		29 SPARE	1 20 1 20			SPACE SPACE				
1.2         1.2         1.2         1.2         1.0         1.0         0.5         0.2	<ol> <li>19 GLYCOL FEED</li> <li>21 CHEMICAL SHOT</li> <li>23 BOILER SHUT-DOWN</li> <li>25 RECEPTACLE</li> <li>27 FLOW METERS</li> <li>29 SPARE</li> <li>31 SPARE</li> </ol>	1     20     2       1     20     2       1     20     2       1     20       1     20		3/4	<ul><li>28 SPACE</li><li>30 SPACE</li><li>32 SPACE</li></ul>										3					
.2 .2 .2 .0 .0 .0 .0 .5 .2	<ol> <li>GLYCOL FEED</li> <li>CHEMICAL SHOT</li> <li>BOILER SHUT-DOWN</li> <li>RECEPTACLE</li> <li>FLOW METERS</li> <li>SPARE</li> <li>SPARE</li> <li>SPARE</li> <li>SPARE</li> <li>SPARE</li> <li>SPARE</li> </ol>	1     20     2       1     20     2       1     20     2       1     20     1       1     20     1       1     20     1       1     20     1       1     20     1		3/4	<ul><li>28 SPACE</li><li>30 SPACE</li><li>32 SPACE</li><li>34 SPACE</li><li>36 SPACE</li></ul>							29SPARE31SPARE	1 20 1 1 20		3 3 3 3	2 SPACE 2 SPACE				
1.2         1.2         1.2         1.2         1.0         1.0         0.5         0.2	<ol> <li>GLYCOL FEED</li> <li>CHEMICAL SHOT</li> <li>BOILER SHUT-DOWN</li> <li>RECEPTACLE</li> <li>FLOW METERS</li> <li>SPARE</li> <li>SPARE</li> <li>SPARE</li> </ol>	1         20         2           1         20         2           1         20         2           1         20         1           1         20         1           1         20         1           1         20         1		3/4	<ul><li>28 SPACE</li><li>30 SPACE</li><li>32 SPACE</li><li>34 SPACE</li></ul>							<ul><li>29 SPARE</li><li>31 SPARE</li><li>33 SPARE</li><li>35 SPARE</li></ul>	1     20       1     20       1     20       1     20       1     20		3 3 3 3 3 3 4	<ul> <li>SPACE</li> <li>SPACE</li> <li>SPACE</li> <li>SPACE</li> <li>SPACE</li> </ul>				

	DISTRIBUTION PAN				DISTRIBUTION PANEL DPM (ALT 1) MOUNTING: SURFACE A.I.C. RATING: 65,000	LOCATION: MECHANICAL RO
	MOUNTING: SURFACE VOLTAGE: 480/277, 3 PHA	·	BUS	LOCATION: MECHANICAL ROOM 1000A MCB	MOUNTING: SURFACE     A.I.C. RATING: 65,000       VOLTAGE: 480/277, 3 PHASE, 4 WIRE     1200A MAIN BUS       DISTRIBUTION SECTIO	1000A MCB
	FDR	CIRCUIT BREAK		CON	N FDR CIRCUIT BREAKER	WIRING
	NO         SER*           1         PUMP-1		40 1 3 8 10 3			3         8         1-1/4           3         8         1-1/4
	2 PUMP-2 3 PUMP-3	3 125 12	25 1 3 2 6 1	/4 17.4 1/4 54.0	3         PUMP-3         3         60         40         1         3           0         4         PUMP-4         3         60         40         1         3	3         3         1-1/4           8         10         3/4           8         10         3/4
	4 PUMP-4 5 PUMP-5 6 PUMP-6	3 30 1	15         1         3         12         12         3	1/4         STANDBY         0.0           /4         6.3         6.3           /4         6.3         6.3	5         PUMP-5         3         60         40         1         3           6         PUMP 6         3         30         25         1         3	8         10         3/4           10         10         3/4
	7 PUMP-7 8 PUMP-8	3 30 1	15 1 3 12 12 3	4         6.3           74         STANDBY         0.0           74         28.2	7         PUMP-7         3         30         25         1         3           8         PUMP 8         3         30         25         1         3	10         10         3/4           10         10         3/4
	9 PUMP-9 10 PANEL MP	3 100 7	70 1 3 6 8 3	Y4         STANDBY         0.0           2         133.	9         SPACE         3         100           9         10         PANEL MP         3         225         225         1         3	4/0 4 2
	11 DOAS-1 12 DOAS-2	3 60 3	35         1         3         8         10           30         1         3         2         8         1-	1 13.7 1/2 33.2	12 DOAS-2 3 100 80 1 3	8         10         1           2         8         1-1/2
	13         DOAS-3           14         DOAS-4	3 100 7	70 1 3 3 8 1-	1/2         33.2           1/4         25.3	14         DOAS-4         3         100         70         1         3           15         DOAS 5         2         100         20         1         2	2         8         1-1/2           3         8         1-1/4           2         8         1-1/2
	15 DOAS-5 16 AHU-1	3 60 6	60 1 3 4 10 1-	1/2     33.2       1/4     24.8       1/4     20.8	16         AHU-1         3         60         40         1         3           17         AHU-4         3         60         40         1         3	2         0         1           8         10         1           8         10         1
	17 AHU-4 18 AHU-5 19 AHU-6	3 30 4	50         1         3         8         10           40         1         3         6         10           40         1         3         6         10	1 20.4 1 13.3 1 12.9	18         AHU-5         3         30         30         1         3           3         19         AHU-6         3         30         30         1         3	8         10         1           8         10         1
	20 21				20 21	
	22 23				22	
	24 25				24 25 25	
	26 27				26         1         1           27         1         1           28         1         1	
	28		TOTAL CONNECTED LO	DAD: 473.4 KVA		
		*GFEP TYPE (SECTION I)		MOUNTING: SURFACE		MOUNTING: SURFACE
VOLTAGE 225 AMPE	E: 480/277, 3PH, 4W	225A MCB		LOCATION: MECHANICAL RM ED NEUTRAL BUS 42K A.I.	VOLTAGE: 480/277, 3PH, 4W           225A AMPERE BUS         225A MCB	LOCATION: MECHANICAL RM 100% RATED NEUTRAL BUS
CONN KVA CI		FUSE     CIRCUIT WIRING       P     AMPS     NO     SIZE     GND     C	CKT DESCRIPTION	FUSE     CIRCUIT WIRING     CON       P     AMPS     NO     SIZE     GND     C     KV/	A KVA CKT DESCRIPTION P AMPS NO SIZE GND C CKT	FUSE     CIRCUIT WIRING       DESCRIPTION     P     AMPS     NO     SIZE     GND
3.3	1 BOILER-1 3 -	3     30     3     10     10     3/4       -     -     -     -     -     -	2 BOILER-2 4 -	3     30     3     10     10     3/4     3.3       -     -     -     -     -     3.3	3 SPACE 4 SPAG	CE
3.3 0.0 0.0	5 - 7 BOILER-3 9 -	-     -     -     -     -       3     30     3     10     10     3/4	6 - 8 AHU-2 SAF 10 -	-         -         -         -         3.3           3         20         3         10         10         3/4         3.0           -         -         -         -         -         3.0	7 SPACE 8 AHU-	
0.0 1	9 - 11 - 13 AHU-3 SAF	-     -     -     -     -       -     -     -     -     -       3     20     3     10     10     3/4	12 - 14 AHU-2 RAF	-     -     -     -     -     -     -       -     -     -     -     -     -     3.0       3     15     3     10     10     3/4     1.9	11 SPACE 12 -	
	15 - 17 -		16 - 18 -		3.0 15 16 -	
	19 AHU-3 RAF 21 -	3     15     3     10     10     3/4       -     -     -     -     -     -	20 PUMPS 10, 11, 12, 13, 14, 15, 22 -		1.9         19         AHU-3 RAF         3         15         3         10         10         3/4         20         PUM	PS 10, 11, 12, 13, 14, 1 3 15 3 10 10
1.923.92	23 - 25 FCU-5-101 THRU FCU-5-110	-         -         24 - 26 FCU-5-201 THRU FCU-5-210	-         -         -         -         2.7           1         15         2         12         12         3/4         3.9		 -5-201 THRU FCU-5-210 1 15 2 12 12
3.5 2	27         FCU-5-111         THRU         FCU-5-120           29         FCU-5-121         THRU         FCU-5-129	1         15         2         12         12         3/4           1         15         2         12         12         3/4	30 FCU-5-221 THRU FCU-5-229	1         15         2         12         12         3/4         3.9           1         15         2         12         12         3/4         3.5	3.5 29 FCU-5-121 THRU FCU-5-129 1 15 2 12 12 3/4 30 FCU-	-5-211 THRU FCU-5-220         1         15         2         12         12           -5-221 THRU FCU-5-229         1         15         2         12         12         12
1.5 3	31         FCU-5-130         THRU         FCU-5-134         33         FCU-5-230         THRU         FCU-5-235         34         35         36         36         37         37         1         15         2         12         12         3/4           1         15         2         12         12         3/4	32     HEAT TRACE       34     HEAT TRACE	1         20*         2         10         10         1         2.0           1         20*         2         10         10         1         2.0	2.3 33 FCU-5-230 THRU FCU-5-235 1 15 2 12 12 3/4 34 SPA	CE
2.0 3	35   HEAT TRACE     37   HEAT TRACE	1         20*         2         10         10         1           1         20*         2         10         10         1           1         20*         2         10         10         1	36 SPARE 38 PANEL MRP	1         20           3         90           REFER TO XFMR SCHEDULE         11.3		EL MRP 3 90 REFER TO XFMR SCHED
2.0 4	39 HEAT TRACE 41 HEAT TRACE	1         20*         2         10         10         1           1         20*         2         10         10         1	40 VIA XFMR T10 42 -	-     -     -     -     11.0       -     -     -     -     -     11.3	5 41 SPARE 1 20 42 -	
	TED LOAD (SECTION I)	130.3 KVA	KVA PER PHASE:	A 44.803 B 43.956 C 41.535		PER PHASE: A 34.203 B 34.156 C 30
PANEL VOLTAGE 225 AMPE	E: 480/277, 3PH, 4W	( SECTION II)	100% RAT	MOUNTING: SURFACE LOCATION: MECHANICAL RM ED NEUTRAL BUS 42K A.I.	PANEL MP (ALT 1)         ( SECTION II)           VOLTAGE: 480/277, 3PH, 4W         225A AMPERE BUS         225A	MOUNTING: SURFACE LOCATION: MECHANICAL RM 100% RATED NEUTRAL BUS
CONN KVA CI		BREAKER     CIRCUIT WIRING       P     AMPS     NO     SIZE     GND     C		BREAKER     CIRCUIT WIRING     CON       P     AMPS     NO     SIZE     GND     C     KV/		BREAKER         CIRCUIT WIRING           DESCRIPTION         P         AMPS         NO         SIZE         GND
0.6 4	43 FAN-4 45 -	3     15     3     12     12     3/4	44 FAN-5 46 -	3         15         3         12         12         3/4         0.6           -         -         -         -         -         0.6	0.6 43 FAN-4 3 15 3 12 12 3/4 44 FAN-	5 3 15 3 12 12
0.6		 3 15	48 - 50 SPARE	0.6		  RE 3 15
5	51 - 53 -	· · · · · · ·	52 - 54 -	-     -     -     -     -       -     -     -     -     -	49     SPARE     3     15     50     SPAR       51     -     -     -     -     -     52       53     -     -     -     -     -     54	
	55 SPARE 57 -	3     30       -     -       -     -	56         SPARE           58         -	3     30       -     -       -     -	50         51           55         SPARE         3         30         56         SPAR           57         -         -         -         -         -         58         -	RE 3 30
6	59 - 61 SPARE	 1 20	60 - 62 SPACE	-     -     -     -     -       1     20	59         -         -         -         -         -         60         -           61         SPARE         1         20         62         SPARE	CE 1 20
6	33 SPARE 35 SPARE 37 SPARE	1         20           1         20           1         20	64 SPACE 66 SPACE 68 SPACE	1     20       1     20       1     20	63         SPARE         1         20         64         SPAR           65         SPARE         1         20         66         SPAR	CE 1 20
6	<ul><li>37 SPARE</li><li>39 SPARE</li><li>71 SPARE</li></ul>	1         20           1         20           1         20	68 SPACE 70 SPACE 72 SPACE	1         20           1         20           1         20	67         SPARE         1         20         68         SPAR           69         SPARE         1         20         70         SPAR           70         SPARE         1         20         70         SPAR	CE 1 20
7	71 SPARE 73 SPACE 75 SPACE		72 SPACE 74 SPACE 76 SPACE		71         SPARE         1         20         72         SPAC           73         SPACE         1         74         SPAC         74         SPAC         74         SPAC         74         SPAC         74         SPAC         74         SPAC         75         SPACE         1         75         SPACE         1         76         SPAC         76         SPAC         SPAC         SPAC         76         SPAC         SPAC         76         SPAC         SPAC <t< td=""><td>CE 1</td></t<>	CE 1
7	77 SPACE 79 SPACE		78         SPACE           80         SPACE		75         SPACE         1         76         SPACE           77         SPACE         1         78         SPACE           79         SPACE         1         80         SPACE	CE 1
8	81 SPACE 83 SPACE	1	82     SPACE       84     SPACE		79         SPACE         1         80         SPACE           81         SPACE         1         82         SPACE           83         SPACE         1         84         SPACE	CE 1
	TED LOAD (SECTION II) ONNECTED LOAD	3.6 KVA 133.89 <b>KVA</b>	KVA PER PHASE: KVA PER PHASE:	A         1.2         B         1.2         C         1.2           A         46.003         B         45.156         C         42.735	CONNECTED LOAD (SECTION II) 3.6 KVA KVA	PER PHASE:         A         1.2         B         1.2         C           PER PHASE:         A         35.403         B         35.356         C         3
	ANEL MRP			MOUNTING: SURFACE	PANEL MRP (ALT 1)	MOUNTING: SURFACE
2 VC 150	DLTAGE: 208/120V, 3PH, 4W 0 AMPERE BUS	150 A MCB		LOCATION: MECHANICAL ROOM ED NEUTRAL BUS 10,000 A.I.C		LOCATION: MECHANICAL ROOM 100% RATED NEUTRAL BUS 10
ĸ	ONN VA CKT DESCRIPTION	BREAKER     CIRCUIT WIRING       P     AMPS       NO     SIZE	C CKT DESCRIPTION	BREAKER     CIRCUIT WIRING     CON       P     AMPS     NO     SIZE     GND     C     KVA	KVA CKT DESCRIPTION P AMPS NO SIZE GND C CKT	BREAKER     CIRCUIT WIRING       DESCRIPTION     P     AMPS     NO     SIZE     GND       HEN EXHAUST FAN     3     30     4     8     10
C	D.2         1         FAN-1           D.4         3         UH-1 AND UH-2           1.2         5         DSS 1	1 15 2 12 12 3	3/4         2         KITCHEN EXHAUST FAN           3/4         4	3     30     4     8     10     1     2.1	0.4         3         UH-1 AND UH-2         1         15         2         12         12         3/4         4           1.2         5         DSS 1         2         15         2         12         12         2/4         6	HEN EXHAUST FAN         3         30         4         8         10
1	1.2         5         DSS-1           1.2         7            1.2         0         DSS 2		3/4 6 8 KITCHEN MAKE-UP UNIT	3         60         4         4         10         1-1/4         5.0		HEN MAKE-UP UNIT 3 60 4 4 10 1-
1	1.2         9         DSS-2           1.2         11            1.2         13         DSS-3		3/4         10           12	1         20         2         12         12         3/4         0.5		I         20         2         12         12         <th12< th="">         12         12         12</th12<>
1	1.2         13         DSS-3           1.2         15            1.0         17         RECEPTACLE		3/4         14         CHEMICAL SHOT           16         ATC PANEL           3/4         18         ATC PANEL	1         20         2         12         12         3/4         0.5           1         20         2         12         12         3/4         0.5           1         20         2         12         12         3/4         0.5           1         20         2         12         12         3/4         0.5	1.2         15          16         ATC F           1.0         17         RECEPTACLE         1         20         2         12         12         3/4         18         ATC F	PANEL         1         20         2         12         12         32           PANEL         1         20         2         12         12         33
	1.0         17         RECEPTACLE           1.0         19         GLYCOL FEED           1.0         21         CHEMICAL SHOT	1 20 2 12 12 3	3/4         18         ATC PANEL           3/4         20         ATC PANEL           3/4         22         SPACE	1         20         2         12         12         3/4         0.5           1         20         2         12         12         3/4         0.5	1.0         19         GLYCOL FEED         1         20         2         12         12         3/4         20         ATC F           1.0         21         CHEMICAL SHOT         1         20         2         12         12         3/4         20         ATC F	PANEL         1         20         2         12         12         32           PANEL         1         20         2         12         12         32
	0.5 23 BOILER SHUT-DOWN	1 20 2 12 12 3	3/4         22         SPACE           3/4         24         SPACE           3/4         26         SPACE		23         SPARE         1         20         24         SPAC           25         SPARE         1         20         26         SPAC	E E
	0.2 25 RECEPTACLE				27 SPARE 1 20 28 SPAC	
	D.225RECEPTACLED.227FLOW METERS29SPARE	1         20         2         12         12         3           1         20	3/4 28 SPACE 30 SPACE		29 SPARE 1 20 30 SPAC	
	0.2 27 FLOW METERS				31         SPARE         1         20         32         SPAC           33         SPARE         1         20         34         SPAC	E E E E E E E E E E E E E E E E E E E
	D.227FLOW METERS29SPARE31SPARE33SPARE35SPARE37SPARE	1       20	30SPACE32SPACE34SPACE36SPACE38SPACE		31       SPARE       1       20       32       SPAC         33       SPARE       1       20       34       SPAC         35       SPARE       1       20       36       SPAC         37       SPARE       1       20       38       SPAC	DE  Image: state sta
	D.227FLOW METERS29SPARE31SPARE33SPARE35SPARE	1     20	30SPACE32SPACE34SPACE36SPACE		31       SPARE       1       20       32       SPAC         33       SPARE       1       20       34       SPAC         35       SPARE       1       20       36       SPAC         37       SPARE       1       20       38       SPAC         39       SPARE       1       20       40       SPAC         41       SPARE       1       20       42       SPAC	DE     Image: Second seco

•	ON PANEL DPM			DISTRIBUTION PANEL DPM (ALT 1)	
MOUNTING: SU VOLTAGE: 480/	RFACE A.I.C. RATI 277, 3 PHASE, 4 WIRE 1200A MAI	ING: 65,000 IN BUS	LOCATION: MECHANICAL ROOM 1000A MCB	VOLTAGE: 480/277, 3 PHASE, 4 WIRE 1200A MAIN BUS 1000A	ATION: MECHANICAL ROOM
FDR	DISTRIBI CIRCUIT BREA	UTION SECTION AKER WIRING		DISTRIBUTION SECTION       FDR     CIRCUIT BREAKER     WIRING	
NO	SERVES P FRAME 1	TRIP SETS NO SIZE GND	C REMARKS K	A NO SERVES P FRAME TRIP SETS NO SIZE GND C	REMARKS
1 PUMP-1 2 PUMP-2	3 60	40         1         3         8         10           40         1         3         8         10	3/4 1	4         2         PUMP-2         3         100         100         1         3         3         8         1-1/4           3         PUMP-3         3         60         40         1         3         8         10         3/4	
3 PUMP-3 4 PUMP-4	3 125			0         3         60         40         1         3         8         10         3/4           5         PLIMP 5         3         60         40         1         3         8         10         3/4	
5 PUMP-5 6 PUMP-6	3 30 3 30	15         1         3         12         12           15         1         3         12         12	3/4 3/4	6         PUMP-6         3         30         25         1         3         10         10         3/4	
7 PUMP-7 8 PUMP-8	3 30 3 100	15         1         3         12         12           70         1         3         6         8	3/4         STANDBY           3/4         2	7         PUMP-7         3         30         25         1         3         10         10         3/4           2         8         PUMP-8         3         30         25         1         3         10         10         3/4	
9 PUMP-9 10 PANEL MP	3         100           3         225	70         1         3         6         8           225         1         3         4/0         4	3/4         STANDBY           2         1	9         SPACE         3         100         -         -         -         -           10         PANEL MP         3         225         225         1         3         4/0         4         2	
11 DOAS-1 12 DOAS-2		35 1 3 8 10	1 1 1-1/2 3	11         DOAS-1         3         60         35         1         3         8         10         1           7         12         DOAS 2         2         100         80         1         2         2         8         11/2	
13 DOAS-3	3 100	80 1 3 2 8	1-1/2 3	13         DOAS-3         3         100         80         1         3         2         8         1-1/2           14         DOAS 4         3         100         70         1         3         8         1.1/4	
14         DOAS-4           15         DOAS-5		80 1 3 2 8	1-1/4     2       1-1/2     3	3     2     15     DOAS-5     3     100     80     1     3     2     8     1-1/2       16     0     0     1     3     2     8     1-1/2	
16 AHU-1 17 AHU-4		50         1         3         8         10	1-1/4         2           1         2	D     17     AHU-4     3     60     40     1     3     8     10     1       4     18     AHU-5     3     30     30     1     3     8     10     1	
18 AHU-5 19 AHU-6	3 30 3 30	40         1         3         6         10           40         1         3         6         10		3     10     A10-5     10     10     10     10     10       9     19     AHU-6     3     30     30     1     3     8     10     1       20     1     1     1     1     1     1     1	
20 21				21	
22 23				22         23         1         1         1	
24 25				24	
26				26 27	
27 28					
	~~~~~~~~~~~~~~~~~~~~~~~~~~~~~~~~~~~~~~~				504.6
PANEL MP	*GFEP TYPE (SECTION I		MOUNTING: SURFACE		
OLTAGE: 480/277, 3PH, 4W 25 AMPERE BUS	225A MCB		LOCATION: MECHANICAL RM ATED NEUTRAL BUS 42K A	VOLTAGE: 480/277, 3PH, 4W LOCAT	TION: MECHANICAL RM
CONN	FUSE CIRCUIT WIRING		FUSE CIRCUIT WIRING C	IN CONN FUSE CIRCUIT WIRING FUSE	E CIRCUIT WIRING
KVA CKT DESCRIPTI	ON P AMPS NO SIZE GND C 3 30 3 10 10 3/4		P         AMPS         NO         SIZE         GND         C         H           3         30         3         10         10         3/4         I		MPS NO SIZE GND C
3.3         3         -           3.3         5         -		4 -		3 3 SPACE 4 SPACE	
0.0         7         BOILER-3           0.0         9         -	3 30 3 10 10 3/4		3     20     3     10     10     3/4	7         SPACE         8         AHU-2 SAF         3         2           0         0         0.00000000000000000000000000000000000	20 3 10 10 3/4
0.0 11 -		10 - 12 -		11         SPACE         12         -         -         -	 
3.0         13         AHU-3 SAF           3.0         15         -	3         20         3         10         10         3/4           -         -         -         -         -         -         -	16 -	3     15     3     10     10     3/4       -     -     -     -     -	3.0 15 16	15 3 10 10 3/4 
3.0         17         -           1.9         19         AHU-3 RAF	-         -         15 3 10 10 3/4
1.9     21       1.9     23		22 - 24 -			
3.9         25         FCU-5-101 THRU FC           3.9         27         FCU-5-111 THRU FC		4         26         FCU-5-201         THRU         FCU-5-210           4         28         FCU-5-211         THRU         FCU-5-220		3.9         25         FCU-5-101         THRU FCU-5-110         1         15         2         12         12         3/4         26         FCU-5-201         THRU FCU-5-210         1         1	15212123/415212123/4
3.5         29         FCU-5-121         THRU FC           1.9         31         FCU-5-130         THRU FC	U-5-129 1 15 2 12 12 3/4	4 30 FCU-5-221 THRU FCU-5-229	1 15 2 12 12 3/4		15 2 12 12 3/4
1.5 33 FCU-5-230 THRU FC	U-5-235 1 15 2 12 12 3/4	4 34 HEAT TRACE	1 20* 2 10 10 1	1.9       31       FCU-5-130       THRU FCU-5-134       1       15       2       12       3/4       32       SPACE         2.3       33       FCU-5-230       THRU FCU-5-235       1       15       2       12       12       3/4       34       SPACE         35       SPARE       1       20       12       12       3/4       34       SPACE       1	
2.0         35         HEAT TRACE           2.0         37         HEAT TRACE           2.0         37         HEAT TRACE	1         20*         2         10         1         1           1         20*         2         10         10         1           1         20*         2         10         10         1	36 SPARE 38 PANEL MRP		9 37 SPARE 1 20 38 PANEL MRP 3 9	90 REFER TO XFMR SCHEDULE
2.0         39         HEAT TRACE           2.0         41         HEAT TRACE	1         20*         2         10         1           1         20*         2         10         10         1	40 VIA XFMR T10 42 -	·	5 41 SPARE 1 20 42	
		KVA PER PHASE:	A 44 000 D 40 050 0 44 505		
CONNECTED LOAD (SECTION I)	130.3 KVA		A 44.803 B 43.956 C 41.535	CONNECTED LOAD (SECTION I) 99.3 KVA KVA PER PHASE: A 34.3	.203 B 34.156 C 30.935
PANEL MP	( SECTION II)		MOUNTING: SURFACE	PANEL MP (ALT 1) (SECTION II) MOUNT	TING: SURFACE
PANEL MP OLTAGE: 480/277, 3PH, 4W 25 AMPERE BUS	( SECTION II) 225A		MOUNTING: SURFACE LOCATION: MECHANICAL RM ATED NEUTRAL BUS 42K A	C. PANEL MP (ALT 1) (SECTION II) MOUNT VOLTAGE: 480/277, 3PH, 4W 225A AMPERE BUS 225A 100% RATED NEUTR	TING: SURFACE TION: MECHANICAL RM
PANEL MP OLTAGE: 480/277, 3PH, 4W	( SECTION II) 225A BREAKER CIRCUIT WIRING	100% R4	MOUNTING: SURFACE LOCATION: MECHANICAL RM	PANEL MP (ALT 1)       ( SECTION II)       MOUNT         VOLTAGE: 480/277, 3PH, 4W       LOCAT         225A AMPERE BUS       225A       100% RATED NEUTR         NN       CONN       BREAKER       CIRCUIT WIRING       BREAK	TING: SURFACE FION: MECHANICAL RM RAL BUS 421
PANEL MP OLTAGE: 480/277, 3PH, 4W 25 AMPERE BUS	( SECTION II) 225A BREAKER   CIRCUIT WIRING	100% RA	MOUNTING: SURFACE LOCATION: MECHANICAL RM ATED NEUTRAL BUS 42K A BREAKER CIRCUIT WIRING C	PANEL MP (ALT 1)       ( SECTION II)       MOUNT         VOLTAGE: 480/277, 3PH, 4W       LOCAT         225A AMPERE BUS       225A         NN       CONN       BREAKER       CIRCUIT WIRING         KVA       CKT       DESCRIPTION       BREAKER       CIRCUIT WIRING         0.6       43       FAN-4       3       15       3       12       12       3/4       44       FAN-5       3       1	TING: SURFACE FION: MECHANICAL RM RAL BUS 42K
PANEL MP           OLTAGE: 480/277, 3PH, 4W           25 AMPERE BUS           CONN           KVA           CKT           DESCRIPTI           0.6           43           FAN-4           0.6           45	( SECTION II)          225A         BREAKER       CIRCUIT WIRING         ON       P       AMPS       NO       SIZE       GND       C	100% R4 CKT DESCRIPTION 4 44 FAN-5	MOUNTING: SURFACE LOCATION: MECHANICAL RM ATED NEUTRAL BUS 42K A BREAKER CIRCUIT WIRING C P AMPS NO SIZE GND C	PANEL MP (ALT 1)       ( SECTION II)       MOUNT         VOLTAGE: 480/277, 3PH, 4W       LOCAT         225A AMPERE BUS       225A         100% RATED NEUTR       100% RATED NEUTR         VNA       CKT         A       0.6         0.6       43         0.6       45         0.6       47         0.6       47	TING: SURFACE TION: MECHANICAL RM RAL BUS 42P KER CIRCUIT WIRING MPS NO SIZE GND C 15 3 12 12 3/4  
PANEL MP         OLTAGE: 480/277, 3PH, 4W         25 AMPERE BUS         CONN         KVA         CKT         DESCRIPTI         0.6         43         FAN-4         0.6         45         0.6         47         49         SPARE         51	( SECTION II) 225A ON BREAKER CIRCUIT WIRING P AMPS NO SIZE GND C 3 15 3 12 12 3/4  	100% R4         CKT       DESCRIPTION         4       44       FAN-5         46       -         48       -         50       SPARE         52       -	MOUNTING: SURFACE LOCATION: MECHANICAL RM ATED NEUTRAL BUS 42K A BREAKER CIRCUIT WIRING P AMPS NO SIZE GND C 3 15 3 12 12 3/4  	PANEL MP (ALT 1)         (SECTION II)         MOUNT           VOLTAGE: 480/277, 3PH, 4W         LOCAT           225A AMPERE BUS         225A           INA         CONN           KVA         CKT           DESCRIPTION         P           AMPS         NO           So         0.6           43         FAN-4           3         15           3         12           12         3/4           44         FAN-5           0.6         43           45         -           0.6         47           49         SPARE           3         15           51         -           -         -           51         -	TING: SURFACE TION: MECHANICAL RM RAL BUS 42P KER CIRCUIT WIRING MPS NO SIZE GND C 15 3 12 12 3/4 
PANEL MP         OLTAGE: 480/277, 3PH, 4W         25 AMPERE BUS         CONN         KVA         CKT         DESCRIPTI         0.6         43         FAN-4         0.6         45         0.6         47         49         SPARE         51         53         55         SPARE	( SECTION II) 225A ON BREAKER CIRCUIT WIRING P AMPS NO SIZE GND C 3 15 3 12 12 3/4  	100% R4         CKT       DESCRIPTION         4       44       FAN-5         46       -         48       -         50       SPARE         52       -         54       -         56       SPARE	MOUNTING: SURFACE LOCATION: MECHANICAL RM ATED NEUTRAL BUS 42K A BREAKER CIRCUIT WIRING P AMPS NO SIZE GND C 3 15 3 12 12 3/4  	PANEL MP (ALT 1)       (SECTION II)       MOUNT         VOLTAGE: 480/277, 3PH, 4W       LOCAT         225A AMPERE BUS       225A         INA       BREAKER       CIRCUIT WIRING         KVA       CKT       DESCRIPTION         P       AMPS       NO <size< td="">       GND         0.6       43       FAN-4       3       15       3       12       12       3/4       44       FAN-5       3       1         0.6       47       -       -       -       -       -       46       -       -       -</size<>	TING: SURFACE TION: MECHANICAL RM RAL BUS 42P KER CIRCUIT WIRING MPS NO SIZE GND C 15 3 12 12 3/4  
PANEL MP         OLTAGE: 480/277, 3PH, 4W         25 AMPERE BUS         CONN         KVA         CKT         DESCRIPTI         0.6         43         FAN-4         0.6         45         0.6         47         -         49         SPARE         51         53         55         SPARE         57         59	( SECTION II)         225A         BREAKER CIRCUIT WIRING         ON       P       AMPS       NO       SIZE       GND       C         3       15       3       12       12       3/4         -       -       -       -       -       -         3       15       3       12       12       3/4         -       -       -       -       -       -       -         3       15       3       12       -       -       -       -         3       15       -       -       -       -       -       -       -         3       30       -       -       100% RA         CKT       DESCRIPTION         4       44       FAN-5         46       -         48       -         50       SPARE         52       -         54       -         56       SPARE         58       -         60       -	MOUNTING: SURFACE LOCATION: MECHANICAL RM         ATED NEUTRAL BUS       42K P         BREAKER       CIRCUIT WIRING       C         3       15       3       12       3/4         -       -       -       -       -         3       15       3       12       3/4       12         -       -       -       -       -       -       1         3       15       3       12       12       3/4       1         -       -       -       -       -       -       1       1       PANEL MP (ALT 1)         ( SECTION II)         MOUNT           VOLTAGE: 480/277, 3PH, 4W         LOCAT           225A         100% RATED NEUTR           225A AMPERE BUS         225A           NN         KVA           CONN         BREAKER           KVA         CKT           DESCRIPTION         BREAKER           CIRCUIT WIRING         CKT           0.6         43           44         FAN-4           0.6         47           0.6         47           49         SPARE           3         15           51         -           53         -           53         -           55         SPARE           3         30           57         -           59         -	TING: SURFACE         TION: MECHANICAL RM         RAL BUS       42H         KER CIRCUIT WIRING         MPS       NO       SIZE       GND       C         15       3       12       12       3/4         -       -       -       -         15       3       12       12       3/4         -       -       -       -       -         15       3       12       12       3/4         -       -       -       -       -         15       -       -       -       -         15       -       -       -       -         30       -       -       -       -         -       -       -       -       -         -       -       -       -       -         30       -       -       -       -         -       -       -       -       -         -       -       -       -       -
PANEL MP         OLTAGE: 480/277, 3PH, 4W         25 AMPERE BUS         CONN         KVA         CKT       DESCRIPTI         0.6       43         43       FAN-4         0.6       45         0.6       47         0.6       47         51       -         53       -         55       SPARE         57       -         59       -         61       SPARE         63       SPARE	( SECTION II)         225A         BREAKER CIRCUIT WIRING         ON       P       AMPS       NO       SIZE       GND       C         3       15       3       12       12       3/4         -       -       -       -       -       -         3       15       3       12       12       3/4         -       -       -       -       -       -       -         3       15       3       12       12       3/4         -       -       -       -       -       -       -         3       15       3       12       12       3/4         -       -       -       -       -       -       -         3       15       -       -       -       -       -         3       30       -       -       -       -       -       -         3       30       -       -       -       -       -       -         -       -       -       -       -       -       -       -       -         1       20	100% RA         CKT       DESCRIPTION         4       44       FAN-5         46       -         48       -         50       SPARE         52       -         54       -         56       SPARE         58       -         60       -         62       SPACE         64       SPACE	MOUNTING: SURFACE LOCATION: MECHANICAL RM         ATED NEUTRAL BUS       42K A         BREAKER       CIRCUIT WIRING       C         P       AMPS       NO       SIZE       GND       C         3       15       3       12       12       3/4       C         -       -       -       -       -       -       C         3       15       3       12       12       3/4       C         -       -       -       -       -       -       C         3       15       3       12       12       3/4       C         -       -       -       -       -       -       C         3       15       3       12       12       3/4       C         -       -       -       -       -       -       C       C         3       30       -       -       C.         PANEL MP (ALT 1)         ( SECTION II)         MOUNT           VOLTAGE: 480/277, 3PH, 4W         LOCAT         LOCAT           225A         100% RATED NEUTR         LOCAT           25A AMPERE BUS         225A         100% RATED NEUTR           CONN         EREAKER         CIRCUIT WIRING         EREAKER           CONN         KVA         CKT         DESCRIPTION         P AMPS           0.6         43         FAN-4         3         15         3         12         12         3/4         44         FAN-5         3         1           0.6         43         FAN-4         3         15         3         12         12         3/4         44         FAN-5         3         1           0.6         43         FAN-4         3         15         -         -         TING: SURFACE         FION: MECHANICAL RM         RAL BUS       421         KER       CIRCUIT WIRING         MPS       NO       SIZE       GND       C         15       3       12       12       3/4         -       -       -       -       -         15       3       12       12       3/4         -       -       -       -       -         15       -       -       -       -         15       -       -       PANEL MP         OLTAGE: 480/277, 3PH, 4W         25 AMPERE BUS         CONN         KVA         CKT         DESCRIPTI         0.6         43         FAN-4         0.6         45         0.6         45         0.6         47         -         49         SPARE         51         53         55         SPARE         57         59         61         SPARE         63         64         65         SPARE	(SECTION II)         225A         BREAKER       CIRCUIT WIRING         P       AMPS       NO       SIZE       GND       C         3       15       3       12       12       3/4         -       -       -       -       -       -         3       15       3       12       12       3/4         -       -       -       -       -       -       -         3       15       3       12       12       3/4         -       -       -       -       -       -       -         3       15       3       12       12       3/4         -       -       -       -       -       -       -         3       15       -       -       -       -       -         3       30       -       -       -       -       -       -         3       30       -       -       -       -       -       -       -       -       -       -       -       -       -       -       -       -       -       -       -       -	100% RA         CKT       DESCRIPTION         4       44       FAN-5         46       -       48         50       SPARE       50         52       -       54         54       -       56         58       -       60         60       -       62         64       SPACE       64         68       SPACE       68	MOUNTING: SURFACE LOCATION: MECHANICAL RM         ATED NEUTRAL BUS       42K A         BREAKER       CIRCUIT WIRING       C         P       AMPS       NO       SIZE       GND       C         3       15       3       12       12       3/4       C         -       -       -       -       -       -       C         3       15       3       12       12       3/4       C         -       -       -       -       -       -       C         3       15       3       12       12       3/4       C         -       -       -       -       -       -       C         3       15       3       12       12       3/4       C         -       -       -       -       -       -       C         3       30       3       1       -       -       -       -         3       30       -       -       -       -       -       -       -       -       -       -       -       -       -       -       -       -       -       -       - <t< td=""><td>PANEL MP (ALT 1)         ( SECTION II)         MOUNT           VOLTAGE: 480/277, 3PH, 4W         LOCAT         LOCAT           225A         100% RATED NEUTR         LOCAT           225A         MOUNT         LOCAT           CONN         BREAKER         CIRCUIT WIRING         KT           CONN         BREAKER         CIRCUIT WIRING         KT           0.6         43         FAN-4         3         15         3         12         12         3/4         44         FAN-5         3         1           0.6         43         FAN-4         3         15         3         12         12         3/4         44         FAN-5         3         1           0.6         43         FAN-4         3         15         1         -         -         -</td><td>TING: SURFACE         TION: MECHANICAL RM         RAL BUS       424         KER       CIRCUIT WIRING         MPS       NO       SIZE       GND       C         15       3       12       12       3/4         -       -       -       -         15       3       12       12       3/4         -       -       -       -       -         15       3       12       12       3/4         -       -       -       -       -         15       -       -       -       -         15       -       -       -       -         30       -       -       -       -         -       -       -       -       -         20       -       -       -       -</td></t<>	PANEL MP (ALT 1)         ( SECTION II)         MOUNT           VOLTAGE: 480/277, 3PH, 4W         LOCAT         LOCAT           225A         100% RATED NEUTR         LOCAT           225A         MOUNT         LOCAT           CONN         BREAKER         CIRCUIT WIRING         KT           CONN         BREAKER         CIRCUIT WIRING         KT           0.6         43         FAN-4         3         15         3         12         12         3/4         44         FAN-5         3         1           0.6         43         FAN-4         3         15         3         12         12         3/4         44         FAN-5         3         1           0.6         43         FAN-4         3         15         1         -         -         TING: SURFACE         TION: MECHANICAL RM         RAL BUS       424         KER       CIRCUIT WIRING         MPS       NO       SIZE       GND       C         15       3       12       12       3/4         -       -       -       -         15       3       12       12       3/4         -       -       -       -       -         15       3       12       12       3/4         -       -       -       -       -         15       -       -       -       -         15       -       -       -       -         30       -       -       -       -         -       -       -       -       -         20       -       -       -       -
PANEL MP         OLTAGE: 480/277, 3PH, 4W         25 AMPERE BUS         CONN         KVA         CKT       DESCRIPTI         0.6       43         0.6       43         0.6       45         0.6       45         0.6       47         0.6       47         0.6       47         0.6       51         0.6       51         53       -         55       SPARE         57       -         59       -         61       SPARE         63       SPARE         63       SPARE         65       SPARE         67       SPARE         67       SPARE         67       SPARE         69       SPARE         69       SPARE         61       SPARE         67       SPARE         67       SPARE         67       SPARE         67       SPARE         69       SPARE         71       SPARE	( SECTION II)         225A         ON       BREAKER       CIRCUIT WIRING         ON       P       AMPS       NO       SIZE       GND       C         3       15       3       12       12       3/4         -       -       -       -       -       -         3       15       3       12       12       3/4         -       -       -       -       -       -       -         3       15       3       12       12       3/4         -       -       -       -       -       -       -         3       15       3       12       12       3/4         -       -       -       -       -       -       -         3       15       -       -       -       -       -         3       30       -       -       -       -       -       -         1       20       -       -       -       -       -       -         1       20       -       -       -       -       -       -	100% RA         CKT       DESCRIPTION         4       44       FAN-5         46       -       48         50       SPARE       50         52       -       54         54       -       56         58       -       60         60       -       62         64       SPACE       66         64       SPACE       68         68       SPACE       70         70       SPACE       72	MOUNTING: SURFACE LOCATION: MECHANICAL RM         ATED NEUTRAL BUS       42K A         BREAKER       CIRCUIT WIRING       C         P       AMPS       NO       SIZE       GND       C         3       15       3       12       12       3/4       -         -       C.         PANEL MP (ALT 1)         (SECTION II)         MOUNT           VOLTAGE: 480/277, 3PH, 4W         225A         100% RATED NEUTR           225A AMPERE BUS         225A         100% RATED NEUTR           CONN         KVA         CKT         DESCRIPTION         BREAKER         CIRCUIT WIRING         CKT         DESCRIPTION         BREAK           0.6         43         FAN-4         3         15         3         12         12         3/4         44         FAN-5         3         1           0.6         43         FAN-4         3         15         3         12         12         3/4         44         FAN-5         3         1           0.6         43         FAN-4         3         15         -         -         TING: SURFACE         TION: MECHANICAL RM         RAL BUS       42I         KER       CIRCUIT WIRING         MPS       NO       SIZE       GND       C         MPS       NO       SIZE       GND       C         15       3       12       12       3/4         -       -       -       -         15       3       12       12       3/4         -       -       -       -       -         15       3       12       12       3/4         -       -       -       -       -         15       -       -       -       -         30       -       -       -       -         20       -       -       -       -         20       -       -       -       -         20       -       -       -       -
PANEL MP         25 AMPERE BUS         25 AMPERE BUS         CONN         KVA         CKT         DESCRIPTI         0.6         43         FAN-4         0.6         45         0.6         45         0.6         47         0.6         47         0.6         47         0.6         47         0.6         47         0.6         47         0.6         47         0.6         47         53         51         53         55         SPARE         57         58         59         61         59         61         59         63         64         65         67         59         67         59         63         59         65         59 <t< td=""><td>( SECTION II)         225A         ON       BREAKER       CIRCUIT WIRING         ON       P       AMPS       NO       SIZE       GND       C         3       15       3       12       12       3/4         -       -       -       -       -       -         3       15       3       12       12       3/4         -       -       -       -       -       -       -         3       15       3       12       12       3/4         -       -       -       -       -       -       -         3       15       -       -       -       -       -       -         3       30       -       -       -</td><td>100% RA         CKT       DESCRIPTION         4       44       FAN-5         46       -         48       -         50       SPARE         52       -         54       -         56       SPARE         58       -         60       -         62       SPACE         64       SPACE         66       SPACE         68       SPACE         70       SPACE</td><td>MOUNTING: SURFACE LOCATION: MECHANICAL RM         ATED NEUTRAL BUS       42K A         BREAKER       CIRCUIT WIRING       C         P       AMPS       NO       SIZE       GND       C         3       15       3       12       12       3/4         -       -       -       -       -       -         3       15       3       12       12       3/4         -       -       -       -       -       -         3       15       1       -       -       -         3       15       -       -       -       -         3       30       -       -       -       -         3       30       -       -       -       -         1       20       -       -       -       -         1       20       -       -       -       -         1       20       -       -       -       -       -         1       20       -       -       -       -       -       -         1       20       -       -       -       -       -</td><td>Construction         BREAKER         CIRCUIT WIRING         CKT         Description         BREAKER           CONN         CKT         DESCRIPTION         P         AMPS         NO         SIZE         00% RATED NEUTR           CONN         CKT         DESCRIPTION         BREAKER         CIRCUIT WIRING         CKT         DESCRIPTION         P         AM           0.6         43         FAN-4         3         15         3         12         12         3/4         44         FAN-5         3         1           0.6         43         FAN-4         3         15         3         12         12         3/4         44         FAN-5         3         1           0.6         47         -         -         -         -         -         48         -         -         -</td><td>TING: SURFACE         TION: MECHANICAL RM         RAL BUS       42I         KER       CIRCUIT WIRING         MPS       NO       SIZE       GND       C         15       3       12       12       3/4         -       -       -       -         15       3       12       12       3/4         -       -       -       -       -         15       3       12       12       3/4         -       -       -       -       -         15       3       12       12       3/4         -       -       -       -       -         15       1       -       -       -         30       -       -       -       -         20       -       -       -       -         20       -       -       -       -       -         20       -       -       -       -       -         20       -       -       -       -       -         20       -       -       -       -       -      &lt;</td></t<>	( SECTION II)         225A         ON       BREAKER       CIRCUIT WIRING         ON       P       AMPS       NO       SIZE       GND       C         3       15       3       12       12       3/4         -       -       -       -       -       -         3       15       3       12       12       3/4         -       -       -       -       -       -       -         3       15       3       12       12       3/4         -       -       -       -       -       -       -         3       15       -       -       -       -       -       -         3       30       -       -       100% RA         CKT       DESCRIPTION         4       44       FAN-5         46       -         48       -         50       SPARE         52       -         54       -         56       SPARE         58       -         60       -         62       SPACE         64       SPACE         66       SPACE         68       SPACE         70       SPACE	MOUNTING: SURFACE LOCATION: MECHANICAL RM         ATED NEUTRAL BUS       42K A         BREAKER       CIRCUIT WIRING       C         P       AMPS       NO       SIZE       GND       C         3       15       3       12       12       3/4         -       -       -       -       -       -         3       15       3       12       12       3/4         -       -       -       -       -       -         3       15       1       -       -       -         3       15       -       -       -       -         3       30       -       -       -       -         3       30       -       -       -       -         1       20       -       -       -       -         1       20       -       -       -       -         1       20       -       -       -       -       -         1       20       -       -       -       -       -       -         1       20       -       -       -       -       -	Construction         BREAKER         CIRCUIT WIRING         CKT         Description         BREAKER           CONN         CKT         DESCRIPTION         P         AMPS         NO         SIZE         00% RATED NEUTR           CONN         CKT         DESCRIPTION         BREAKER         CIRCUIT WIRING         CKT         DESCRIPTION         P         AM           0.6         43         FAN-4         3         15         3         12         12         3/4         44         FAN-5         3         1           0.6         43         FAN-4         3         15         3         12         12         3/4         44         FAN-5         3         1           0.6         47         -         -         -         -         -         48         -         -         TING: SURFACE         TION: MECHANICAL RM         RAL BUS       42I         KER       CIRCUIT WIRING         MPS       NO       SIZE       GND       C         15       3       12       12       3/4         -       -       -       -         15       3       12       12       3/4         -       -       -       -       -         15       3       12       12       3/4         -       -       -       -       -         15       3       12       12       3/4         -       -       -       -       -         15       1       -       -       -         30       -       -       -       -         20       -       -       -       -         20       -       -       -       -       -         20       -       -       -       -       -         20       -       -       -       -       -         20       -       -       -       -       -      <
PANEL MP         25 AMPERE BUS         25 AMPERE BUS         CONN         KVA         CKT         DESCRIPTI         0.6         43         FAN-4         0.6         45         0.6         45         0.6         47         0.6         47         0.6         47         0.6         47         0.6         47         0.6         47         0.6         47         0.6         47         1         53         51         53         53         55         57         58         59         61         59         63         55         64         55         57         67         58         67         59         63         59         64         59	( SECTION II)         225A         ON       BREAKER       CIRCUIT WIRING         ON       P       AMPS       NO       SIZE       GND       C         3       15       3       12       12       3/4         -       -       -       -       -       -         3       15       3       12       12       3/4         -       -       -       -       -       -       -         3       15       3       12       12       3/4         -       -       -       -       -       -       -         3       15       -       -       -       -       -       -         3       30       -       -       100% RA           CKT         DESCRIPTION           4         44         FAN-5           46         -           48         -           50         SPARE           52         -           54         -           56         SPARE           58         -           60         -           62         SPACE           64         SPACE           68         SPACE           70         SPACE           72         SPACE           74         SPACE	MOUNTING: SURFACE LOCATION: MECHANICAL RM         ATED NEUTRAL BUS       42K A         BREAKER       CIRCUIT WIRING       C         P       AMPS       NO       SIZE       GND       C         3       15       3       12       12       3/4         -       -       -       -       -       -         3       15       3       12       12       3/4         -       -       -       -       -       -         3       15       1       -       -       -         3       15       -       -       -       -         3       30       -       -       -       -         3       30       -       -       -       -         1       20       -       -       -       -         1       20       -       -       -       -         1       20       -       -       -       -       -         1       20       -       -       -       -       -       -         1       20       -       -       -       -       -	C         PANEL MP (ALT 1) VOLTAGE: 480/277, 3PH, 4W         (SECTION II)         MOUNT LOCAT           225A         100% RATED NEUTF         LOCAT           NA A         C         225A         100% RATED NEUTF           NA A         CKT         DESCRIPTION         BREAKER         CIRCUIT WIRING         CKT           0.6         43         FAN-4         3         15         3         12         12         3/4         44         FAN-5         3         1           0.6         43         FAN-4         3         15         3         12         12         3/4         44         FAN-5         3         1           0.6         47         -         -         -         -         -         46         -         -         TING: SURFACE         TION: MECHANICAL RM         RAL BUS       42I         KER       CIRCUIT WIRING         MPS       NO       SIZE       GND       C         15       3       12       12       3/4         -       -       -       -         15       3       12       12       3/4         -       -       -       -       -         15       3       12       12       3/4         -       -       -       -       -         15       3       12       12       3/4         -       -       -       -       -         15       1       -       -       -         30       -       -       -       -         20       -       -       -       -         20       -       -       -       -       -         20       -       -       -       -       -         20       -       -       -       -       -         20       -       -       -       -       -      <
PANEL MP         OLTAGE: 480/277, 3PH, 4W         25 AMPERE BUS         CKT       DESCRIPTI         0.6       43       FAN-4         0.6       45       -         0.6       45       -         0.6       45       -         0.6       47       -         0.6       47       -         0.6       47       -         0.6       47       -         0.6       47       -         0.6       47       -         0.6       51       -         0.6       51       -         53       -       -         55       SPARE       -         57       -       -         59       -       -         61       SPARE       -         63       SPARE       -         64       SPARE       -         65       SPARE       -         67       SPARE       -         68       SPARE       -         73       SPACE       -         74       SPACE       -         75       SPACE	( SECTION II)         225A         ON       BREAKER       CIRCUIT WIRING         ON       P       AMPS       NO       SIZE       GND       C         3       15       3       12       12       3/4         -       -       -       -       -       -         3       15       3       12       12       3/4         -       -       -       -       -       -       -         3       15       3       12       12       3/4         -       -       -       -       -       -       -         3       15       -       -       -       -       -       -         3       30       -       -       100% RA         CKT       DESCRIPTION         4       44       FAN-5         46       -       48         50       SPARE       -         52       -       -         54       -       -         56       SPARE       -         56       SPARE       -         58       -       -         60       -       -         62       SPACE       -         63       SPACE       -         64       SPACE       -         65       SPACE       -         70       SPACE       -         71       SPACE       -         74       SPACE       -         75       SPACE       -         78       SPACE       -         80       SPACE       -         82       SPACE       -	MOUNTING: SURFACE LOCATION: MECHANICAL RM         ATED NEUTRAL BUS       42K A         BREAKER       CIRCUIT WIRING       C         P       AMPS       NO       SIZE       GND       C         3       15       3       12       12       3/4         -       -       -       -       -       -         3       15       3       12       12       3/4         -       -       -       -       -       -         3       15       1       -       -       -         3       15       -       -       -       -         3       30       -       -       -       -         3       30       -       -       -       -         1       20       -       -       -       -         1       20       -       -       -       -         1       20       -       -       -       -       -         1       20       -       -       -       -       -       -         1       20       -       -       -       -       -	C.         PANEL MP (ALT 1) VOLTAGE: 480/277, 3PH, 4W         (SECTION II)         MOUNT LOCAT           Z25A AMPERE BUS         Z25A         100% RATED NEUTF           INN A         CKT         DESCRIPTION         P AMPS NO         SIZE         GND         C         KT         DESCRIPTION         P AMPS           0.6         43         FAN-4         3         15         3         12         12         3/4         44         FAN-5         3         1           0.6         43         FAN-4         3         15         3         12         12         3/4         44         FAN-5         3         1           0.6         43         FAN-4         3         15         12         12         3/4         44         FAN-5         3         1           0.6         45         -         -         -         -         -         48         -         -         -         -         -         48         -         -         </td <td>TING: SURFACE         TION: MECHANICAL RM         RAL BUS       42I         KER       CIRCUIT WIRING         MPS       NO       SIZE       GND       C         15       3       12       12       3/4         -       -       -       -         15       3       12       12       3/4         -       -       -       -       -         15       3       12       12       3/4         -       -       -       -       -         15       3       12       12       3/4         -       -       -       -       -         15       1       -       -       -         30       -       -       -       -         20       -       -       -       -         20       -       -       -       -       -         20       -       -       -       -       -         20       -       -       -       -       -         20       -       -       -       -       -      &lt;</td>	TING: SURFACE         TION: MECHANICAL RM         RAL BUS       42I         KER       CIRCUIT WIRING         MPS       NO       SIZE       GND       C         15       3       12       12       3/4         -       -       -       -         15       3       12       12       3/4         -       -       -       -       -         15       3       12       12       3/4         -       -       -       -       -         15       3       12       12       3/4         -       -       -       -       -         15       1       -       -       -         30       -       -       -       -         20       -       -       -       -         20       -       -       -       -       -         20       -       -       -       -       -         20       -       -       -       -       -         20       -       -       -       -       -      <
PANEL MP         OLTAGE: 480/277, 3PH, 4W         25 AMPERE BUS         CONN         KVA       CKT         DESCRIPTI         0.6       43         0.6       45         0.6       45         0.6       47         0.6       47         0.6       47         0.6       47         0.6       47         0.6       47         0.6       47         0.6       47         0.6       47         0.6       47         0.6       47         0.6       47         0.6       51         0.6       51         51       -         53       -         54       55         55       SPARE         56       SPARE         61       SPARE         63       SPARE         64       SPARE         65       SPARE         67       SPARE         68       SPARE         73       SPACE         74       SPACE         75       SPACE	( SECTION II)         225A         BREAKER       CIRCUIT WIRING         P       AMPS       NO       SIZE       GND       C         3       15       3       12       12       3/4         -       -       3       15       -       -       -       -         -       -       -       -       -       -         3       30       -       -       -       -         -       -       -       -       -       -         1       20       -       -       -       -         1       20       -       -       -       -         1       20       -       -       -       -         1       20       -       -       -       -         1       -       -       -       -       -         <	100% RA         CKT       DESCRIPTION         4       44       FAN-5         46       -         48       -         50       SPARE         52       -         54       -         55       SPARE         56       SPARE         58       -         60       -         62       SPACE         64       SPACE         68       SPACE         68       SPACE         70       SPACE         71       SPACE         72       SPACE         73       SPACE         80       SPACE         80       SPACE         81       SPACE         82       SPACE         84       SPACE         84       SPACE	MOUNTING: SURFACE LOCATION: MECHANICAL RM         ATED NEUTRAL BUS       42K A         BREAKER       CIRCUIT WIRING       C         9       AMPS       NO       SIZE       GND       C         3       15       3       12       12       3/4       A         -       -       -       -       -       -       A         3       15       3       12       12       3/4       A         -       -       -       -       -       -       A         3       15       3       12       12       3/4       A         -       -       -       -       -       -       A         3       15       -       -       -       -       A         -       -       -       -       -       -       A         1       20       -       -       -       -       A         1       20       -       -       -       -       -         1       20       -       -       -       -       -         1       20       -       -       -       -	C.         PANEL MP (ALT 1)         (SECTION II)         MOUNT           225A         100% RATED NEUTE         LOCAT           225A AMPERE BUS         225A         100% RATED NEUTE           CONN         CKT         DESCRIPTION         BREAKER         CIRCUIT WIRING         REAK           CONN         CKT         DESCRIPTION         BREAKER         CIRCUIT WIRING         REAK         BREAK           0.6         43         FAN-4         3         15         12         12         3/4         FAN-5         3         1           0.6         45         -         -         -         -         46         -         -         -         -         46         -         -         -         -         48         -         -         -         -         48         -         -         TING: SURFACE         TION: MECHANICAL RM         RAL BUS       42         KER       CIRCUIT WIRING         MPS       NO       SIZE       GND       C         15       3       12       12       3/4         -       -       -       -         15       3       12       12       3/4         -       -       -       -       -         15       3       12       12       3/4         -       -       -       -       -         15       1       -       -       -         15       -       -       -       -         16       -       -       -       -         30       -       -       -       -         20       -       -       -       -         20       -       -       -       -         20       -       -       -       -         20       -       -       -       -         20       -       -       -       -         20       -       -       -
PANEL MP         OLTAGE: 480/277, 3PH, 4W         25 AMPERE BUS         CONN         KVA       CKT         DESCRIPTI         0.6       43         0.6       45         0.6       45         0.6       47         0.6       47         0.6       47         0.6       47         0.6       47         0.6       47         0.6       47         0.6       47         0.6       47         0.6       47         0.6       47         0.6       47         0.6       51         0.6       51         51       -         53       -         54       55         55       SPARE         56       SPARE         61       SPARE         63       SPARE         64       SPARE         65       SPARE         67       SPARE         68       SPARE         73       SPACE         74       SPACE         75       SPACE	( SECTION II)         225A         BREAKER CIRCUIT WIRING         P       AMPS       NO       SIZE       GND       C         3       15       3       12       12       3/4         -       -       -       -       -       -         3       15       3       12       12       3/4         -       -       3       15       -       -       -       -       -         -       -       -       -       -       -       -         1       20       -       -       -       -       -       -         1       20       -       -       -       -       -       -       -       -       -       -       -       -       -       -       -       -       -       -       -	100% RA         CKT       DESCRIPTION         4       44       FAN-5         46       -       48         50       SPARE       50         51       52       -         52       -       56         54       -       -         56       SPARE       -         58       -       -         60       -       -         62       SPACE       -         64       SPACE       -         68       SPACE       -         70       SPACE       -         71       SPACE       -         72       SPACE       -         74       SPACE       -         75       SPACE       -         76       SPACE       -         80       SPACE       -         82       SPACE       -         84       SPACE       -	MOUNTING: SURFACE LOCATION: MECHANICAL RM         ATED NEUTRAL BUS       42K A         BREAKER       CIRCUIT WIRING       C         1       15       3       12       12       3/4         -       -       C.         PANEL MP (ALT 1)         (SECTION II)         MOUNT           VOLTAGE: 480/277, 3PH, 4W         225A         100% RATED NEUTE           CONN         ERCAKER         CIRCUIT WIRING         ERCAKER         Social and	TING: SURFACE         TION: MECHANICAL RM         RAL BUS       421         KER       CIRCUIT WIRING         MPS       NO       SIZE       GND       C         15       3       12       12       3/4         -       -       -       -         15       3       12       12       3/4         -       -       -       -       -         15       3       12       12       3/4         -       -       -       -       -         15       3       12       12       3/4         -       -       -       -       -         15       -       -       -       -         15       -       -       -       -         30       -       -       -       -         20       -       -       -       -         20       -       -       -       -         20       -       -       -       -       -         20       -       -       -       -       -
PANEL MP         OLTAGE: 480/277, 3PH, 4W         25 AMPERE BUS         CNN         KVA       CKT         0.6       43         0.6       45         0.6       45         0.6       47         0.6       47         0.6       47         0.6       47         0.6       47         0.6       47         0.6       47         0.6       47         0.6       47         0.6       47         0.6       47         0.6       47         0.6       47         0.6       51         51       -         53       -         55       SPARE         57       -         59       -         61       SPARE         63       SPARE         64       SPARE         65       SPARE         67       SPACE         73       SPACE         74       SPACE         81       SPACE         83       SPACE         83       SPAC	(SECTION II)         225A         BREAKER       CIRCUIT WIRING         ON       P       AMPS       NO       SIZE       GND       C         3       15       3       12       12       3/4         -       -       -       -       -       -         3       15       3       12       12       3/4         -       -       -       -       -       -         3       15       -       -       -       -         3       15       -       -       -       -         -       -       -       -       -       -       -         3       30       -       -       -       -       -         1       20       -       -       -       -       -         1       20       -       -       -       -       -       -       -         1       20       -       -       -       -       -       -       -       -       -       -       -       -       -       -       -       -       -       -       - <td>100% RA         CKT       DESCRIPTION         4       44       FAN-5         46       -         48       -         50       SPARE         52       -         54       -         55       SPARE         56       SPARE         58       -         60       -         62       SPACE         64       SPACE         68       SPACE         68       SPACE         70       SPACE         71       SPACE         72       SPACE         73       SPACE         80       SPACE         80       SPACE         81       SPACE         82       SPACE         84       SPACE         84       SPACE</td> <td>MOUNTING: SURFACE LOCATION: MECHANICAL RM         ATED NEUTRAL BUS       42K A         BREAKER       CIRCUIT WIRING       C         9       AMPS       NO       SIZE       GND       C         3       15       3       12       12       3/4       A         -       -       -       -       -       -       C       A         3       15       3       12       12       3/4       A       A         -       -       -       -       -       -       -       A       A         3       15       -       -       -       -       -       -       A       A         3       30       -       -       <td< td=""><td>PANEL MP (ALT 1)         (SECTION II)         MOUNT           VOLTAGE: 480/277, 3PH, 4W         LOCAT         LOCAT           Z25A         MPERE BUS         Z25A         100% RATED NEUTE           A         C(NT)         CKT         DESCRIPTION         P         AMPS NO         SIZE         GND         C         CKT         DESCRIPTION         P         AMPS NO         SIZE         GND         C         CKT         DESCRIPTION         P         AMPS         NO         SIZE         GND         C         CKT         DESCRIPTION         P         AMPS         NO         SIZE         GND         C         CKT         DESCRIPTION         P         AMPS         NO         SIZE         GND         C         CKT         DESCRIPTION         P         AMPS           0.6         45         -         -         -</td><td>TING: SURFACE         TION: MECHANICAL RM         RAL BUS       42         KER       CIRCUIT WIRING         MPS       NO       SIZE       GND       C         15       3       12       12       3/4         -       -       -       -       -         15       3       12       12       3/4         -       -       -       -       -         15       3       12       12       3/4         -       -       -       -       -         15       3       12       12       3/4         -       -       -       -       -         15       1       -       -       -         16       -       -       -       -         30       -       -       -       -         20       -       -       -       -         20       -       -       -       -         20       -       -       -       -         20       -       -       -       -         1.2       B</td></td<></td>	100% RA         CKT       DESCRIPTION         4       44       FAN-5         46       -         48       -         50       SPARE         52       -         54       -         55       SPARE         56       SPARE         58       -         60       -         62       SPACE         64       SPACE         68       SPACE         68       SPACE         70       SPACE         71       SPACE         72       SPACE         73       SPACE         80       SPACE         80       SPACE         81       SPACE         82       SPACE         84       SPACE         84       SPACE	MOUNTING: SURFACE LOCATION: MECHANICAL RM         ATED NEUTRAL BUS       42K A         BREAKER       CIRCUIT WIRING       C         9       AMPS       NO       SIZE       GND       C         3       15       3       12       12       3/4       A         -       -       -       -       -       -       C       A         3       15       3       12       12       3/4       A       A         -       -       -       -       -       -       -       A       A         3       15       -       -       -       -       -       -       A       A         3       30       -       -       <td< td=""><td>PANEL MP (ALT 1)         (SECTION II)         MOUNT           VOLTAGE: 480/277, 3PH, 4W         LOCAT         LOCAT           Z25A         MPERE BUS         Z25A         100% RATED NEUTE           A         C(NT)         CKT         DESCRIPTION         P         AMPS NO         SIZE         GND         C         CKT         DESCRIPTION         P         AMPS NO         SIZE         GND         C         CKT         DESCRIPTION         P         AMPS         NO         SIZE         GND         C         CKT         DESCRIPTION         P         AMPS         NO         SIZE         GND         C         CKT         DESCRIPTION         P         AMPS         NO         SIZE         GND         C         CKT         DESCRIPTION         P         AMPS           0.6         45         -         -         -</td><td>TING: SURFACE         TION: MECHANICAL RM         RAL BUS       42         KER       CIRCUIT WIRING         MPS       NO       SIZE       GND       C         15       3       12       12       3/4         -       -       -       -       -         15       3       12       12       3/4         -       -       -       -       -         15       3       12       12       3/4         -       -       -       -       -         15       3       12       12       3/4         -       -       -       -       -         15       1       -       -       -         16       -       -       -       -         30       -       -       -       -         20       -       -       -       -         20       -       -       -       -         20       -       -       -       -         20       -       -       -       -         1.2       B</td></td<>	PANEL MP (ALT 1)         (SECTION II)         MOUNT           VOLTAGE: 480/277, 3PH, 4W         LOCAT         LOCAT           Z25A         MPERE BUS         Z25A         100% RATED NEUTE           A         C(NT)         CKT         DESCRIPTION         P         AMPS NO         SIZE         GND         C         CKT         DESCRIPTION         P         AMPS NO         SIZE         GND         C         CKT         DESCRIPTION         P         AMPS         NO         SIZE         GND         C         CKT         DESCRIPTION         P         AMPS         NO         SIZE         GND         C         CKT         DESCRIPTION         P         AMPS         NO         SIZE         GND         C         CKT         DESCRIPTION         P         AMPS           0.6         45         -         -         TING: SURFACE         TION: MECHANICAL RM         RAL BUS       42         KER       CIRCUIT WIRING         MPS       NO       SIZE       GND       C         15       3       12       12       3/4         -       -       -       -       -         15       3       12       12       3/4         -       -       -       -       -         15       3       12       12       3/4         -       -       -       -       -         15       3       12       12       3/4         -       -       -       -       -         15       1       -       -       -         16       -       -       -       -         30       -       -       -       -         20       -       -       -       -         20       -       -       -       -         20       -       -       -       -         20       -       -       -       -         1.2       B
PANEL MP         OLTAGE: 480/277, 3PH, 4W         25 AMPERE BUS         CNN         KVA         CKT         DESCRIPTI         0.6         43         7         0.6         45         0.6         45         0.6         47         49         51         53         55         57         53         57         53         55         57         59         61         SPARE         63         59         61         SPARE         63         64         57         65         57         61         SPARE         63         54         55         57         63         59         61         SPARE         62         73         SPACE         71         73 <t< td=""><td>(SECTION II)         225A         BREAKER       CIRCUIT WIRING         ON       P       AMPS       NO       SIZE       GND       C         3       15       3       12       12       3/4         -       -       -       -       -       -         3       15       3       12       12       3/4         -       -       -       -       -       -         3       15       -       -       -       -         3       15       -       -       -       -         -       -       -       -       -       -       -         3       30       -       -       -       -       -         1       20       -       -       -       -       -         1       20       -       -       -       -       -       -       -         1       20       -       -       -       -       -       -       -       -       -       -       -       -       -       -       -       -       -       -       -<td>100% RA         CKT       DESCRIPTION         4       44       FAN-5         46       -       -         48       -       -         50       SPARE       -         52       -       -         54       -       -         56       SPARE       -         58       -       -         60       -       -         62       SPACE       -         64       SPACE       -         65       SPACE       -         66       SPACE       -         70       SPACE       -         72       SPACE       -         74       SPACE       -         78       SPACE       -         80       SPACE       -         82       SPACE       -         84       SPACE</td><td>MOUNTING: SURFACE LOCATION: MECHANICAL RM         ATED NEUTRAL BUS       42K A         BREAKER       CIRCUIT WIRING       C         3       15       3       12       12       3/4         -       -       -       -       -       -         3       15       3       12       12       3/4       -         -       -       -       -       -       -       -       -         3       15       3       12       12       3/4       -         -       -       -       -       -       -       -       -         3       15       -       -       -&lt;</td><td>PANEL MP (ALT 1)         (SECTION II)         MOUNT           VOLTAGE: 480/277, 3PH, 4W         LOCAT         LOCAT           ZSA AMPERE BUS         225A         100% RATED NEUTF           CONN         CKT         DESCRIPTION         P AMPS NO SIZE         CNC           CA         0.6         43 FAN-4         3         15         3         12         12         3/4         44 FAN-5         3         1           0.6         43 FAN-4         3         15         3         12         12         3/4         44 FAN-5         3         1           0.6         43 FAN-4         3         15         1         46         -         -         -<!--</td--><td>TING: SURFACE         TION: MECHANICAL RM         RAL BUS       42         (ER       CIRCUIT WIRING         MPS       NO       SIZE       GND       C         15       3       12       12       3/4         -       -       -       -         15       3       12       12       3/4         -       -       -       -       -         15       3       12       12       3/4         -       -       -       -       -         15       -       -       -       -         30       -       -       -       -         30       -       -       -       -         20       -       -       -       -         20       -       -       -       -         20       -       -       -       -         20       -       -       -       -         20       -       -       -       -         10       -       -       -       -         1.2       B       <t< td=""></t<></td></td></td></t<>	(SECTION II)         225A         BREAKER       CIRCUIT WIRING         ON       P       AMPS       NO       SIZE       GND       C         3       15       3       12       12       3/4         -       -       -       -       -       -         3       15       3       12       12       3/4         -       -       -       -       -       -         3       15       -       -       -       -         3       15       -       -       -       -         -       -       -       -       -       -       -         3       30       -       -       -       -       -         1       20       -       -       -       -       -         1       20       -       -       -       -       -       -       -         1       20       -       -       -       -       -       -       -       -       -       -       -       -       -       -       -       -       -       -       - <td>100% RA         CKT       DESCRIPTION         4       44       FAN-5         46       -       -         48       -       -         50       SPARE       -         52       -       -         54       -       -         56       SPARE       -         58       -       -         60       -       -         62       SPACE       -         64       SPACE       -         65       SPACE       -         66       SPACE       -         70       SPACE       -         72       SPACE       -         74       SPACE       -         78       SPACE       -         80       SPACE       -         82       SPACE       -         84       SPACE</td> <td>MOUNTING: SURFACE LOCATION: MECHANICAL RM         ATED NEUTRAL BUS       42K A         BREAKER       CIRCUIT WIRING       C         3       15       3       12       12       3/4         -       -       -       -       -       -         3       15       3       12       12       3/4       -         -       -       -       -       -       -       -       -         3       15       3       12       12       3/4       -         -       -       -       -       -       -       -       -         3       15       -       -       -&lt;</td> <td>PANEL MP (ALT 1)         (SECTION II)         MOUNT           VOLTAGE: 480/277, 3PH, 4W         LOCAT         LOCAT           ZSA AMPERE BUS         225A         100% RATED NEUTF           CONN         CKT         DESCRIPTION         P AMPS NO SIZE         CNC           CA         0.6         43 FAN-4         3         15         3         12         12         3/4         44 FAN-5         3         1           0.6         43 FAN-4         3         15         3         12         12         3/4         44 FAN-5         3         1           0.6         43 FAN-4         3         15         1         46         -         -         -<!--</td--><td>TING: SURFACE         TION: MECHANICAL RM         RAL BUS       42         (ER       CIRCUIT WIRING         MPS       NO       SIZE       GND       C         15       3       12       12       3/4         -       -       -       -         15       3       12       12       3/4         -       -       -       -       -         15       3       12       12       3/4         -       -       -       -       -         15       -       -       -       -         30       -       -       -       -         30       -       -       -       -         20       -       -       -       -         20       -       -       -       -         20       -       -       -       -         20       -       -       -       -         20       -       -       -       -         10       -       -       -       -         1.2       B       <t< td=""></t<></td></td>	100% RA         CKT       DESCRIPTION         4       44       FAN-5         46       -       -         48       -       -         50       SPARE       -         52       -       -         54       -       -         56       SPARE       -         58       -       -         60       -       -         62       SPACE       -         64       SPACE       -         65       SPACE       -         66       SPACE       -         70       SPACE       -         72       SPACE       -         74       SPACE       -         78       SPACE       -         80       SPACE       -         82       SPACE       -         84       SPACE	MOUNTING: SURFACE LOCATION: MECHANICAL RM         ATED NEUTRAL BUS       42K A         BREAKER       CIRCUIT WIRING       C         3       15       3       12       12       3/4         -       -       -       -       -       -         3       15       3       12       12       3/4       -         -       -       -       -       -       -       -       -         3       15       3       12       12       3/4       -         -       -       -       -       -       -       -       -         3       15       -       -       -<	PANEL MP (ALT 1)         (SECTION II)         MOUNT           VOLTAGE: 480/277, 3PH, 4W         LOCAT         LOCAT           ZSA AMPERE BUS         225A         100% RATED NEUTF           CONN         CKT         DESCRIPTION         P AMPS NO SIZE         CNC           CA         0.6         43 FAN-4         3         15         3         12         12         3/4         44 FAN-5         3         1           0.6         43 FAN-4         3         15         3         12         12         3/4         44 FAN-5         3         1           0.6         43 FAN-4         3         15         1         46         -         -         </td <td>TING: SURFACE         TION: MECHANICAL RM         RAL BUS       42         (ER       CIRCUIT WIRING         MPS       NO       SIZE       GND       C         15       3       12       12       3/4         -       -       -       -         15       3       12       12       3/4         -       -       -       -       -         15       3       12       12       3/4         -       -       -       -       -         15       -       -       -       -         30       -       -       -       -         30       -       -       -       -         20       -       -       -       -         20       -       -       -       -         20       -       -       -       -         20       -       -       -       -         20       -       -       -       -         10       -       -       -       -         1.2       B       <t< td=""></t<></td>	TING: SURFACE         TION: MECHANICAL RM         RAL BUS       42         (ER       CIRCUIT WIRING         MPS       NO       SIZE       GND       C         15       3       12       12       3/4         -       -       -       -         15       3       12       12       3/4         -       -       -       -       -         15       3       12       12       3/4         -       -       -       -       -         15       -       -       -       -         30       -       -       -       -         30       -       -       -       -         20       -       -       -       -         20       -       -       -       -         20       -       -       -       -         20       -       -       -       -         20       -       -       -       -         10       -       -       -       -         1.2       B <t< td=""></t<>
PANEL MP         OLTAGE: 480/277, 3PH, 4W         25 AMPERE BUS         CNN         KVA         CKT       DESCRIPTI         0.6       43         0.6       43         0.6       45         0.6       47         0.6       47         49       SPARE         51       -         53       -         55       SPARE         57       -         59       -         61       SPARE         63       SPARE         63       SPARE         63       SPARE         64       SPARE         65       SPARE         67       SPARE         68       SPARE         71       SPACE         73       SPACE         74       SPACE         75       SPACE         79       SPACE         81       SPACE         83       SPACE         83       SPACE         83       SPACE         83       SPACE         83       SPACE         83	( SECTION II) 225A BREAKER CIRCUIT WIRING P AMPS NO SIZE GND C 3 15 3 12 12 3/4  3 15 3 12 12 3/4  3 15 3 15 3 3 0 1 20 1 20	100% RA         CKT       DESCRIPTION         4       44       FAN-5         46       -       48         50       SPARE       50         52       -       54         55       SPARE       55         56       SPARE       58         50       -       60         52       -       -         54       -       -         58       -       -         60       -       -         62       SPACE       -         64       SPACE       -         65       SPACE       -         66       SPACE       -         70       SPACE       -         72       SPACE       -         73       SPACE       -         80       SPACE       -         81       SPACE       -         82       SPACE       -         84       SPACE       -         84       SPACE       -         84       SPACE       -         84       SPACE       -         700%       RACE	MOUNTING: SURFACE LOCATION: MECHANICAL RM         ATED NEUTRAL BUS       42K A         BREAKER       CIRCUIT WIRING       C         P       AMPS       NO       SIZE       GND       C         3       15       3       12       12       3/4       F         -       -       -       -       -       -       F         3       15       3       12       12       3/4       F         -       -       -       -       -       -       F         3       15       -       -       -       -       F         -       -       -       -       -       -       F         3       30       -       -       -       -       F         -       -       -       -       -       -       F         1       20       -       -       -       -       F         1       20       -       -       -       -       F         1       20       -       -       -       -       F         1       -       -       -       -       -       -	PANEL MP (ALT 1)         (SECTION III)         MOUNT           VOLTAGE: 480/277, 3PH, 4W         225A         100% RATED NEUTE           225A AMPERE BUS         225A         100% RATED NEUTE           XA         Crt         DESCRIPTION         BREAKER         CIRCUIT WIRING           CAN         Crt         DESCRIPTION         P AMPS NO         SIZE         ND         Crt           0.6         43         FAN-4         3         15         3         12         12         3/4           0.6         43         FAN-4         3         15         3         12         12         3/4           0.6         47         -         -         TING: SURFACE         TION: MECHANICAL RM         RAL BUS       42         (ER       CIRCUIT WIRING         MPS       NO       SIZE       GND       C         15       3       12       12       3/4         -       -       -       -         15       3       12       12       3/4         -       -       -       -       -         15       3       12       12       3/4         -       -       -       -       -         15       -       -       -       -         30       -       -       -       -         30       -       -       -       -         20       -       -       -       -         20       -       -       -       -         20       -       -       -       -         20       -       -       -       -         20       -       -       -       -         10       -       -       -       -         1.2       B <t< td=""></t<>
PANEL MP         YOLTAGE: 480/277, 3PH, 4W         25 AMPERE BUS         CONN         KVA       CKT         DESCRIPTI         0.6       43         43       FAN-4         0.6       45         0.6       45         0.6       47         49       SPARE         51       -         53       -         55       SPARE         57       -         59       -         61       SPARE         63       SPARE         63       SPARE         65       SPARE         67       SPARE         68       SPARE         71       SPARE         69       SPARE         71       SPACE         73       SPACE         79       SPACE         81       SPACE         83       SPACE         83       SPACE         83       SPACE         79       SPACE         81       SPACE         83       SPACE         81       SPACE         83	(SECTION II)         225A         BREAKER CIRCUIT WIRING         ON       P       AMPS       NO       SIZE       GND       C         3       15       3       12       12       3/4         -       -       -       -       -       -         3       15       3       12       12       3/4         -       -       -       -       -       -       -         3       15       -       -       100% R4         2       CKT       DESCRIPTION         4       44       FAN-5       46       -         48       -       50       SPARE       52       -         51       52       -       54       -       56       SPARE       58       -       60       -       62       SPACE       66       SPACE       66       SPACE       68       SPACE       68       SPACE       68       SPACE       70       SPACE       72       SPACE       73       SPACE       74       SPACE       75       SPACE       80       SPACE       80       SPACE       80       SPACE       82       SPACE       84       SPACE       84       SPACE       74       SPACE       74       SPACE       75       SPACE       76       SPACE       77       SPACE       78       SPACE       74       SPACE       74       SPACE       74       SPACE       74       SPACE       76       SPACE       78       SPACE       74       SPACE       74       SPACE       74       SPACE       74       SPACE       74       SPACE       74       SPACE       76       SPACE       74 <t< td=""><td>MOUNTING: SURFACE LOCATION: MECHANICAL RM         ATED NEUTRAL BUS       42K A         BREAKER       CIRCUIT WIRING       C         3       15       3       12       3/4         -       -       -       -       -         3       15       3       12       12       3/4         -       -       -       -       -       -         3       15       3       12       12       3/4         -       -       -       -       -       -         3       15       -       -       -       -         3       30       -       -       -       -         -       -       -       -       -       -         1       20       -       -       -       -         1       20       -       -       -       -         1       20       -       -       -       -         1       20       -       -       -       -         1       20       -       -       -       -         1       -       -       -       -</td><td>PANEL MP (ALT 1)         (SECTION II)         MOUNT           VOLTAGE: 480/277, 3PH, 4W         LOCAT         LOCAT           226A         100% RATED NEUTF         LOCAT           INA         Conn         CKT         DESCRIPTION         BREAKER         CIRCUIT WIRING           CNN         CKT         DESCRIPTION         BREAKER         CIRCUIT WIRING         CKT         DESCRIPTION         P AMPS           0.6         43         FAN4         3         15         3         12         12         3/4         44         FAN5         3         1           0.6         43         FAN4         3         15         1         2         1         1         1</td><td>TING: SURFACE         TION: MECHANICAL RM         RAL BUS       424         (CRCUIT WIRING         MPS       NO       SIZE       GND       C         15       3       12       12       3/4         -       -       -       -       -         15       3       12       12       3/4         -       -       -       -       -         15       3       12       12       3/4         -       -       -       -       -         15       -       -       -       -         16       -       -       -       -         17       -       -       -       -         30       -       -       -       -         20       -       -       -       -         20       -       -       -       -       -         20       -       -       -       -       -         21       -       -       -       -       -         12       B       1.2       C       1.2</td></t<>	MOUNTING: SURFACE LOCATION: MECHANICAL RM         ATED NEUTRAL BUS       42K A         BREAKER       CIRCUIT WIRING       C         3       15       3       12       3/4         -       -       -       -       -         3       15       3       12       12       3/4         -       -       -       -       -       -         3       15       3       12       12       3/4         -       -       -       -       -       -         3       15       -       -       -       -         3       30       -       -       -       -         -       -       -       -       -       -         1       20       -       -       -       -         1       20       -       -       -       -         1       20       -       -       -       -         1       20       -       -       -       -         1       20       -       -       -       -         1       -       -       -       -	PANEL MP (ALT 1)         (SECTION II)         MOUNT           VOLTAGE: 480/277, 3PH, 4W         LOCAT         LOCAT           226A         100% RATED NEUTF         LOCAT           INA         Conn         CKT         DESCRIPTION         BREAKER         CIRCUIT WIRING           CNN         CKT         DESCRIPTION         BREAKER         CIRCUIT WIRING         CKT         DESCRIPTION         P AMPS           0.6         43         FAN4         3         15         3         12         12         3/4         44         FAN5         3         1           0.6         43         FAN4         3         15         1         2         1         1         TING: SURFACE         TION: MECHANICAL RM         RAL BUS       424         (CRCUIT WIRING         MPS       NO       SIZE       GND       C         15       3       12       12       3/4         -       -       -       -       -         15       3       12       12       3/4         -       -       -       -       -         15       3       12       12       3/4         -       -       -       -       -         15       -       -       -       -         16       -       -       -       -         17       -       -       -       -         30       -       -       -       -         20       -       -       -       -         20       -       -       -       -       -         20       -       -       -       -       -         21       -       -       -       -       -         12       B       1.2       C       1.2
PANEL MP         OLTAGE: 480/277, 3PH, 4W         25 AMPERE BUS         CONN       CKT       DESCRIPTI         0.6       43       FAN-4         0.6       43       FAN-4         0.6       45       -         0.6       47       -         49       SPARE       -         51       -       -         53       -       -         55       SPARE       -         57       -       -         59       -       -         61       SPARE       -         63       SPARE       -         73       SPACE       -         73       SPACE       -         79       SPACE       -         79       SPACE       -         81       SPACE       -         83       SPACE       -         79       SPACE       -         81       SPACE       - <t< td=""><td>(SECTION II)         225A         BREAKER CIRCUIT WIRING         ON       P       AMPS       NO       SIZE       GND       C         3       15       3       12       12       3/4         -       -       -       -       -       -         3       15       3       12       12       3/4         -       -       -       -       -       -         3       15       -       -       -       -         3       30       -       -       -       -         3       30       -       -       -       -         1       20       -       -       -       -         1       20       -       -       -       -         1       20       -       -       -       -         1       20       -       -       -       -         1       20       -       -       -       -         1       20       -       -       -       -         1       20       -       -       -       -</td><td>100% R4         2       CKT       DESCRIPTION         4       44       FAN-5       46       -         4       44       FAN-5       46       -         48       -       50       SPARE       52       -         51       52       -       54       -       55         52       -       55       SPARE       58       -         53       -       60       -       66       SPACE       66         60       -       66       SPACE       66       SPACE       66       SPACE       70       SPACE       71       SPACE       72       SPACE       73       SPACE       74       SPACE       78       SPACE       78       SPACE       78       SPACE       78       SPACE       74       SPACE       75       SPACE       75       SP</td><td>MOUNTING: SURFACE LOCATION: MECHANICAL RM         ATED NEUTRAL BUS       42K A         BREAKER       CIRCUIT WIRING       C         3       15       3       12       3/4         -       -       -       -       -         3       15       3       12       12       3/4         -       -       -       -       -       -         3       15       3       12       12       3/4         -       -       -       -       -       -         3       15       -       -       -       -         3       30       -       -       -       -         -       -       -       -       -       -         1       20       -       -       -       -         1       20       -       -       -       -         1       20       -       -       -       -         1       20       -       -       -       -         1       -       -       -       -       -       -         1       -       -       -       -</td><td>PANEL MP (ALT 1)         (SECTION II)         MOUNT           VOLTAGE: 480/277, 3PH, 4W         LOCAT         100% RATED NEUTE           CONN         CKT         DESCRIPTION         P AMPSR BUS         225A           INA         0.6         43         FAN-4         3         15         3         12         12         3/4         44         FAN-5         3         1           0.6         43         FAN-4         3         15         3         1         22         CKT         DESCRIPTION         P AM           0.6         43         FAN-4         3         15         -         -         -         46         -         -         -         -         48         -         -         -         -         48         -         -         -</td><td>TING: SURFACE         TING: SURFACE         TING: MECHANICAL RM         RAL BUS       424         CIRCUIT WIRING         MPS       NO       SIZE       GND       C         15       3       12       12       3/4         -       -       -       -         15       3       12       12       3/4         -       -       -       -       -         15       -       -       -       -         16       -       -       -       -         30       -       -       -       -       -         10       -       -       -       -       -         20       -       -       -       -       -         20       -       -       -       -       -         20       -       -       -       -       -         20       -       -       -       -       -       -         20       -       -       -       -       -       -          -       -       -</td></t<>	(SECTION II)         225A         BREAKER CIRCUIT WIRING         ON       P       AMPS       NO       SIZE       GND       C         3       15       3       12       12       3/4         -       -       -       -       -       -         3       15       3       12       12       3/4         -       -       -       -       -       -         3       15       -       -       -       -         3       30       -       -       -       -         3       30       -       -       -       -         1       20       -       -       -       -         1       20       -       -       -       -         1       20       -       -       -       -         1       20       -       -       -       -         1       20       -       -       -       -         1       20       -       -       -       -         1       20       -       -       -       -	100% R4         2       CKT       DESCRIPTION         4       44       FAN-5       46       -         4       44       FAN-5       46       -         48       -       50       SPARE       52       -         51       52       -       54       -       55         52       -       55       SPARE       58       -         53       -       60       -       66       SPACE       66         60       -       66       SPACE       66       SPACE       66       SPACE       70       SPACE       71       SPACE       72       SPACE       73       SPACE       74       SPACE       78       SPACE       78       SPACE       78       SPACE       78       SPACE       74       SPACE       75       SPACE       75       SP	MOUNTING: SURFACE LOCATION: MECHANICAL RM         ATED NEUTRAL BUS       42K A         BREAKER       CIRCUIT WIRING       C         3       15       3       12       3/4         -       -       -       -       -         3       15       3       12       12       3/4         -       -       -       -       -       -         3       15       3       12       12       3/4         -       -       -       -       -       -         3       15       -       -       -       -         3       30       -       -       -       -         -       -       -       -       -       -         1       20       -       -       -       -         1       20       -       -       -       -         1       20       -       -       -       -         1       20       -       -       -       -         1       -       -       -       -       -       -         1       -       -       -       -	PANEL MP (ALT 1)         (SECTION II)         MOUNT           VOLTAGE: 480/277, 3PH, 4W         LOCAT         100% RATED NEUTE           CONN         CKT         DESCRIPTION         P AMPSR BUS         225A           INA         0.6         43         FAN-4         3         15         3         12         12         3/4         44         FAN-5         3         1           0.6         43         FAN-4         3         15         3         1         22         CKT         DESCRIPTION         P AM           0.6         43         FAN-4         3         15         -         -         -         46         -         -         -         -         48         -         -         -         -         48         -         -         TING: SURFACE         TING: SURFACE         TING: MECHANICAL RM         RAL BUS       424         CIRCUIT WIRING         MPS       NO       SIZE       GND       C         15       3       12       12       3/4         -       -       -       -         15       3       12       12       3/4         -       -       -       -       -         15       -       -       -       -         16       -       -       -       -         30       -       -       -       -       -         10       -       -       -       -       -         20       -       -       -       -       -         20       -       -       -       -       -         20       -       -       -       -       -         20       -       -       -       -       -       -         20       -       -       -       -       -       -          -       -       -
PANEL MP OLTAGE: 480/277, 3PH, 4W 25 AMPERE BUS CONN KVA CKT DESCRIPTI 0.6 43 FAN-4 0.6 45 - 0.6 47 - 49 SPARE 51 - 53 - 55 SPARE 57 - 59 - 61 SPARE 63 SPARE 63 SPARE 65 SPARE 65 SPARE 67 SPARE 69 SPARE 71 SPARE 73 SPACE 73 SPACE 75 SPACE 75 SPACE 77 SPACE 79 SPACE 81 SPACE 81 SPACE 83 SPACE 79 SPACE 81 SPACE 83 SPACE 79 SPACE 81 SPACE 79 SPACE 81 SPACE 79 SPACE 79 SPACE 81 SPACE 79 SPACE 70 SPACE 71 SPACE 71 SPACE 72 SPACE 73 SPACE 74 SPACE 75 SPACE 75 SPACE 77 SPACE 79 SPACE 70 SPACE 71 SPACE 71 SPACE 72 SPACE 73 SPACE 74 SPACE 75 SPACE 75 SPACE 77 SPACE 79 SPACE 71 SPACE 71 SPACE 72 SPACE 73 SPACE 74 SPACE 75 SPACE 75 SPACE 77 SPACE 79 SPACE 70 SPACE 71 SPACE 71 SPACE 72 SPACE 73 SPACE 74 SPACE 75 SPACE 75 SPACE 77 SPACE 77 SPACE 79 SPACE 70 SPACE 71 SPACE 71 SPACE 72 SPACE 73 SPACE 74 SPACE 75 SPACE 75 SPACE 77 SPACE 77 SPACE 70 SPACE 70 SPACE 71 SPACE 72 SPACE 73 SPACE 74 SPACE 75 SPACE 75 SPACE 77 SPACE 77 SPACE 70 SPACE 70 SPACE 70 SPACE 71 SPACE 72 SPACE 73 SPACE 74 SPACE 75 SPACE 75 SPACE 77 SPACE 77 SPACE 77 SPACE 77 SPACE 77 SPACE 79 SPACE 70 SPACE 7	( SECTION II)         225A         BREAKER       CIRCUIT WIRING         0       P       AMPS       NO       SIZE       GND       C         3       15       3       12       12       3/4         -       -       -       -       -       -         3       15       3       12       12       3/4         -       -       -       -       -       -       -         3       15       -       -       -       -       -         -       -       -       -       -       -       -         3       30       -       -       -       -       -         -       -       -       -       -       -       -         1       20       -       -       -       -       -         1       20       -       -       -       -       -       -         1       20       -       -       -       -       -       -       -       -       -       -       -       -       -       -       -       -       -       -	100% R4         2       CKT       DESCRIPTION         4       44       FAN-5       46       -         46       -       48       -       50       SPARE       52       -       54       -       55       54       -       56       SPARE       58       -       60       -       66       SPACE       66       SPACE       66       SPACE       66       SPACE       68       SPACE       68       SPACE       70       SPACE       72       SPACE       74       SPACE       75       SPACE       80       SPACE       80       SPACE       80       SPACE       82       SPACE       82       SPACE       82       SPACE       84       SPACE       74       SPACE       75       SPACE       75       SPACE	MOUNTING: SURFACE LOCATION: MECHANICAL RM         ATED NEUTRAL BUS       42K A         BREAKER       CIRCUIT WIRING       C         3       15       3       12       3/4         -       -       -       -       -         3       15       3       12       12       3/4         -       -       -       -       -       -         3       15       3       12       12       3/4         -       -       -       -       -       -         3       15       -       -       -       -         3       30       -       -       -       -         -       -       -       -       -       -         1       20       -       -       -       -         1       20       -       -       -       -         1       20       -       -       -       -         1       20       -       -       -       -         1       -       -       -       -       -       -         1       -       -       -       -	PANEL MP (ALT 1)         (SECTION III)         MOUNT           C.         IZSA AMPERE BUS         226A         100% RATED NEUTON         P AMP           NA         CONN         CKT         DESCRIPTION         P AMPS NO         SIZE         GND         C         CKT         DESCRIPTION         P AMP           0.6         43         FAN-4         3         15         3         12         12         3/4         44         FAN-5         3         1           0.6         43         FAN-4         3         15         -         -         -         46         -         -         -         -         48         -         -         -         -         48         -         -         TING: SURFACE         TING: SURFACE         RAL BUS       42P         RAL BUS       42P         KER       CIRCUIT WIRING         MPS       NO       SIZE       GND       C         15       3       12       12       3/4         -       -       -       -       -         15       3       12       12       3/4         -       -       -       -       -         15       3       12       12       3/4         -       -       -       -       -         15       -       -       -       -         16       -       -       -       -         20       -       -       -       -         20       -       -       -       -         20       -       -       -       -         20       -       -       -       -         10       -       -       -       -       -         12       B       1.2       C       1.2       -         1.12
PANEL MP           OOLTAGE: 480/277, 3PH, 4W           25 AMPERE BUS           CKT         DESCRIPTI           0.6         43         FAN-4           0.6         45         -           0.6         45         -           0.6         47         -           49         SPARE         -           51         -         -           53         -         -           55         SPARE         -           57         -         -           59         -         61           63         SPARE         -           65         SPARE         -           67         SPARE         -           69         SPARE         -           71         SPACE         -           73         SPACE         -           75         SPACE         -           79         SPACE         -           81         SPACE         -           79         SPACE         -           81         SPACE         -           70         SPACE         -           83         SPACE	(SECTION II)         BREAKER       CIRCUIT WIRING         ON       P       AMPS       NO       SIZE       GND       C         3       15       3       12       12       3/4         -       -       -       -       -       -         3       15       3       12       12       3/4         -       -       -       -       -       -       -         3       15       -       -       -       -       -         -       -       -       -       -       -       -         3       30       -       -       -       -       -         1       20       -       -       -       -       -         1       20       -       -       -       -       -         1       20       -       -       -       -       -       -         1       20       -       -       -       -       -       -       -       -       -       -       -       -       -       -       -       -       -       -       -	100% R/         2       CKT       DESCRIPTION         4       44       FAN-5         46       -       48         50       SPARE         52       -         54       -         58       -         60       -         62       SPARE         63       SPACE         64       SPACE         68       SPACE         70       SPACE         71       SPACE         72       SPACE         73       SPACE         80       SPACE         80       SPACE         81       SPACE         82       SPACE         84       SPACE         84       SPACE         84       SPACE         74       SPACE         75       SPACE         76       SPACE         77       SPACE         80       SPACE         81       SPACE         82       SPACE         84       SPACE         70       CKT         100% R4         3/	MOUNTING: SURFACE LOCATION: MECHANICAL RM         ATED NEUTRAL BUS       42K A         BREAKER       CIRCUIT WIRING       C         9       AMPS       NO       SIZE       GND       C         3       15       3       12       12       3/4       -         -       -       -       -       -       -       -       -         3       15       3       12       12       3/4       -       -       PANEL MP (ALT 1)         (SECTION III)         MOUNT           CG         0.5         43         25A         100%, RATED NEURO         BREAKER         CIRCUT WIRING         CKT         DESCRIPTION         P AMPS           CONN         KVA         CKT         DESCRIPTION         P AMPS         NO         SIZE         GNO         C         CKT         DESCRIPTION         P AMA           0.6         45         -         -         -         -         44         FAN-5         3         1           0.6         47         -         -         -         -         48         -         -         <t< td=""><td>TING: SURFACE         TION: MECHANICAL RM         RAL BUS       424         CIRCUIT WIRING         MPS       NO       SIZE       GND       C         15       3       12       12       3/4         -       -       -       -       -         15       3       12       12       3/4         -       -       -       -       -         15       3       12       12       3/4         -       -       -       -       -         15       -       -       -       -         15       -       -       -       -         16       -       -       -       -         17       -       -       -       -         20       -       -       -       -         20       -       -       -       -       -         20       -       -       -       -       -         20       -       -       -       -       -         1.2       B       1.2       C       1.2</td></t<>	TING: SURFACE         TION: MECHANICAL RM         RAL BUS       424         CIRCUIT WIRING         MPS       NO       SIZE       GND       C         15       3       12       12       3/4         -       -       -       -       -         15       3       12       12       3/4         -       -       -       -       -         15       3       12       12       3/4         -       -       -       -       -         15       -       -       -       -         15       -       -       -       -         16       -       -       -       -         17       -       -       -       -         20       -       -       -       -         20       -       -       -       -       -         20       -       -       -       -       -         20       -       -       -       -       -         1.2       B       1.2       C       1.2
PANEL MP         YOLTAGE: 480/277, 3PH, 4W         25 AMPERE BUS         CKT       DESCRIPTI         0.6       43       FAN-4         0.6       45       -         0.6       45       -         0.6       45       -         0.6       45       -         0.6       47       -         49       SPARE         51       -         53       -         55       SPARE         57       -         59       -         61       SPARE         63       SPARE         63       SPARE         63       SPARE         63       SPARE         63       SPARE         71       SPARE         73       SPACE         79       SPACE         79       SPACE         81       SPACE         83       SPACE         79       SPACE         81       SPACE         83       SPACE         90       CONNECTED LOAD (SECTION II)         0.2       1       FAN-1         0	( SECTION II)         225A         BREAKER       CIRCUIT WIRING         DN       P       AMPS       NO       SIZE       GND       C         3       15       3       12       12       3/4         -       -       -       -       -       -       -         3       15       3       12       12       3/4         -       -       -       -       -       -       -         3       15       -       -       -       -       -       -         -       -       -       -       -       -       -       -       -         3       30       -       -       <td>100% R/         CKT       DESCRIPTION         4       44       FAN-5         46       -       48         50       SPARE       52         54       -       56         56       SPARE       58         60       -       60         62       SPACE       66         63       SPACE       68         64       SPACE       68         70       SPACE       72         74       SPACE       73         75       SPACE       74         76       SPACE       80         78       SPACE       83         80       SPACE       84         84       SPACE       84         84       SPACE       84         84       SPACE       100% R/         NG       C       CKT       DESCRIPTION         3/4       2       KITCHEN EXHAUST FAN         3/4       6       8       KITCHEN MAKE-UP UNI         3/4       10       12</td> <td>MOUNTING: SURFACE LOCATION: MECHANICAL RM         ATED NEUTRAL BUS       42K A         BREAKER       CIRCUIT WIRING       C         3       15       3       12       3/4         -       -       -       -       -         3       15       3       12       3/4       -         -       -       -       -       -       -       -         -       -       -       -       -       -       -         3       15       -       -       -       -       -         -       -       -       -       -       -       -       -         3       30       -       -       -</td> <td>PANEL MP (ALT 1)         (SECTION III)         MOUNT           COLTAGE: 40/27, 3PH, 4W         225A         100% RATED NEUTE           CONN         CKT         DESCRIPTION         PIAMPS NO         SIZE         GND         C         CKT         DESCRIPTION         PIAMPS           CONN         CKT         DESCRIPTION         PIAMPS         NO         SIZE         GND         C         CKT         DESCRIPTION         PIAM           0.6         45         -         -         -         -         -         46         -         -         -</td> <td>TING: SURFACE         TING: MECHANICAL RM         RAL BUS       424         CIRCUIT WIRING         MPS       NO       SIZE       GND       C         15       3       12       12       3/4         -       -       -       -         15       3       12       12       3/4         -       -       -       -       -         15       3       12       12       3/4         -       -       -       -       -         15       -       -       -       -         15       -       -       -       -         15       -       -       -       -         15       -       -       -       -         10       -       -       -       -         10       -       -       -       -       -         20       -       -       -       -       -         20       -       -       -       -       -         12       B       1.2       C       1.2         34</td>	100% R/         CKT       DESCRIPTION         4       44       FAN-5         46       -       48         50       SPARE       52         54       -       56         56       SPARE       58         60       -       60         62       SPACE       66         63       SPACE       68         64       SPACE       68         70       SPACE       72         74       SPACE       73         75       SPACE       74         76       SPACE       80         78       SPACE       83         80       SPACE       84         84       SPACE       84         84       SPACE       84         84       SPACE       100% R/         NG       C       CKT       DESCRIPTION         3/4       2       KITCHEN EXHAUST FAN         3/4       6       8       KITCHEN MAKE-UP UNI         3/4       10       12	MOUNTING: SURFACE LOCATION: MECHANICAL RM         ATED NEUTRAL BUS       42K A         BREAKER       CIRCUIT WIRING       C         3       15       3       12       3/4         -       -       -       -       -         3       15       3       12       3/4       -         -       -       -       -       -       -       -         -       -       -       -       -       -       -         3       15       -       -       -       -       -         -       -       -       -       -       -       -       -         3       30       -       -       PANEL MP (ALT 1)         (SECTION III)         MOUNT           COLTAGE: 40/27, 3PH, 4W         225A         100% RATED NEUTE           CONN         CKT         DESCRIPTION         PIAMPS NO         SIZE         GND         C         CKT         DESCRIPTION         PIAMPS           CONN         CKT         DESCRIPTION         PIAMPS         NO         SIZE         GND         C         CKT         DESCRIPTION         PIAM           0.6         45         -         -         -         -         -         46         -         -         TING: SURFACE         TING: MECHANICAL RM         RAL BUS       424         CIRCUIT WIRING         MPS       NO       SIZE       GND       C         15       3       12       12       3/4         -       -       -       -         15       3       12       12       3/4         -       -       -       -       -         15       3       12       12       3/4         -       -       -       -       -         15       -       -       -       -         15       -       -       -       -         15       -       -       -       -         15       -       -       -       -         10       -       -       -       -         10       -       -       -       -       -         20       -       -       -       -       -         20       -       -       -       -       -         12       B       1.2       C       1.2         34
PANEL MP           OLTAGE: 480/277, 3PH, 4W           25 AMPERE BUS           CKT         DESCRIPTI           0.6         43         FAN-4           0.6         43         FAN-4           0.6         43         FAN-4           0.6         45         -           0.6         47         -           49         SPARE         -           51         -         -           53         -         -           53         -         -           53         -         -           53         -         -           57         -         -           59         -         -           61         SPARE         -           63         SPARE         -           67         SPARE         -           71         SPACE         -           73         SPACE         -           75         SPACE         -           79         SPACE         -           81         SPACE         -           79         SPACE         -           83         SPACE         -	( SECTION II)         225A         ON       BREAKER       CIRCUIT WIRING         D       SIZE       GND       C         3       15       3       12       12       3/4         -       -       -       -       -       -       -         3       15       3       12       12       3/4         -       -       -       -       -       -       -         3       15       -       -       -       -       -         -       -       -       -       -       -       -       -         3       30       -       -       100% RA         2       CKT       DESCRIPTION         4       44       FAN-5         46       -       48         50       SPARE         52       -         54       -         56       SPARE         58       -         60       -         62       SPACE         64       SPACE         68       SPACE         70       SPACE         71       SPACE         72       SPACE         73       SPACE         74       SPACE         80       SPACE         81       SPACE         82       SPACE         84       SPACE         84       SPACE         KVA PER PHASE:         100% RA         NG       C         CKT       DESCRIPTION         3/4       2         10       10         3/4       4         3/4       10         14       CHEMICAL SHOT         16       ATC PANEL         3/4       18	MOUNTING: SURFACE LOCATION: MECHANICAL RM         ATED NEUTRAL BUS       42K A         BREAKER       CIRCUIT WIRING       C         P       AMPS       NO       SIZE       GND       C         3       15       3       12       12       3/4       C         -       -       -       -       -       -       C         3       15       3       12       12       3/4       C         -       -       -       -       -       -       -         3       15       -       -       -       -       -         -       -       -       -       -       -       -         3       30       -       -       -       -       -         1       20       -       -       -       -       -         1       20       -       -       -       -       -       -         1       20       -       -       -       -       -       -       -       -       -       -       -       -       -       -       -       -       -       -       -       - <td>PANEL MP (ALT 1)         ( SECTION II)         MOUNT           COLTAGE: 480/277, 3PH, 4W         225A         100% RATED NEUTE           CONN         CKT         DESCRIPTION         P AMES NO         SIZE         GND         C           CONN         CKT         DESCRIPTION         P AMES NO         SIZE         GND         C         CKT         DESCRIPTION         P AMES NO           0.6         43         FAN4         3         15         3         12         12         3/4         44         FAN-5         3           0.6         45         -         -         -         -         -         44         -         -         -           0.6         47         -         -         -         -         -         44         -         -         -</td> <td>TING: SURFACE         TING: MECHANICAL RM         RAL BUS       421         KER       CIRCUIT WIRING         MPS       NO       SIZE       GND       C         15       3       12       12       3/4         -       -       -       -       -         15       3       12       12       3/4         -       -       -       -       -         15       -       -       -       -         30       -       -       -       -         30       -       -       -       -         20       -       -       -       -         20       -       -       -       -         20       -       -       -       -         20       -       -       -       -         20       -       -       -       -         20       -       -       -       -         20       -       -       -       -         112       B       1.2       C       1.2         34       35.356&lt;</td>	PANEL MP (ALT 1)         ( SECTION II)         MOUNT           COLTAGE: 480/277, 3PH, 4W         225A         100% RATED NEUTE           CONN         CKT         DESCRIPTION         P AMES NO         SIZE         GND         C           CONN         CKT         DESCRIPTION         P AMES NO         SIZE         GND         C         CKT         DESCRIPTION         P AMES NO           0.6         43         FAN4         3         15         3         12         12         3/4         44         FAN-5         3           0.6         45         -         -         -         -         -         44         -         -         -           0.6         47         -         -         -         -         -         44         -         -         TING: SURFACE         TING: MECHANICAL RM         RAL BUS       421         KER       CIRCUIT WIRING         MPS       NO       SIZE       GND       C         15       3       12       12       3/4         -       -       -       -       -         15       3       12       12       3/4         -       -       -       -       -         15       -       -       -       -         30       -       -       -       -         30       -       -       -       -         20       -       -       -       -         20       -       -       -       -         20       -       -       -       -         20       -       -       -       -         20       -       -       -       -         20       -       -       -       -         20       -       -       -       -         112       B       1.2       C       1.2         34       35.356<
PANEL MP           OLTAGE: 480/277, 3PH, 4W           25 AMPERE BUS           CKT         DESCRIPTI           0.6         43         FAN-4           0.6         43         FAN-4           0.6         43         FAN-4           0.6         45         -           0.6         47         -           49         SPARE         -           51         -         -           53         -         -           55         SPARE         -           57         -         -           59         -         -           61         SPARE         -           63         SPARE         -           65         SPARE         -           67         SPARE         -           73         SPACE         -           75         SPACE         -           79         SPACE         -           79         SPACE         -           70         SPACE         -           70         SPACE         -           70         SPACE         -           70.1         CONN	(SECTION II)           BREAKER         CIRCUIT WIRING           ON         P         AMPS         NO         SIZE         GND         C           3         15         3         12         12         3/4           -         -         -         -         -         -         -           3         15         3         12         12         3/4           -         -         -         -         -         -         -           3         15         -         -         -         -         -           -         -         -         -         -         -         -         -           3         30         -         -         -         -         -         -         -           1         20         -         -         100% R4         CKT       DESCRIPTION         4       44       FAN-5         46       -       -         48       -       -         50       SPARE       -         51       -       -         52       -       -         53       -       -         60       -       -         60       -       -         61       SPARE       -         62       SPACE       -         64       SPACE       -         68       SPACE       -         70       SPACE       -         71       SPACE       -         72       SPACE       -         73       SPACE       -         80       SPACE       -         81       SPACE       -         82       SPACE       -         84       SPACE       -         100% R4       -	MOUNTING: SURFACE LOCATION: MECHANICAL RM         ATED NEUTRAL BUS       42K A         BREAKER       CIRCUIT WIRING       C         9       AMPS       NO       SIZE       GND       C         3       15       3       12       12       3/4       Image: state stat	C         PANEL MP (ALT 1)         (SECTION II)         MOUNT           VIOLTAGE: 480/277, 3PH, 4W         225A         100% RATEO NEUTE         LOCAT           Z23A AMPERE BUS         225A         100% RATEO NEUTE         LOCAT           NA         0.6         43         FAN4         3         15         3         12         12         34         44         FAN5         3         1           0.6         43         FAN4         3         15         3         12         12         34         44         FAN5         3         1           0.6         45         -         -         -         -         46         -         -         -         -         48         -         -         -         -         48         -         -         TING: SURFACE         TING: MECHANICAL RM         RAL BUS       424         KER       CIRCUIT WIRING         MPS       NO       SIZE       GND       C         15       3       12       12       3/4         -       -       -       -       -         15       3       12       12       3/4         -       -       -       -       -         15       -       -       -       -         30       -       -       -       -         30       -       -       -       -         20       -       -       -       -         20       -       -       -       -         20       -       -       -       -         20       -       -       -       -         20       -       -       -       -         20       -       -       -       -         20       -       -       -       -         112       B       1.2       C       1.2         34       35.356<
PANEL MP           OLTAGE: 480/277, 3PH, 4W           25 AMPERE BUS           CKT         DESCRIPTI           0.6         43         FAN-4           0.6         45         -           0.6         47         -           49         SPARE         -           51         -         -           53         -         -           55         SPARE         -           57         -         -           59         -         61           63         SPARE         -           63         SPARE         -           63         SPARE         -           63         SPARE         -           64         SPARE         -           71         SPACE         -           73         SPACE         -           79         SPACE         -           79         SPACE         -           79         SPACE         -           70         SPACE         -           70         SPACE         -           70         SPACE         -           70         SPACE	(SECTION II)           DN         BREAKER         CIRCUIT WIRING           DN         SIZE         GND         C           3         15         3         12         12         3/4           -         -         -         -         -         -         -         -           3         15         -         -         -         -         -         -           3         30         -         -         -         -         -         -         -           1         20         -         -         100% R/         2       CKT       DESCRIPTION         4       44       FAN-5       46       -         4       44       FAN-5       46       -         48       -       50       SPARE       52       -         51       52       -       -       60       -       -         58       -       60       -       -       60       -       -         60       -       62       SPACE       66       SPACE       -       -       MOUNTING: SURFACE LOCATION: MECHANICAL RM         ATED NEUTRAL BUS       42K A         BREAKER       CIRCUIT WIRING       C         9       AMPS       NO       SIZE       GND       C         3       15       3       12       12       3/4       C         -       -       -       -       -       -       -       C         3       15       3       12       12       3/4       C       C         -       -       </td <td>ANEL MP (ALT 1)         (SECTION III)         MOUNT           VOLTAGE: 480277, 3PH, 4W         LOCAT         LOCAT           Z25A         100% RATEO NEUTS         LOCAT           CONN         CKT         DESCRIPTION         P (AMIPS NO) SIZE         GND         C           CKN         CKT         DESCRIPTION         P (AMIPS NO) SIZE         GND         C         C           0.6         43         FAN4         3         15         3         12         12         34         44         FANS         3           0.6         47         -         -         -         -         48         -         -         -</td> <td>TING: SURFACE         TING: MECHANICAL RM         RAL BUS       424         KER       CIRCUIT WIRING         MPS       NO       SIZE       GND       C         15       3       12       12       3/4         -       -       -       -       -         15       3       12       12       3/4         -       -       -       -       -         15       -       -       -       -         30       -       -       -       -         30       -       -       -       -         20       -       -       -       -         20       -       -       -       -         20       -       -       -       -         20       -       -       -       -         20       -       -       -       -         20       -       -       -       -         20       -       -       -       -         312       B       1.2       C       1.2         340       -</td>	ANEL MP (ALT 1)         (SECTION III)         MOUNT           VOLTAGE: 480277, 3PH, 4W         LOCAT         LOCAT           Z25A         100% RATEO NEUTS         LOCAT           CONN         CKT         DESCRIPTION         P (AMIPS NO) SIZE         GND         C           CKN         CKT         DESCRIPTION         P (AMIPS NO) SIZE         GND         C         C           0.6         43         FAN4         3         15         3         12         12         34         44         FANS         3           0.6         47         -         -         -         -         48         -         -         TING: SURFACE         TING: MECHANICAL RM         RAL BUS       424         KER       CIRCUIT WIRING         MPS       NO       SIZE       GND       C         15       3       12       12       3/4         -       -       -       -       -         15       3       12       12       3/4         -       -       -       -       -         15       -       -       -       -         30       -       -       -       -         30       -       -       -       -         20       -       -       -       -         20       -       -       -       -         20       -       -       -       -         20       -       -       -       -         20       -       -       -       -         20       -       -       -       -         20       -       -       -       -         312       B       1.2       C       1.2         340       -
PANEL MP           YOLTAGE: 480/277, 3PH, 4W           25 AMPERE BUS           ZONN         CKT         DESCRIPTI           0.6         43         FAN-4           0.6         45         -           0.6         47         -           49         SPARE         -           51         -         -           53         -         -           57         -         -           59         -         -           61         SPARE         -           63         SPARE         -           65         SPARE         -           67         SPARE         -           69         SPARE         -           71         SPACE         -           73         SPACE         -           79         SPACE         -           79         SPACE         -           83         SPACE         -           150         AMPERE BUS         -           CONN         CKT         DESC           0.2         1         FAN-1           0.4         3         UH-1 AND UI	Image: constraint of the second sec	100% R/       CKT     DESCRIPTION       44     FAN-5       46     -       48     -       50     SPARE       52     -       54     -       56     SPARE       58     -       60     -       62     SPACE       63     SPACE       64     SPACE       65     SPACE       66     SPACE       70     SPACE       71     SPACE       72     SPACE       73     SPACE       74     SPACE       75     SPACE       76     SPACE       80     SPACE       80     SPACE       81     SPACE       82     SPACE       84     SPACE       NOW RATE       VIO0% RATE       93/4     2       100% RATE     SPACE       10     SPACE <td>MOUNTING: SURFACE LOCATION: MECHANICAL RM         ATED NEUTRAL BUS       42K A         BREAKER       CIRCUIT WIRING       C         9       AMPS       NO       SIZE       GND       C         3       15       3       12       12       3/4       C         -       -       -       -       -       -       -       C         3       15       3       12       12       3/4       C       C         -       -       -<!--</td--><td>PANEL MP (ALT 1)         ( SECTION II)         MOUNT           VOLTAGE 490277. 3PH, 4W         225A         160% RATED NEUTF           256 AMPERE BUS         225A         160% RATED NEUTF           0.0         43         FAN4         3         15         3         12         12         3/4         44         FAN5         0.0         CKT         DESCRIPTION         P REAKER         CIRCUT WINING         CKT         DESCRIPTION         P REAKER         0.0         1.0         1.0         1.0<!--</td--><td>TING: SURFACE         TING: MECHANICAL RM         RAL BUS       424         KER       CIRCUT WIRING       MPS         MPS       NO       SIZE       GND       C         15       3       12       12       3/4         -       -       -       -       -         15       3       12       12       3/4         -       -       -       -       -         15       -       -       -       -         16       -       -       -       -         30       -       -       -       -         10       -       -       -       -         20       -       -       -       -         20       -       -       -       -         20       -       -       -       -         20       -       -       -       -         20       -       -       -       -         20       -       -       -       -         20       -       -       -       -       -         112</td></td></td>	MOUNTING: SURFACE LOCATION: MECHANICAL RM         ATED NEUTRAL BUS       42K A         BREAKER       CIRCUIT WIRING       C         9       AMPS       NO       SIZE       GND       C         3       15       3       12       12       3/4       C         -       -       -       -       -       -       -       C         3       15       3       12       12       3/4       C       C         -       -       </td <td>PANEL MP (ALT 1)         ( SECTION II)         MOUNT           VOLTAGE 490277. 3PH, 4W         225A         160% RATED NEUTF           256 AMPERE BUS         225A         160% RATED NEUTF           0.0         43         FAN4         3         15         3         12         12         3/4         44         FAN5         0.0         CKT         DESCRIPTION         P REAKER         CIRCUT WINING         CKT         DESCRIPTION         P REAKER         0.0         1.0         1.0         1.0<!--</td--><td>TING: SURFACE         TING: MECHANICAL RM         RAL BUS       424         KER       CIRCUT WIRING       MPS         MPS       NO       SIZE       GND       C         15       3       12       12       3/4         -       -       -       -       -         15       3       12       12       3/4         -       -       -       -       -         15       -       -       -       -         16       -       -       -       -         30       -       -       -       -         10       -       -       -       -         20       -       -       -       -         20       -       -       -       -         20       -       -       -       -         20       -       -       -       -         20       -       -       -       -         20       -       -       -       -         20       -       -       -       -       -         112</td></td>	PANEL MP (ALT 1)         ( SECTION II)         MOUNT           VOLTAGE 490277. 3PH, 4W         225A         160% RATED NEUTF           256 AMPERE BUS         225A         160% RATED NEUTF           0.0         43         FAN4         3         15         3         12         12         3/4         44         FAN5         0.0         CKT         DESCRIPTION         P REAKER         CIRCUT WINING         CKT         DESCRIPTION         P REAKER         0.0         1.0         1.0         </td <td>TING: SURFACE         TING: MECHANICAL RM         RAL BUS       424         KER       CIRCUT WIRING       MPS         MPS       NO       SIZE       GND       C         15       3       12       12       3/4         -       -       -       -       -         15       3       12       12       3/4         -       -       -       -       -         15       -       -       -       -         16       -       -       -       -         30       -       -       -       -         10       -       -       -       -         20       -       -       -       -         20       -       -       -       -         20       -       -       -       -         20       -       -       -       -         20       -       -       -       -         20       -       -       -       -         20       -       -       -       -       -         112</td>	TING: SURFACE         TING: MECHANICAL RM         RAL BUS       424         KER       CIRCUT WIRING       MPS         MPS       NO       SIZE       GND       C         15       3       12       12       3/4         -       -       -       -       -         15       3       12       12       3/4         -       -       -       -       -         15       -       -       -       -         16       -       -       -       -         30       -       -       -       -         10       -       -       -       -         20       -       -       -       -         20       -       -       -       -         20       -       -       -       -         20       -       -       -       -         20       -       -       -       -         20       -       -       -       -         20       -       -       -       -       -         112
PANEL MP           YOLTAGE: 480/277, 3PH, 4W           25 AMPERE BUS           CKT         DESCRIPTI           0.6         43         FAN-4           0.6         45         -           0.6         47         -           49         SPARE         -           51         -         -           53         -         -           55         SPARE         -           57         -         -           59         -         -           61         SPARE         -           63         SPARE         -           65         SPARE         -           67         SPARE         -           68         SPARE         -           71         SPACE         -           73         SPACE         -           79         SPACE         -           79         SPACE         -           79         SPACE         -           70         SPACE         -           70         SPACE         -           71         SPACE         -           70         SPACE	Image: constraint of the second of	100% R/           CKT         DESCRIPTION           4         44         FAN-5           46         -           48         -           50         SPARE           52         -           54         -           56         SPARE           58         -           60         -           62         SPACE           63         SPACE           64         SPACE           65         SPACE           68         SPACE           68         SPACE           70         SPACE           71         SPACE           80         SPACE           80         SPACE           81         SPACE           82         SPACE           83         SPACE           84         SPACE	MOUNTING: SURFACE LOCATION: MECHANICAL RM         ATED NEUTRAL BUS       42K A         BREAKER       CIRCUIT WIRING       C         9       AMPS       NO       SIZE       GND       C         3       15       3       12       12       3/4       C         -       -       -       -       -       -       -       C         3       15       3       12       12       3/4       C       C         -       -       </td <td>Image: Construction of the second s</td> <td>TING: SURFACE         TING: MECHANICAL RM         RAL BUS       424         <math>\overline{A2P}</math>         KER       CIRCUT WIRING         MPS       NO       SIZE       GND       C         15       3       12       12       3/4         -       -       -       -       -         15       3       12       12       3/4         -       -       -       -       -         15       -       -       -       -         16       -       -       -       -         30       -       -       -       -         10       -       -       -       -         20       -       -       -       -         20       -       -       -       -         20       -       -       -       -         20       -       -       -       -         20       -       -       -       -         20       -       -       -       -         112       B       1.2       C       1.2</td>	Image: Construction of the second s	TING: SURFACE         TING: MECHANICAL RM         RAL BUS       424 $\overline{A2P}$ KER       CIRCUT WIRING         MPS       NO       SIZE       GND       C         15       3       12       12       3/4         -       -       -       -       -         15       3       12       12       3/4         -       -       -       -       -         15       -       -       -       -         16       -       -       -       -         30       -       -       -       -         10       -       -       -       -         20       -       -       -       -         20       -       -       -       -         20       -       -       -       -         20       -       -       -       -         20       -       -       -       -         20       -       -       -       -         112       B       1.2       C       1.2
PANEL MP           YOLTAGE: 480/277, 3PH, 4W           25 AMPERE BUS           CKT         DESCRIPTI           0.6         43         FAN-4           0.6         45         -           0.6         47         -           49         SPARE         -           51         -         -           53         -         -           55         SPARE         -           57         -         -           59         -         -           61         SPARE         -           63         SPARE         -           63         SPARE         -           64         SPARE         -           65         SPARE         -           71         SPACE         -           73         SPACE         -           75         SPACE         -           77         SPACE         -           79         SPACE         -           79         SPACE         -           79         SPACE         -           10         1         FAN-1           0.4         3	(SECTION II)           BREAKER         CIRCUIT WIRING           0         3         15         3         12         12         3/4           -         -         -         -         -         -         -         -           3         15         3         12         12         3/4           -         -         100% R/       CKT     DESCRIPTION       4     44     FAN-5       46     -       48     -       50     SPARE       52     -       54     -       56     SPARE       58     -       60     -       62     SPACE       63     SPACE       64     SPACE       65     SPACE       66     SPACE       70     SPACE       71     SPACE       72     SPACE       80     SPACE       80     SPACE       81     SPACE       82     SPACE       84     SPACE       84     SPACE       84     SPACE       84     SPACE       84     SPACE       84     SPACE       75     SPACE       76     SPACE       77     SPACE       84     SPACE       84     SPACE       84     SPACE       76     SPACE       77     SPACE       84     SPACE       77     SPACE       78     SPACE       84     SPACE	MOUNTING: SURFACE LOCATION: MECHANICAL RM         ATED NEUTRAL BUS       42K A         BREAKER       CIRCUIT WIRING       C         9       AMPS       NO       SIZE       GND       C         3       15       3       12       12       3/4       C         -       -       -       -       -       -       -       C         3       15       3       12       12       3/4       C       C         -       -       </td <td>ANDEL         MP (ALT 1)         (SECTION II)         MOUNT           VOLTAGE         640271, 3594, 4W         LCOCAT         LCOCAT         LCOCAT           VOLTAGE         640271, 3594, 4W         LCOCAT         LCOCAT         LCOCAT           0.6         43         FAN4         3         15         3         12         12         344         44         FAN5         3         1           0.6         43         FAN4         3         15         12         12         344         44         FAN5         3         1           0.6         44         FAN4         3         15         -         -         -         48         FARE         3         1         -         -         -         49         FARE         3         1         -         -         -         66         FARE         3         1         -         -         -         66         FARE         3         0         -         -         66         FARE         1         20         -         66         FARE         1         20         -         -         60         FARE         1         20         -         73         FARE         1</td> <td>TING: SURFACE         TING: MECHANICAL RM         RAL BUS       42K         KER       CIRCUIT WIRING         MPS       NO       SIZE       GND       C         15       3       12       12       3/4         -       -       -       -       -         15       3       12       12       3/4         -       -       -       -       -         15       -       -       -       -         30       0       -       -       -         20       -       -       -       -         20       0       0       0       0       0         20       0       0       0       0       0       0         20       0       0       0       0       0       0       0       0         20       0       0       0</td>	ANDEL         MP (ALT 1)         (SECTION II)         MOUNT           VOLTAGE         640271, 3594, 4W         LCOCAT         LCOCAT         LCOCAT           VOLTAGE         640271, 3594, 4W         LCOCAT         LCOCAT         LCOCAT           0.6         43         FAN4         3         15         3         12         12         344         44         FAN5         3         1           0.6         43         FAN4         3         15         12         12         344         44         FAN5         3         1           0.6         44         FAN4         3         15         -         -         -         48         FARE         3         1         -         -         -         49         FARE         3         1         -         -         -         66         FARE         3         1         -         -         -         66         FARE         3         0         -         -         66         FARE         1         20         -         66         FARE         1         20         -         -         60         FARE         1         20         -         73         FARE         1	TING: SURFACE         TING: MECHANICAL RM         RAL BUS       42K         KER       CIRCUIT WIRING         MPS       NO       SIZE       GND       C         15       3       12       12       3/4         -       -       -       -       -         15       3       12       12       3/4         -       -       -       -       -         15       -       -       -       -         30       0       -       -       -         20       -       -       -       -         20       0       0       0       0       0         20       0       0       0       0       0       0         20       0       0       0       0       0       0       0       0         20       0       0       
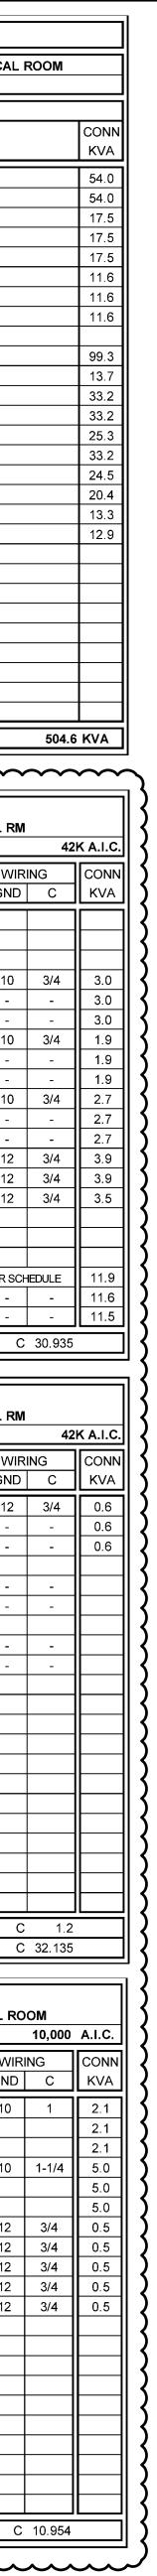

REVISIONS	DESCRIPTION	ADDENDUM NO. 1	ADDENDUM NO. 2	ADDENDUM NO. 3	ADDENDUM NO. 4
	NO. DATE	<u> </u>	2 3/14/24	3/20/24	<u></u> 4 3/27/24
	RES DISCLOSED	SIPE SHALL NOT BE	I WHOLE OR IN	SSOCIATES, INC.	
HIS DRAWING AND THE DESIGN AND	CONSTRUCTION FEATURES DISCLOSED	ARE PROPRIETARY TO GIPE ASSOCIATES. INC. AND SHAL	ALTERED OR REUSED IN WHOLE OR IN DAPT WITHOU IT THE EXDRESS WRITTEN	PERMISSION OF GIPE ASSOCIATES, INC.	Copyrignt © 2023
	CONSTR	ARE PR	ALTERE	PERMIS	Copyrign
tac Inc		ineers	.9 Brooke Drive te 2-5	Easton, Maryland 21601 Phone: 410.822.8688	Fax: 410.822.6306
Gine Accoriates 1		onsulting Engineers			
oup ا			1220 East Joppa Road Suite 223	Towson, MD. 21286 Phone: 410.832.2420	Fax: 410.832.2418
	WC	)# 2	2304	<b>_</b> 13	
PROJE MANAG			E١	1P	
DESIG	NER	0	EN		
DATE		Z/	/26/	202	
			COUNTY PUBLIC SCHOOLS - ABERDEEN MIDDLE SCHOOL	VTIONS	OYAL AVE, ABERDEEN, MARYLAND 21001.
	SCHEDULES		HARFORD COUNTY PUBLIC	HVAC SYSTEMIC RENOVATIONS	111 MT ROYAL AVE, ABER
	BID	SU	BMIS	SION	
			02		

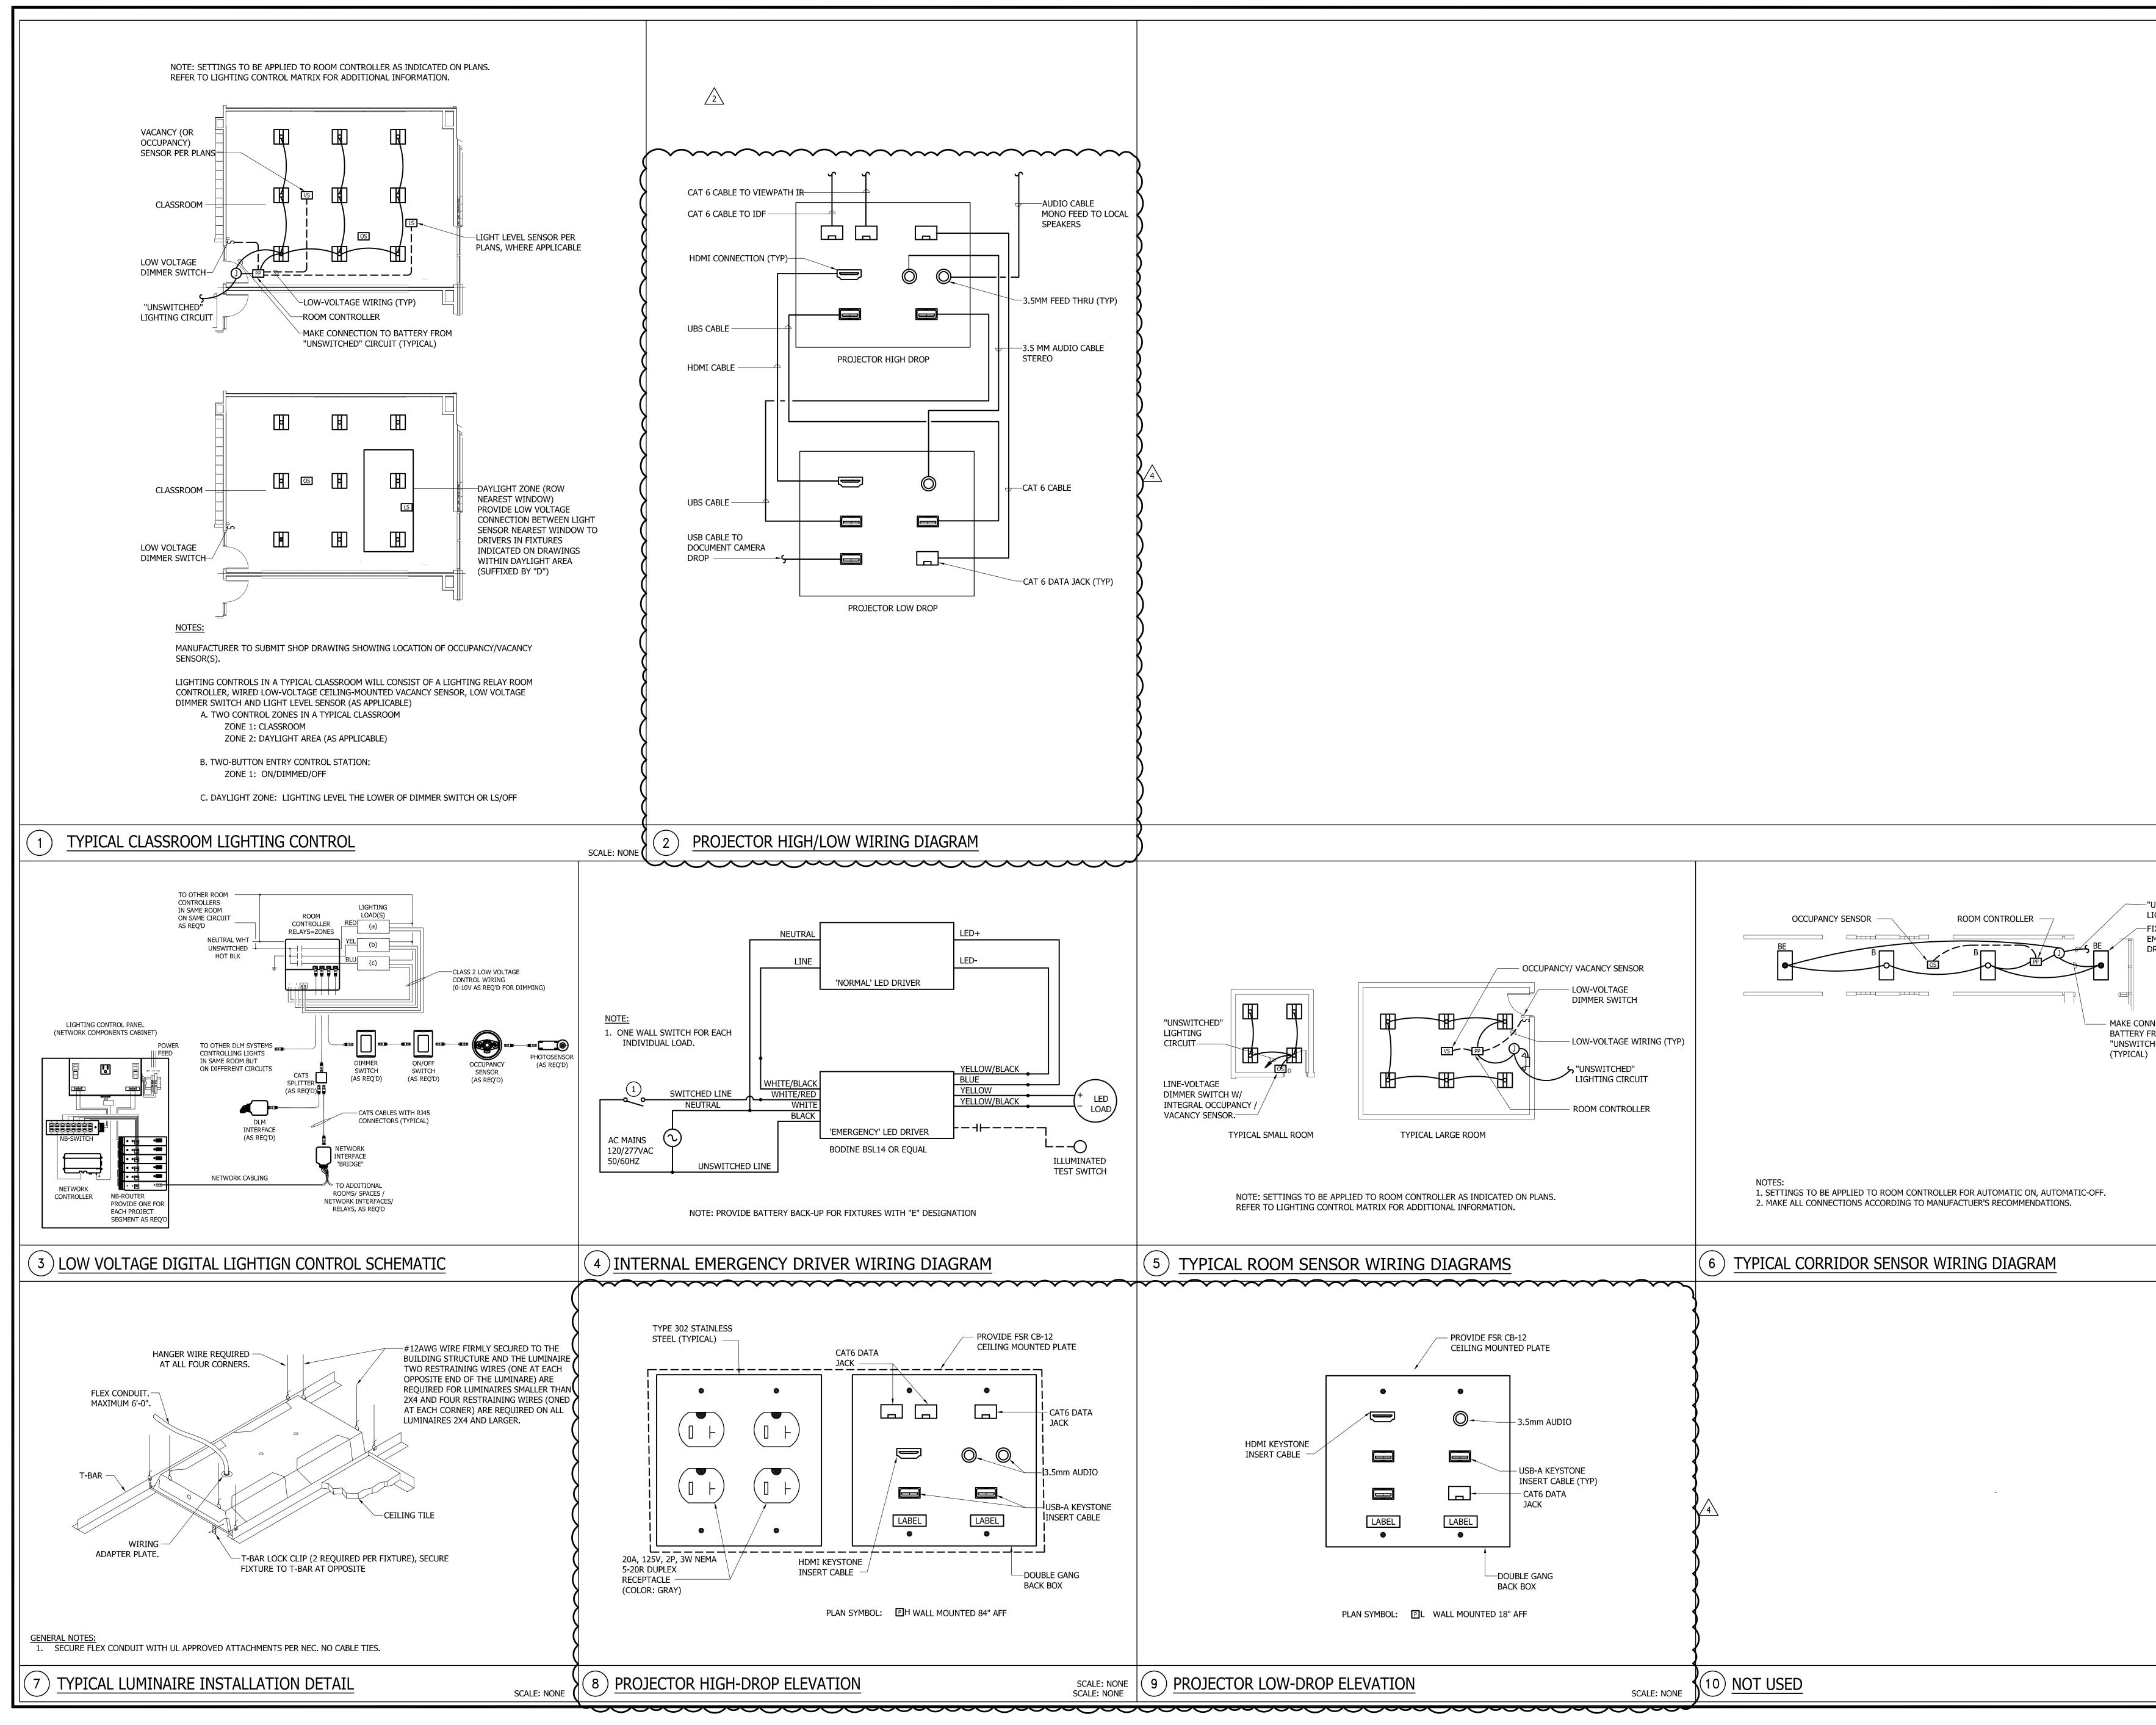

SCALE: 1/4" = 1'-0"			HED" CIRCUIT	SCALE: NONE UNSWITCHED" 277 VOLT IGHTING CIRCUIT ISTURES WITH MERGENCY BATTERY DRIVER			
E702 PSC-12.006	BID SUBMISSION	DETAILS Harford County Public Schools - Aberdeen Middle School Hvac Systemic Renovations 111 MT Royal Ave, Aberdeen, Maryland 21001.	PROJECT MANAGEREMPDESIGNEREMPDATE2/26/2024	MOM       State       S	THIS DRAWING AND THE DESIGN AND CONSTRUCTION FEATURES DISCLOSED ARE PROPRIETARY TO GIPE ASSOCIATES, INC. AND SHALL NOT BE ALTERED OR REUSED IN WHOLE OR IN PART WITHOUT THE EXPRESS WRITTEN PERMISSION OF GIPE ASSOCIATES, INC. Copyright © 2023	REVISIONS       NO.     DATE     REVISIONS       NO.     DATE     D       1     3/7/24     ADD       2     3/14/24     ADD       3/20/24     3/20/24     ADD       1     3/27/24     ADD	IONS DESCRIPTION ADDENDUM NO. 1 ADDENDUM NO. 2 ADDENDUM NO. 3 ADDENDUM NO. 4